C.S. FILE 52/119
M 23-58

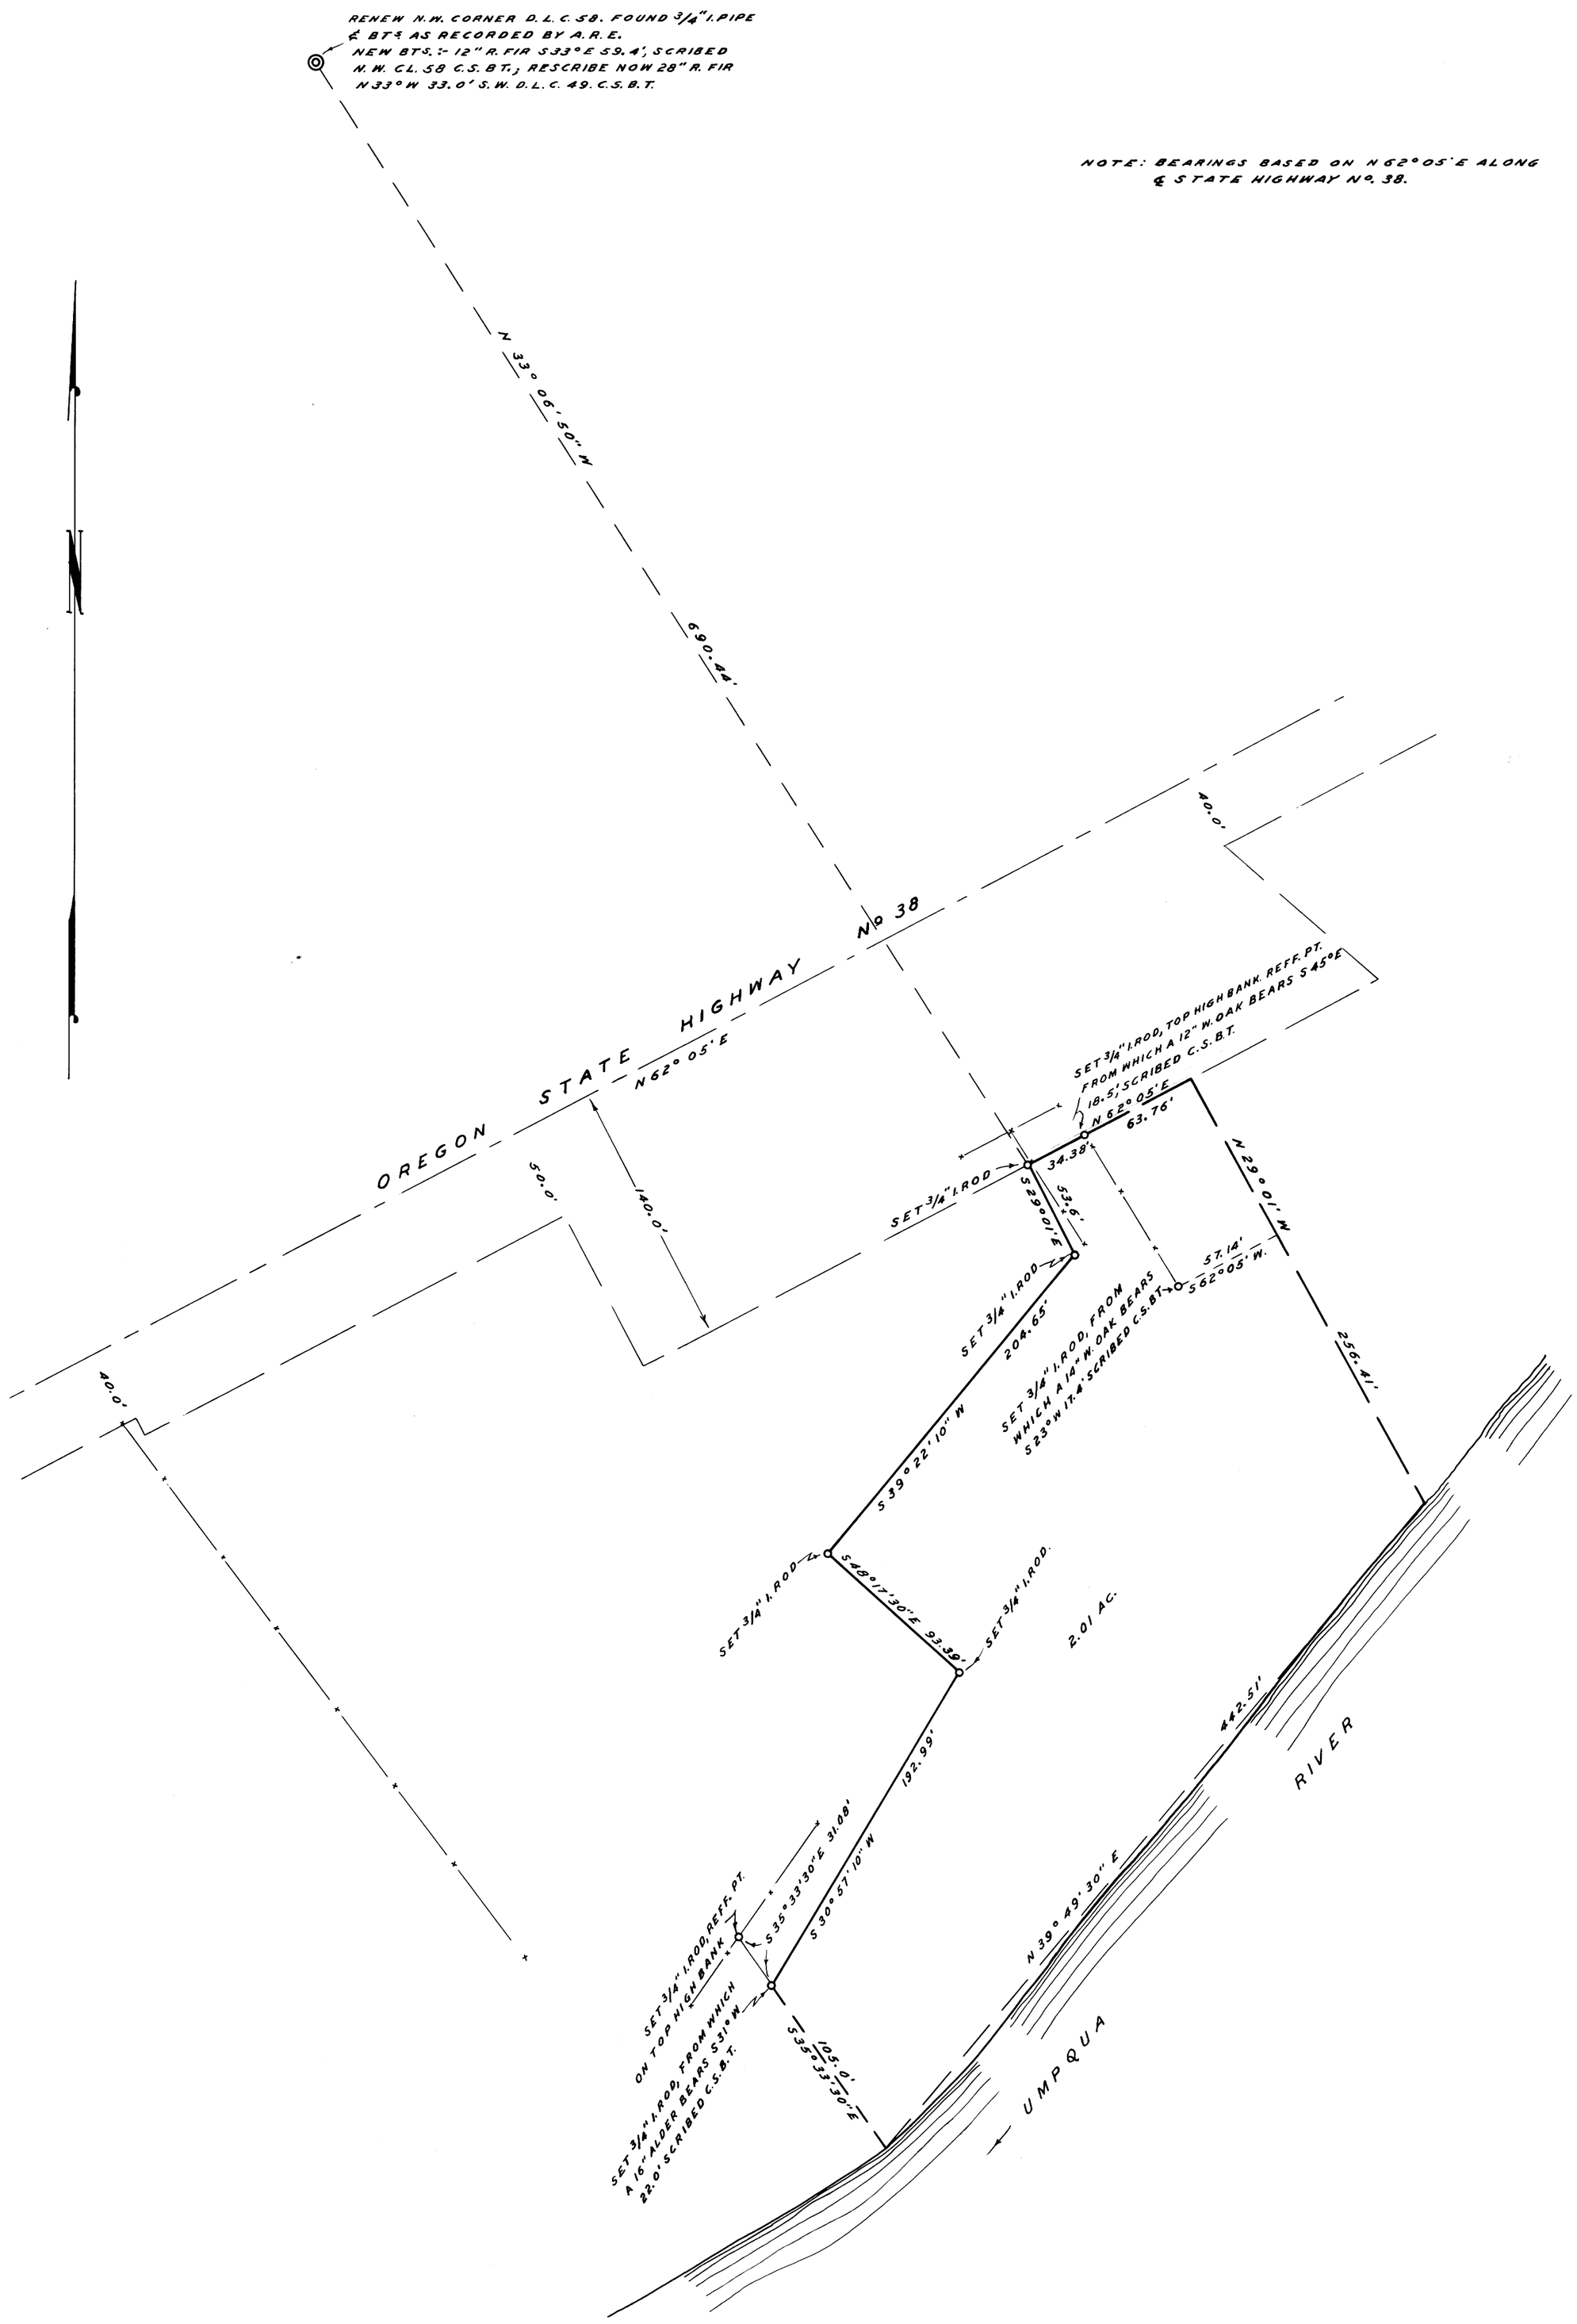

COUNTY SURVEYOR'S OFFICE
DOUGLAS COUNTY OREGON

SURVEY FOR DEED DESCRIPTION,
SECTION 18, T22S., R.8 W., W.M.

FRED M. DARBY — COUNTY SURVEYOR
SURVEYED MAY 4, 1962 — BY
JAMES W. BYRON - DEPUTY — SCALE 1" = 60'
SURVEYED FOR STATE FISH AND GAME COMM.

COUNTY SURVEYORS FILE DATA
DO NOT REMOVE FROM OFFICE

James W. Byron

C.S. FILE 52/119
M 23-58