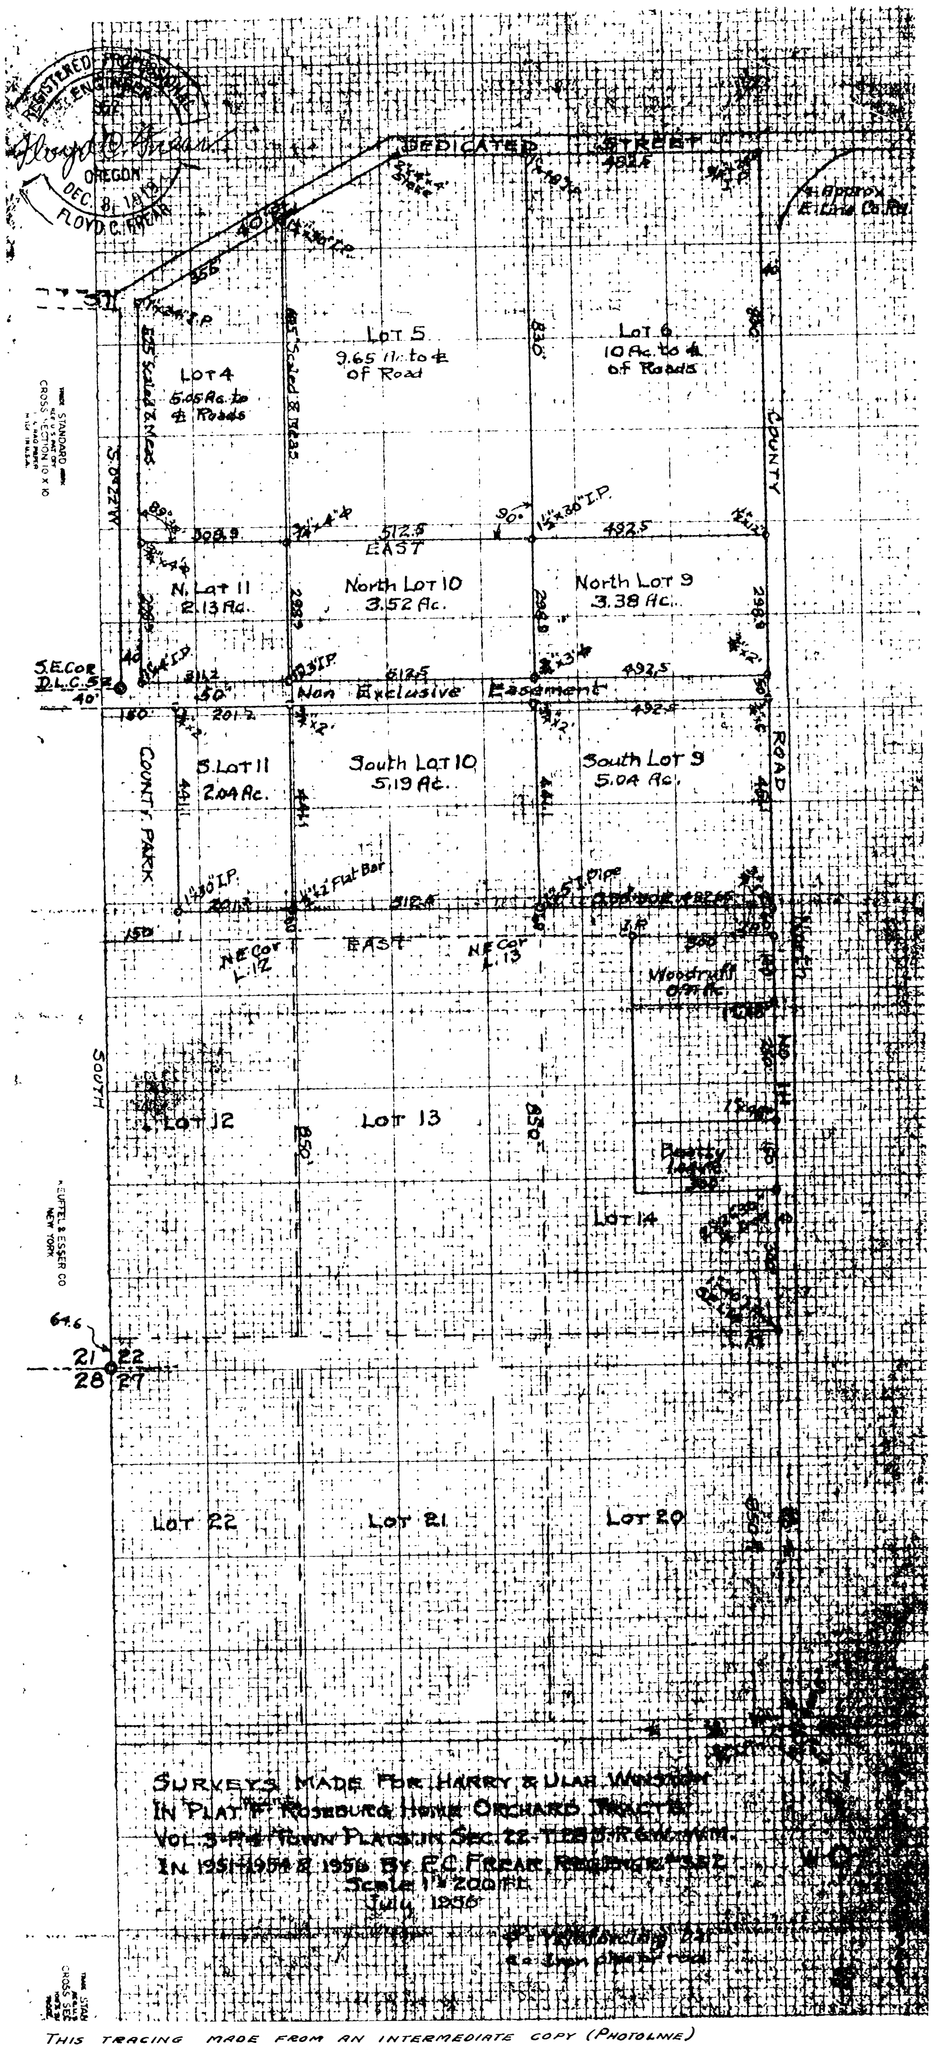

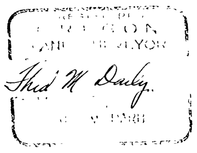

THIS TRACING MADE FROM AN INTERMEDIATE COPY (PHOTOLINE)
OF A PRINT FILED IN THIS OFFICE

FRED M. DARBY
COUNTY SURVEYOR

C.S. FILE 42/154
MAP FILE M23/66