M 23-72

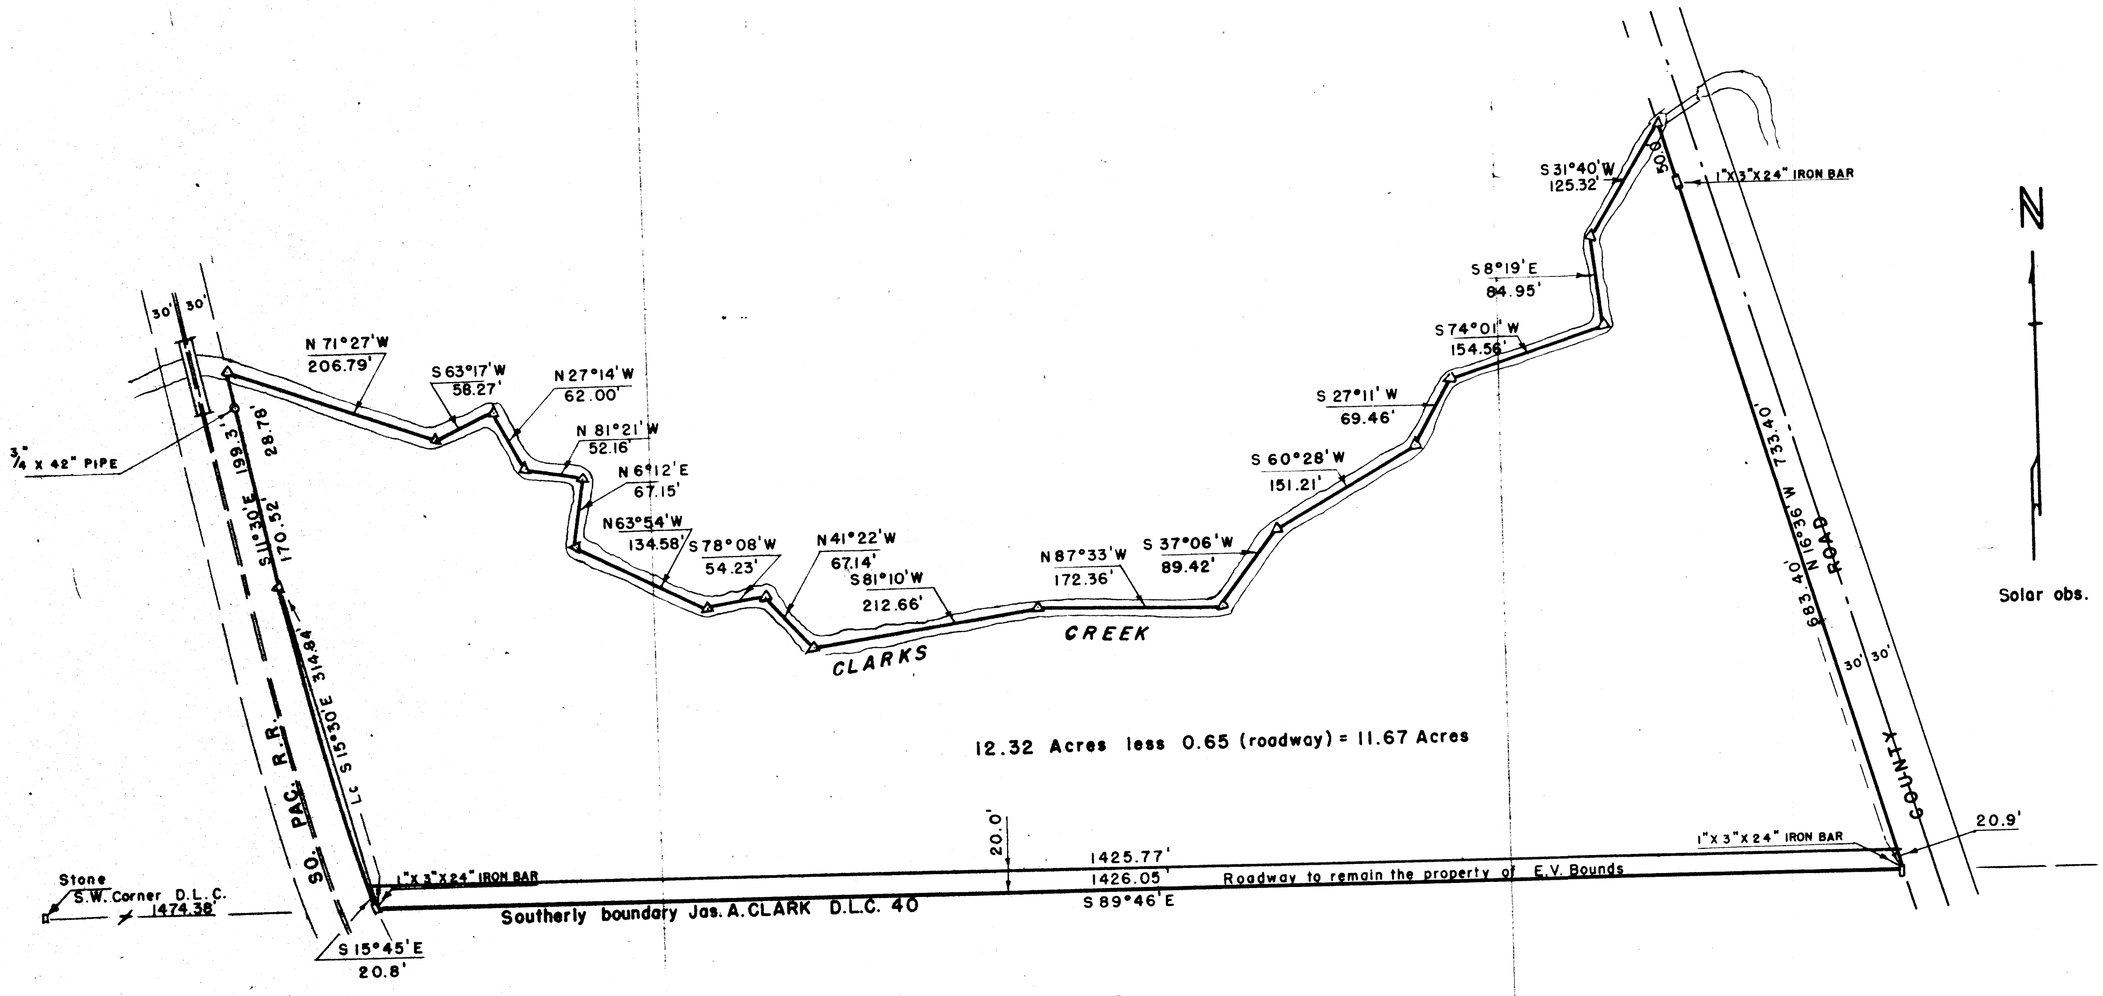

PART OF

E.V. BOUNDS PROPERTY

IN JAMES A. CLARK D.L.C. 40-T29S-R6W-W.M.-DOUGLAS COUNTY, OREGON.

DEC 1950

SCALE 1"=100'

COUNTY SURVEYORS FILE DATA
DO NOT REMOVE FROM OFFICE

C.S. FILE 40/316
MAP FILE M23/72

MAP FILE M 23 - 72