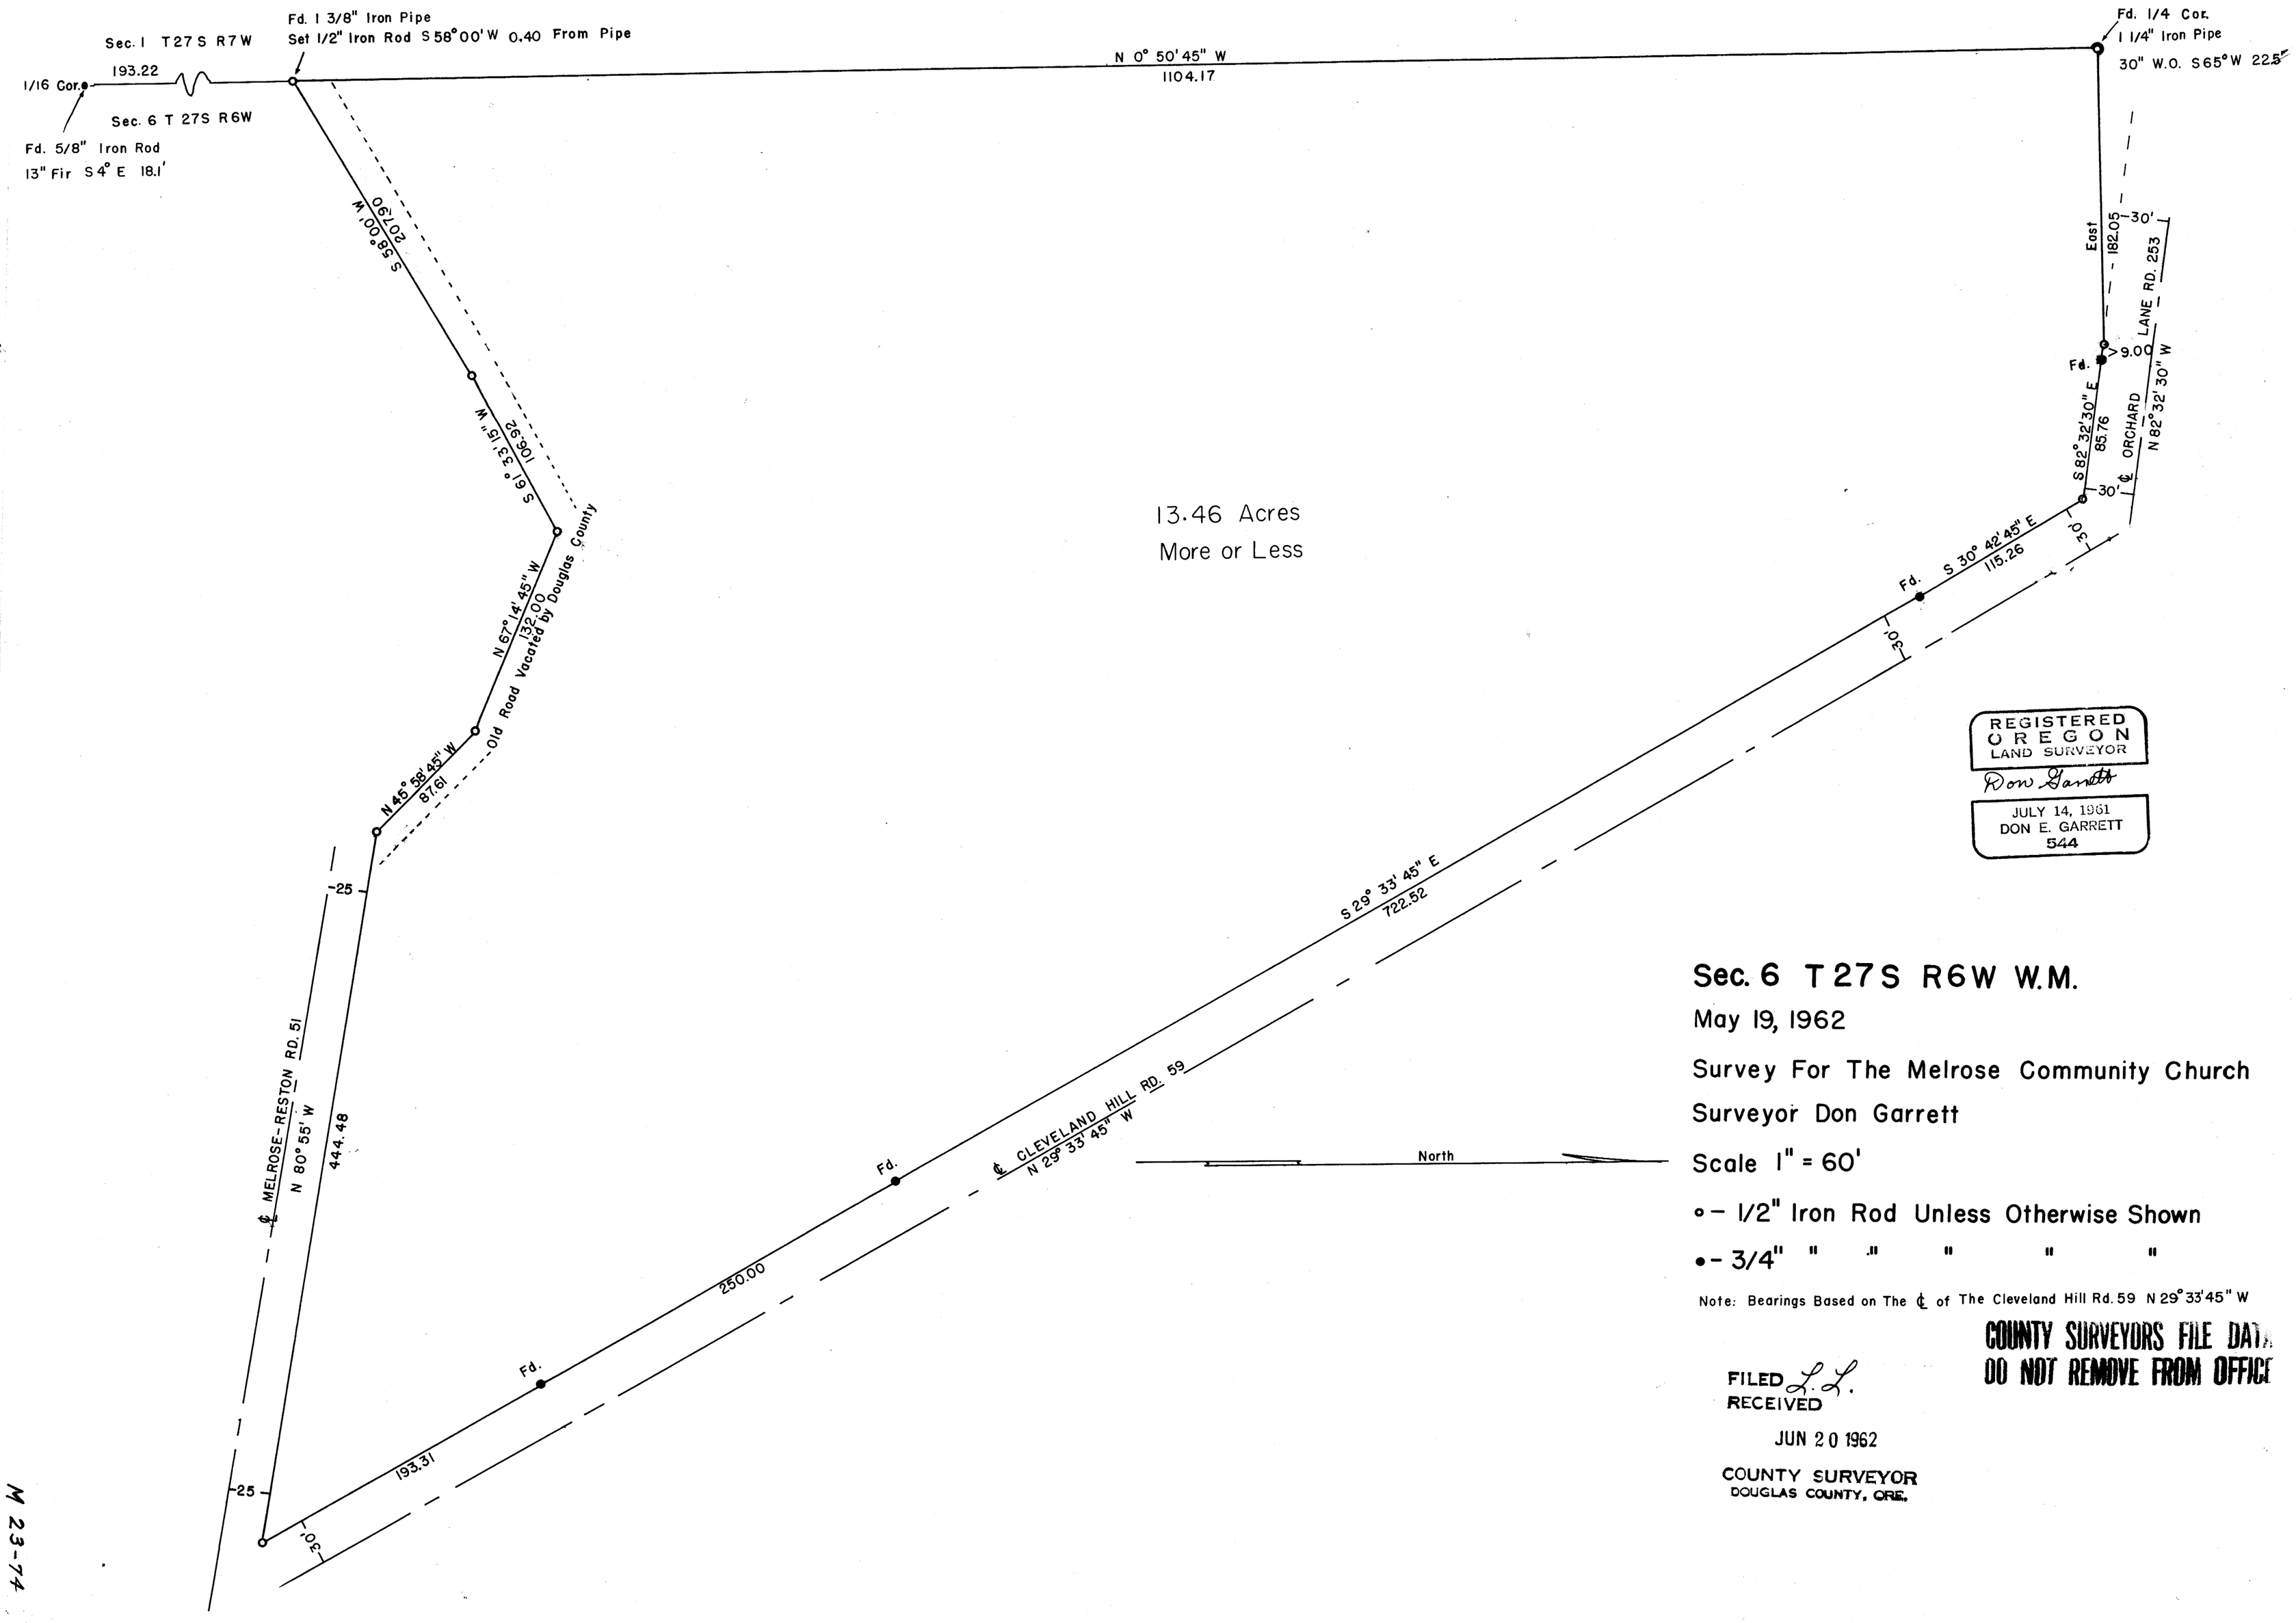

REGISTERED
OREGON
LAND SURVEYOR
Don Garrett
JULY 14, 1961
DON E. GARRETT
544

Sec. 6 T 27S R6W W.M.

May 19, 1962

Survey For The Melrose Community Church

Surveyor Don Garrett

Scale 1" = 60'

∘ – 1/2" Iron Rod Unless Otherwise Shown

• – 3/4" " " " " "

Note: Bearings Based on The ℄ of The Cleveland Hill Rd. 59 N 29°33'45" W

COUNTY SURVEYORS FILE DATA
DO NOT REMOVE FROM OFFICE

FILED L.L.
RECEIVED
JUN 20 1962
COUNTY SURVEYOR
DOUGLAS COUNTY, ORE.

MAP FILE M 23-74

M 23-74