MAP FILE M24-15

COUNTY SURVEYORS FILE DATA
DO NOT REMOVE FROM OFFICE

SURVEY FOR DANIEL HALFERTY

IN FIRST ADDITION TO WEST SLOPES IN D.L.C. 53, T27S, R6W, W.M.

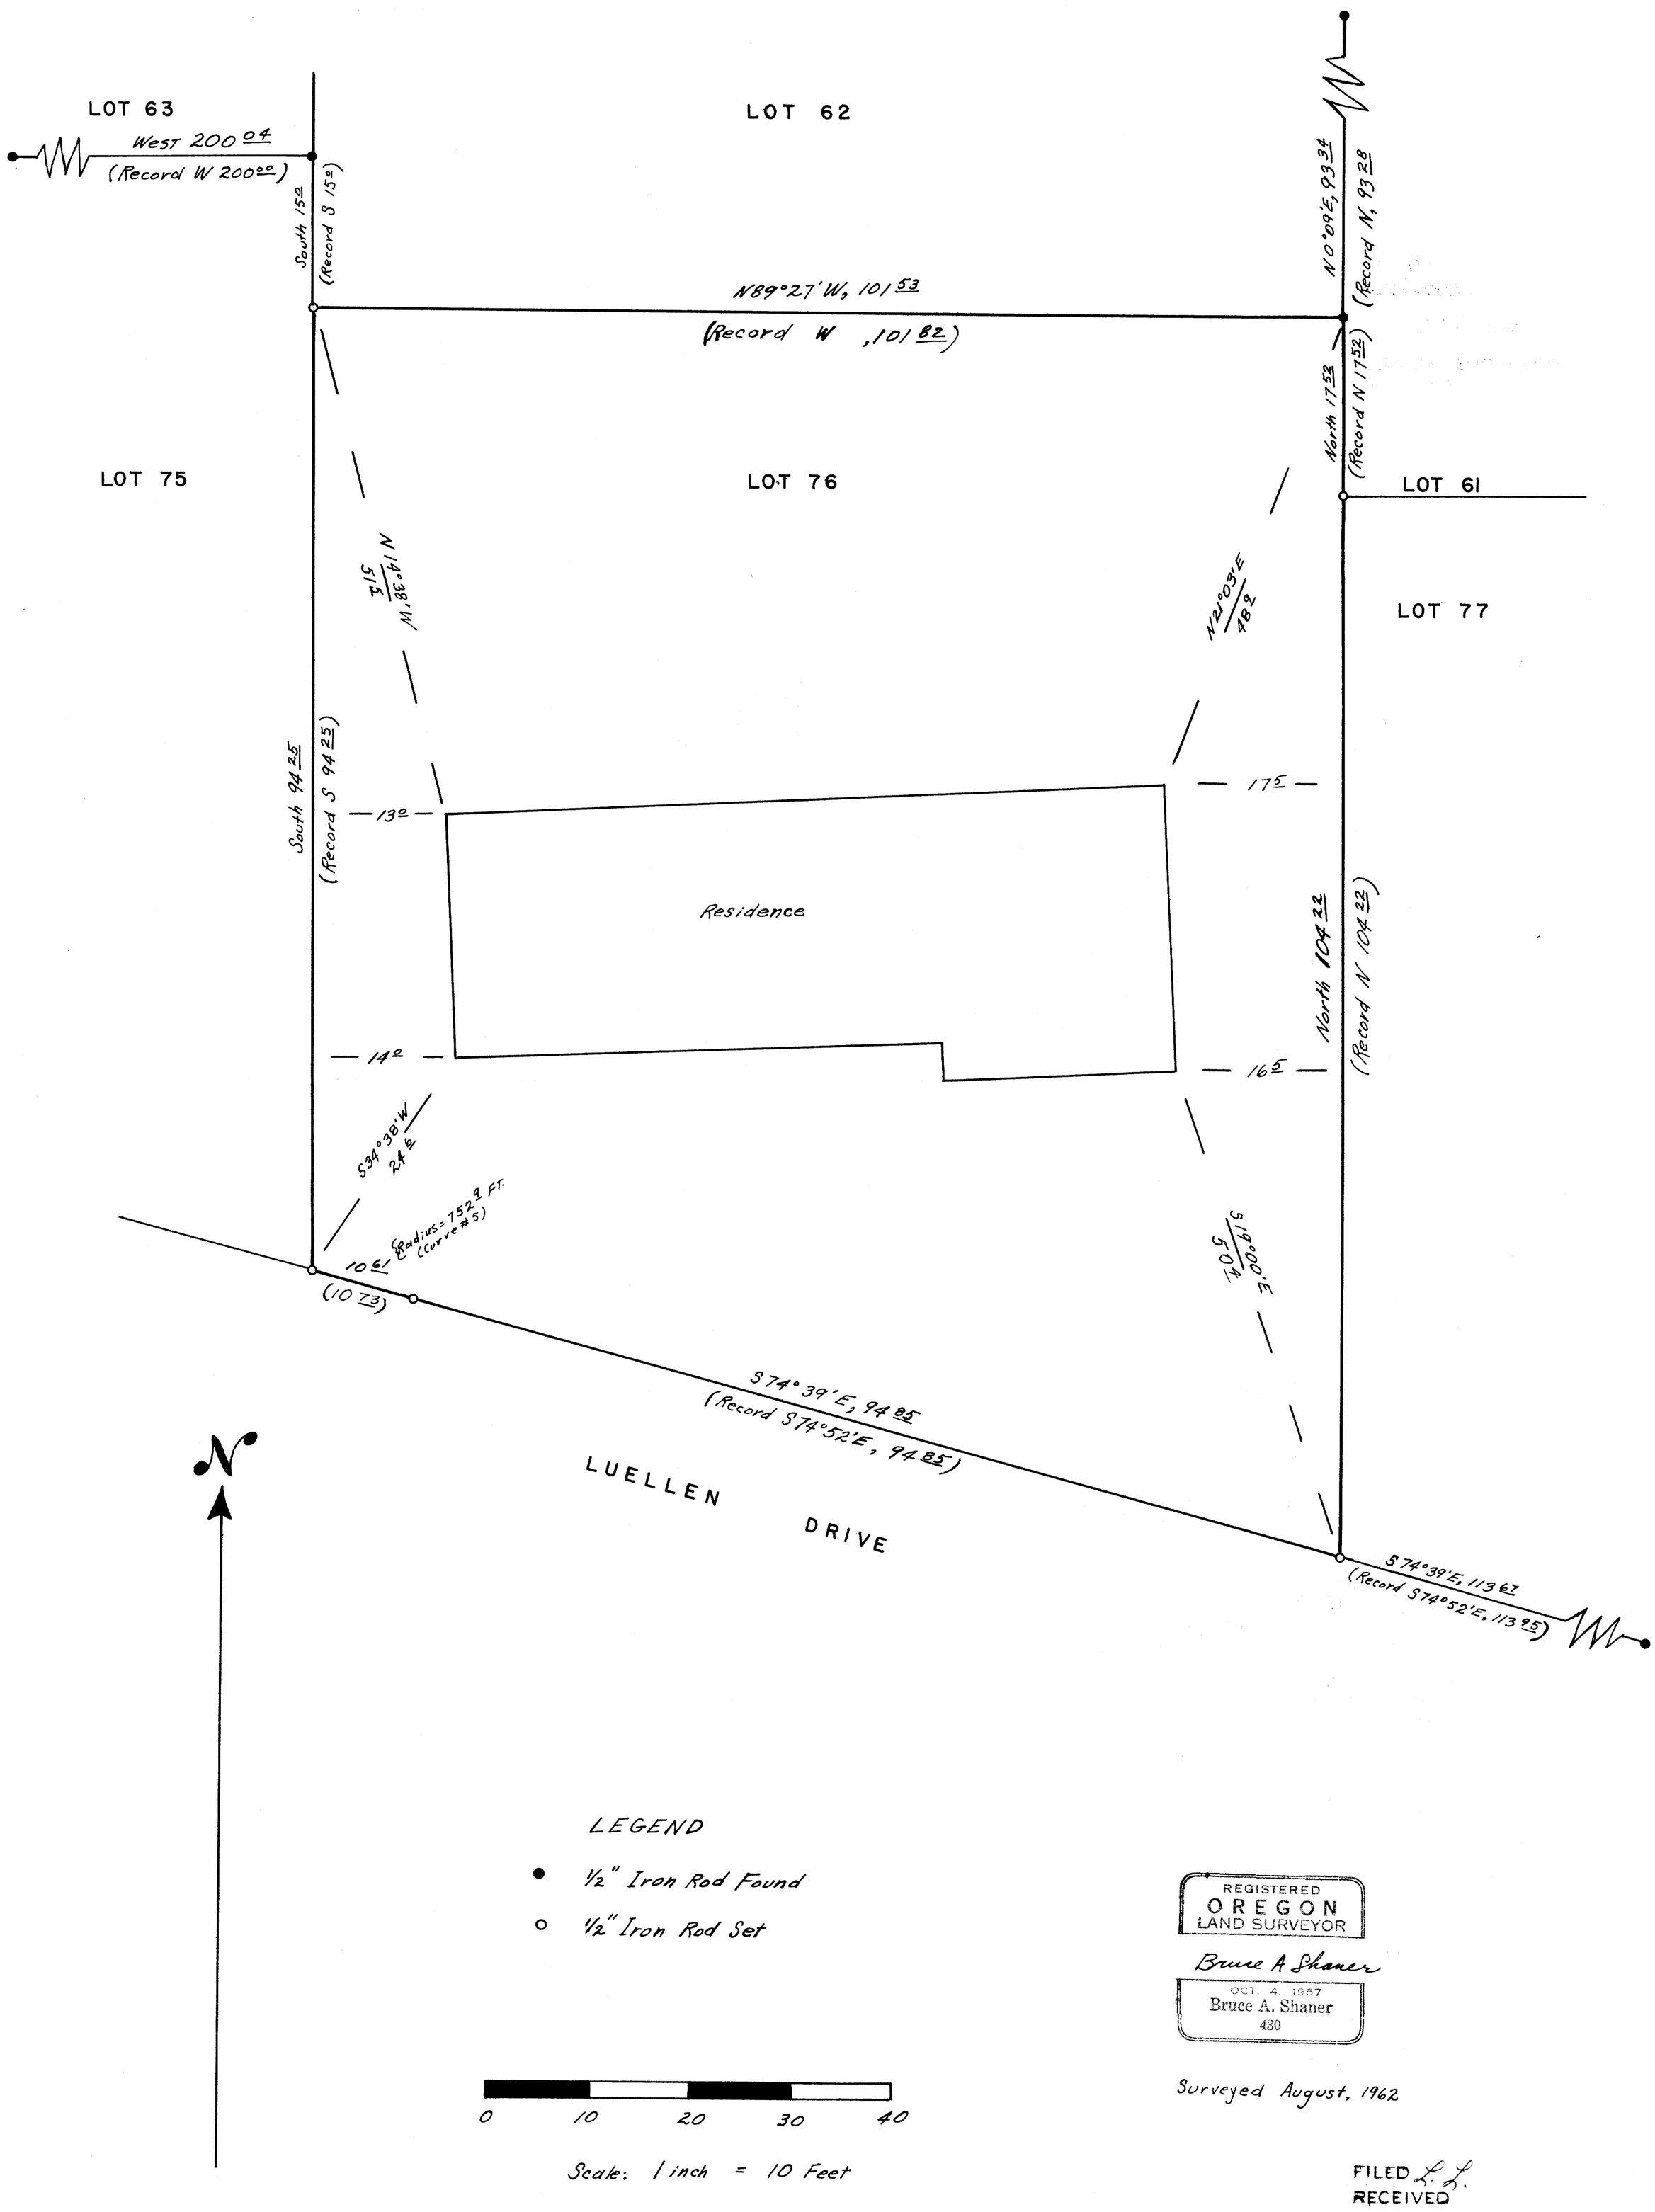

Bearings From Record

REGISTERED
OREGON
LAND SURVEYOR

Bruce A Shaner

OCT. 4, 1957
Bruce A. Shaner
430

Surveyed August, 1962

FILED
RECEIVED
SEP 4 1962
COUNTY SURVEYOR
DOUGLAS COUNTY, ORE.

MAP FILE M24-15