MAP FILE M 24 T 21 F.B. H-42

COUNTY SURVEYORS FILE DATA
DO NOT REMOVE FROM OFFICE

FILED L.L.
RECEIVED
OCT 4 1962
COUNTY SURVEYOR
DOUGLAS COUNTY, ORE.

SECT. 20, T. 21 S., R. 6 W.

Wooltey Logging Co. for Drain Orcg.

Scale 1" = 500' Aug. 1962

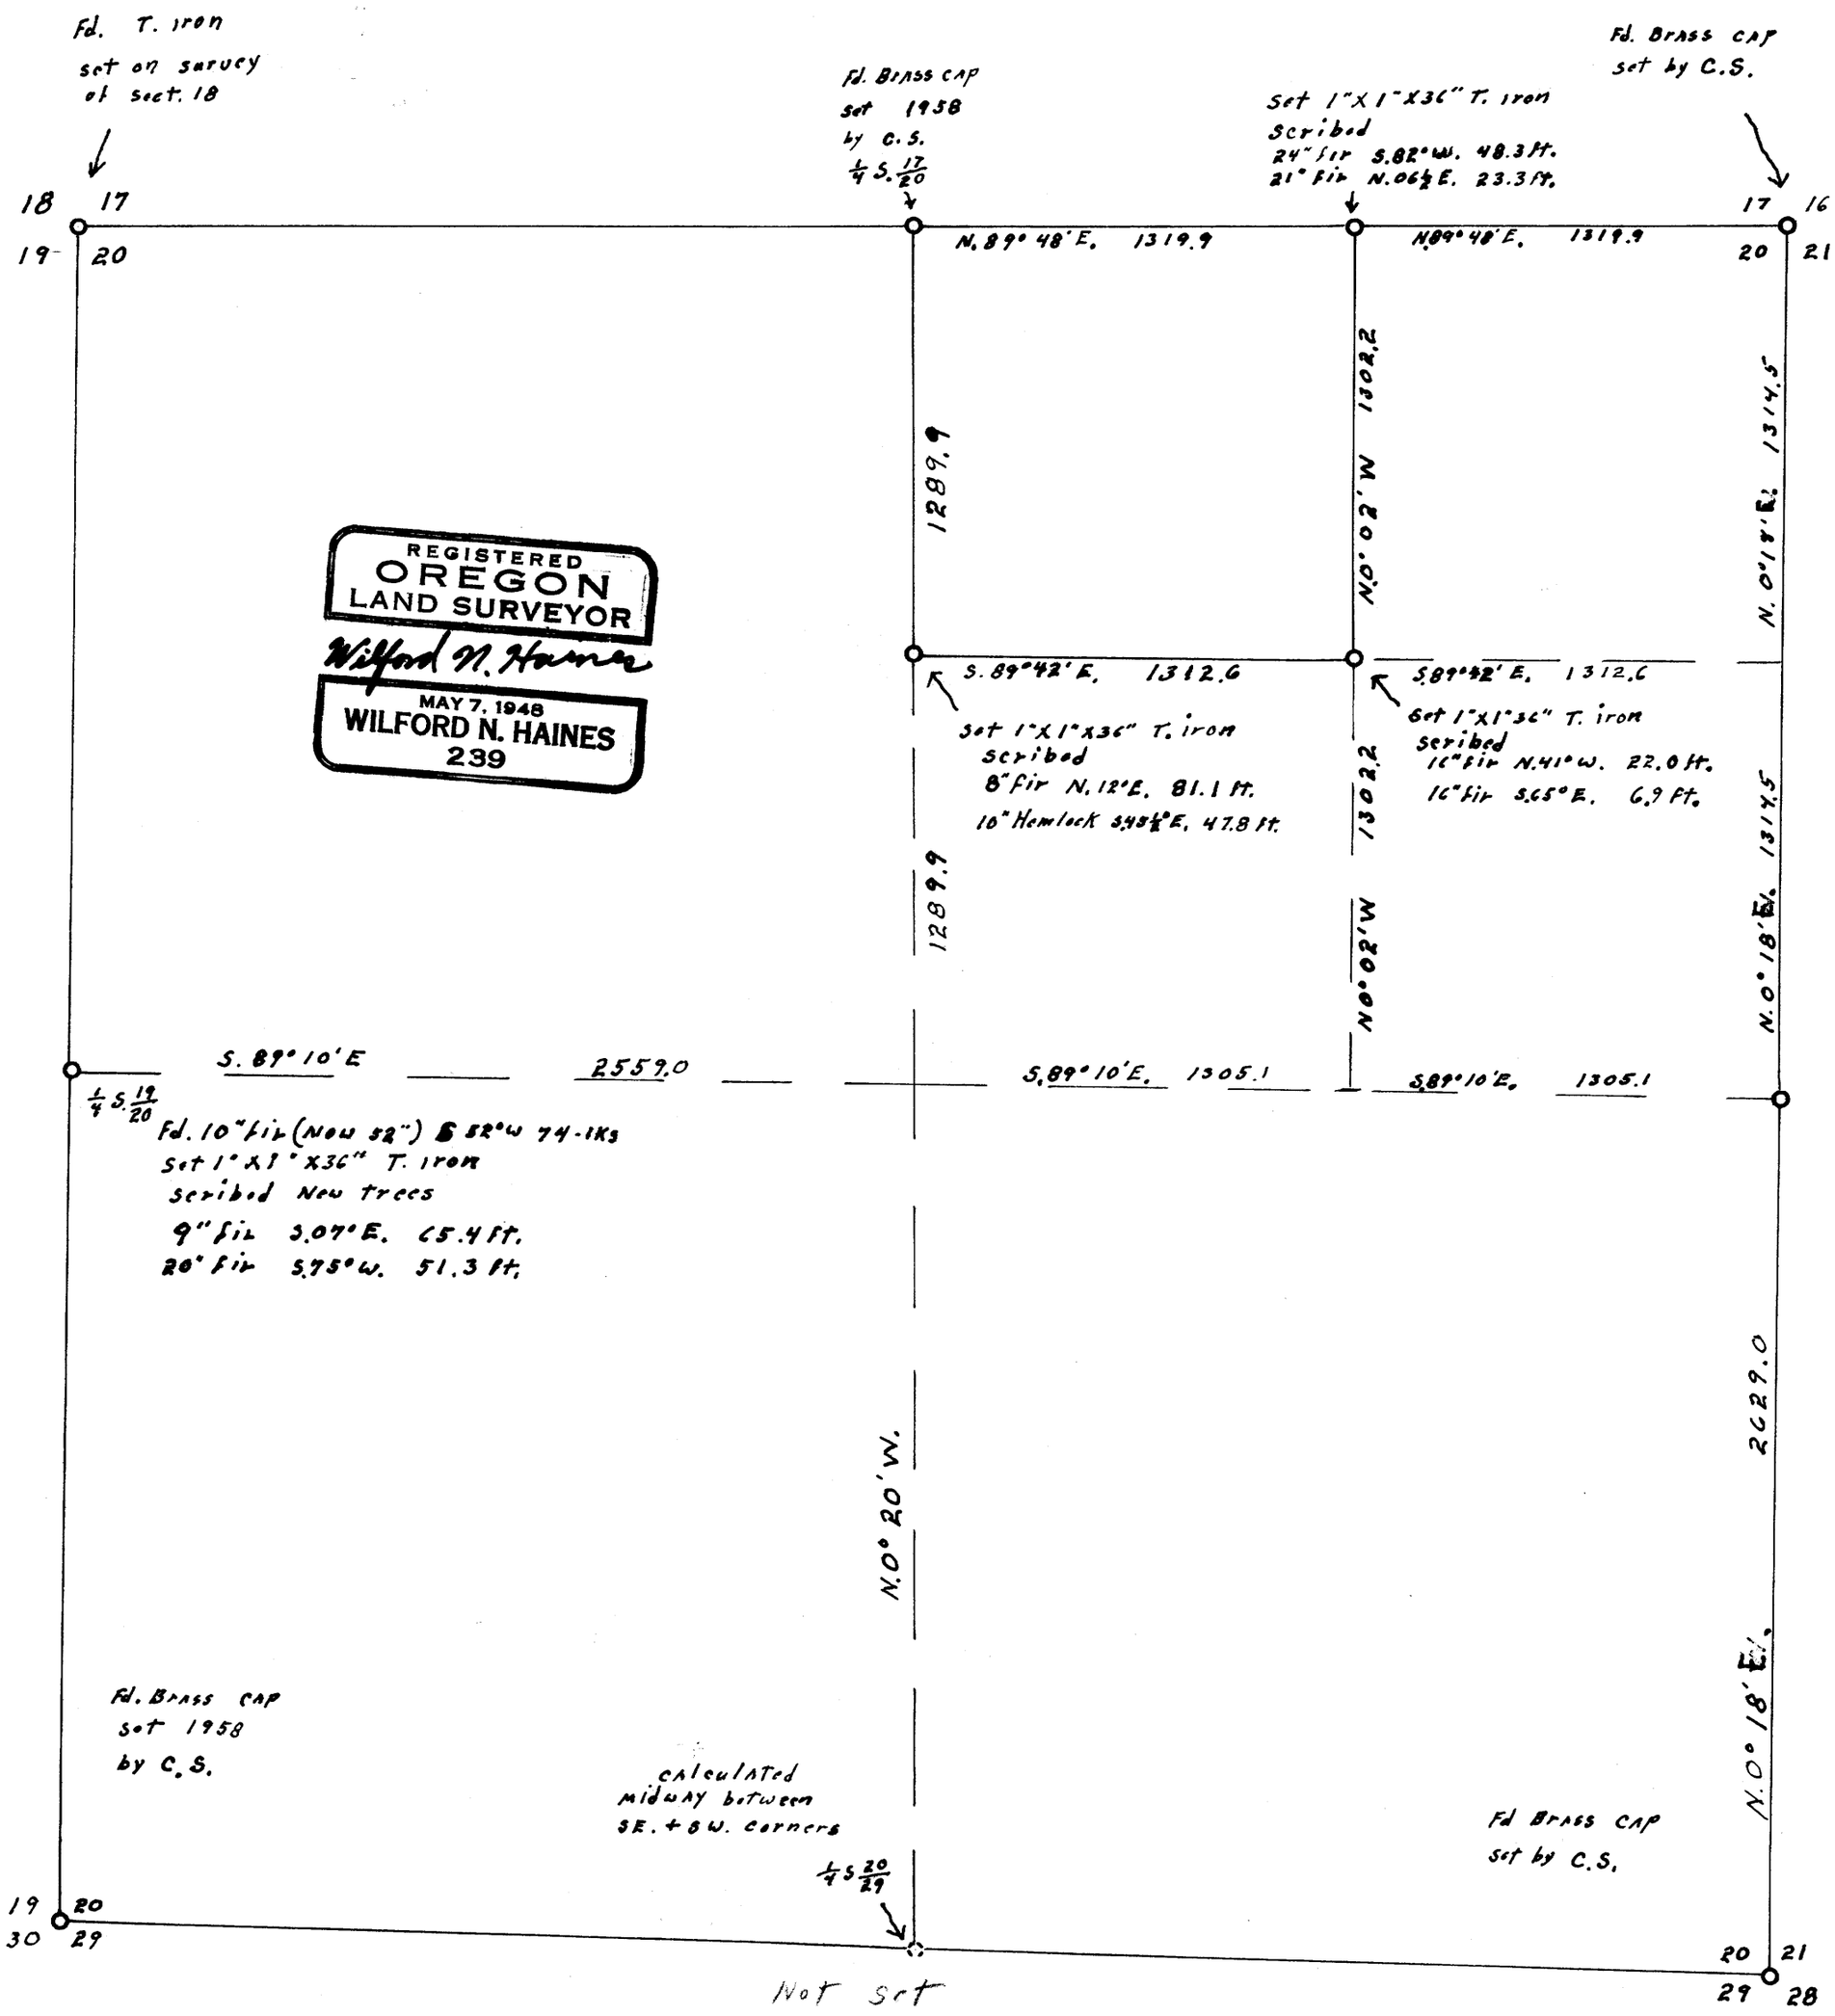

REGISTERED
OREGON
LAND SURVEYOR
Wilford N. Haines
MAY 7, 1948
WILFORD N. HAINES
239

(2)

MAP FILE M 24 T 21 F.B. H-42