C.S. FILE 52/124
M24-3

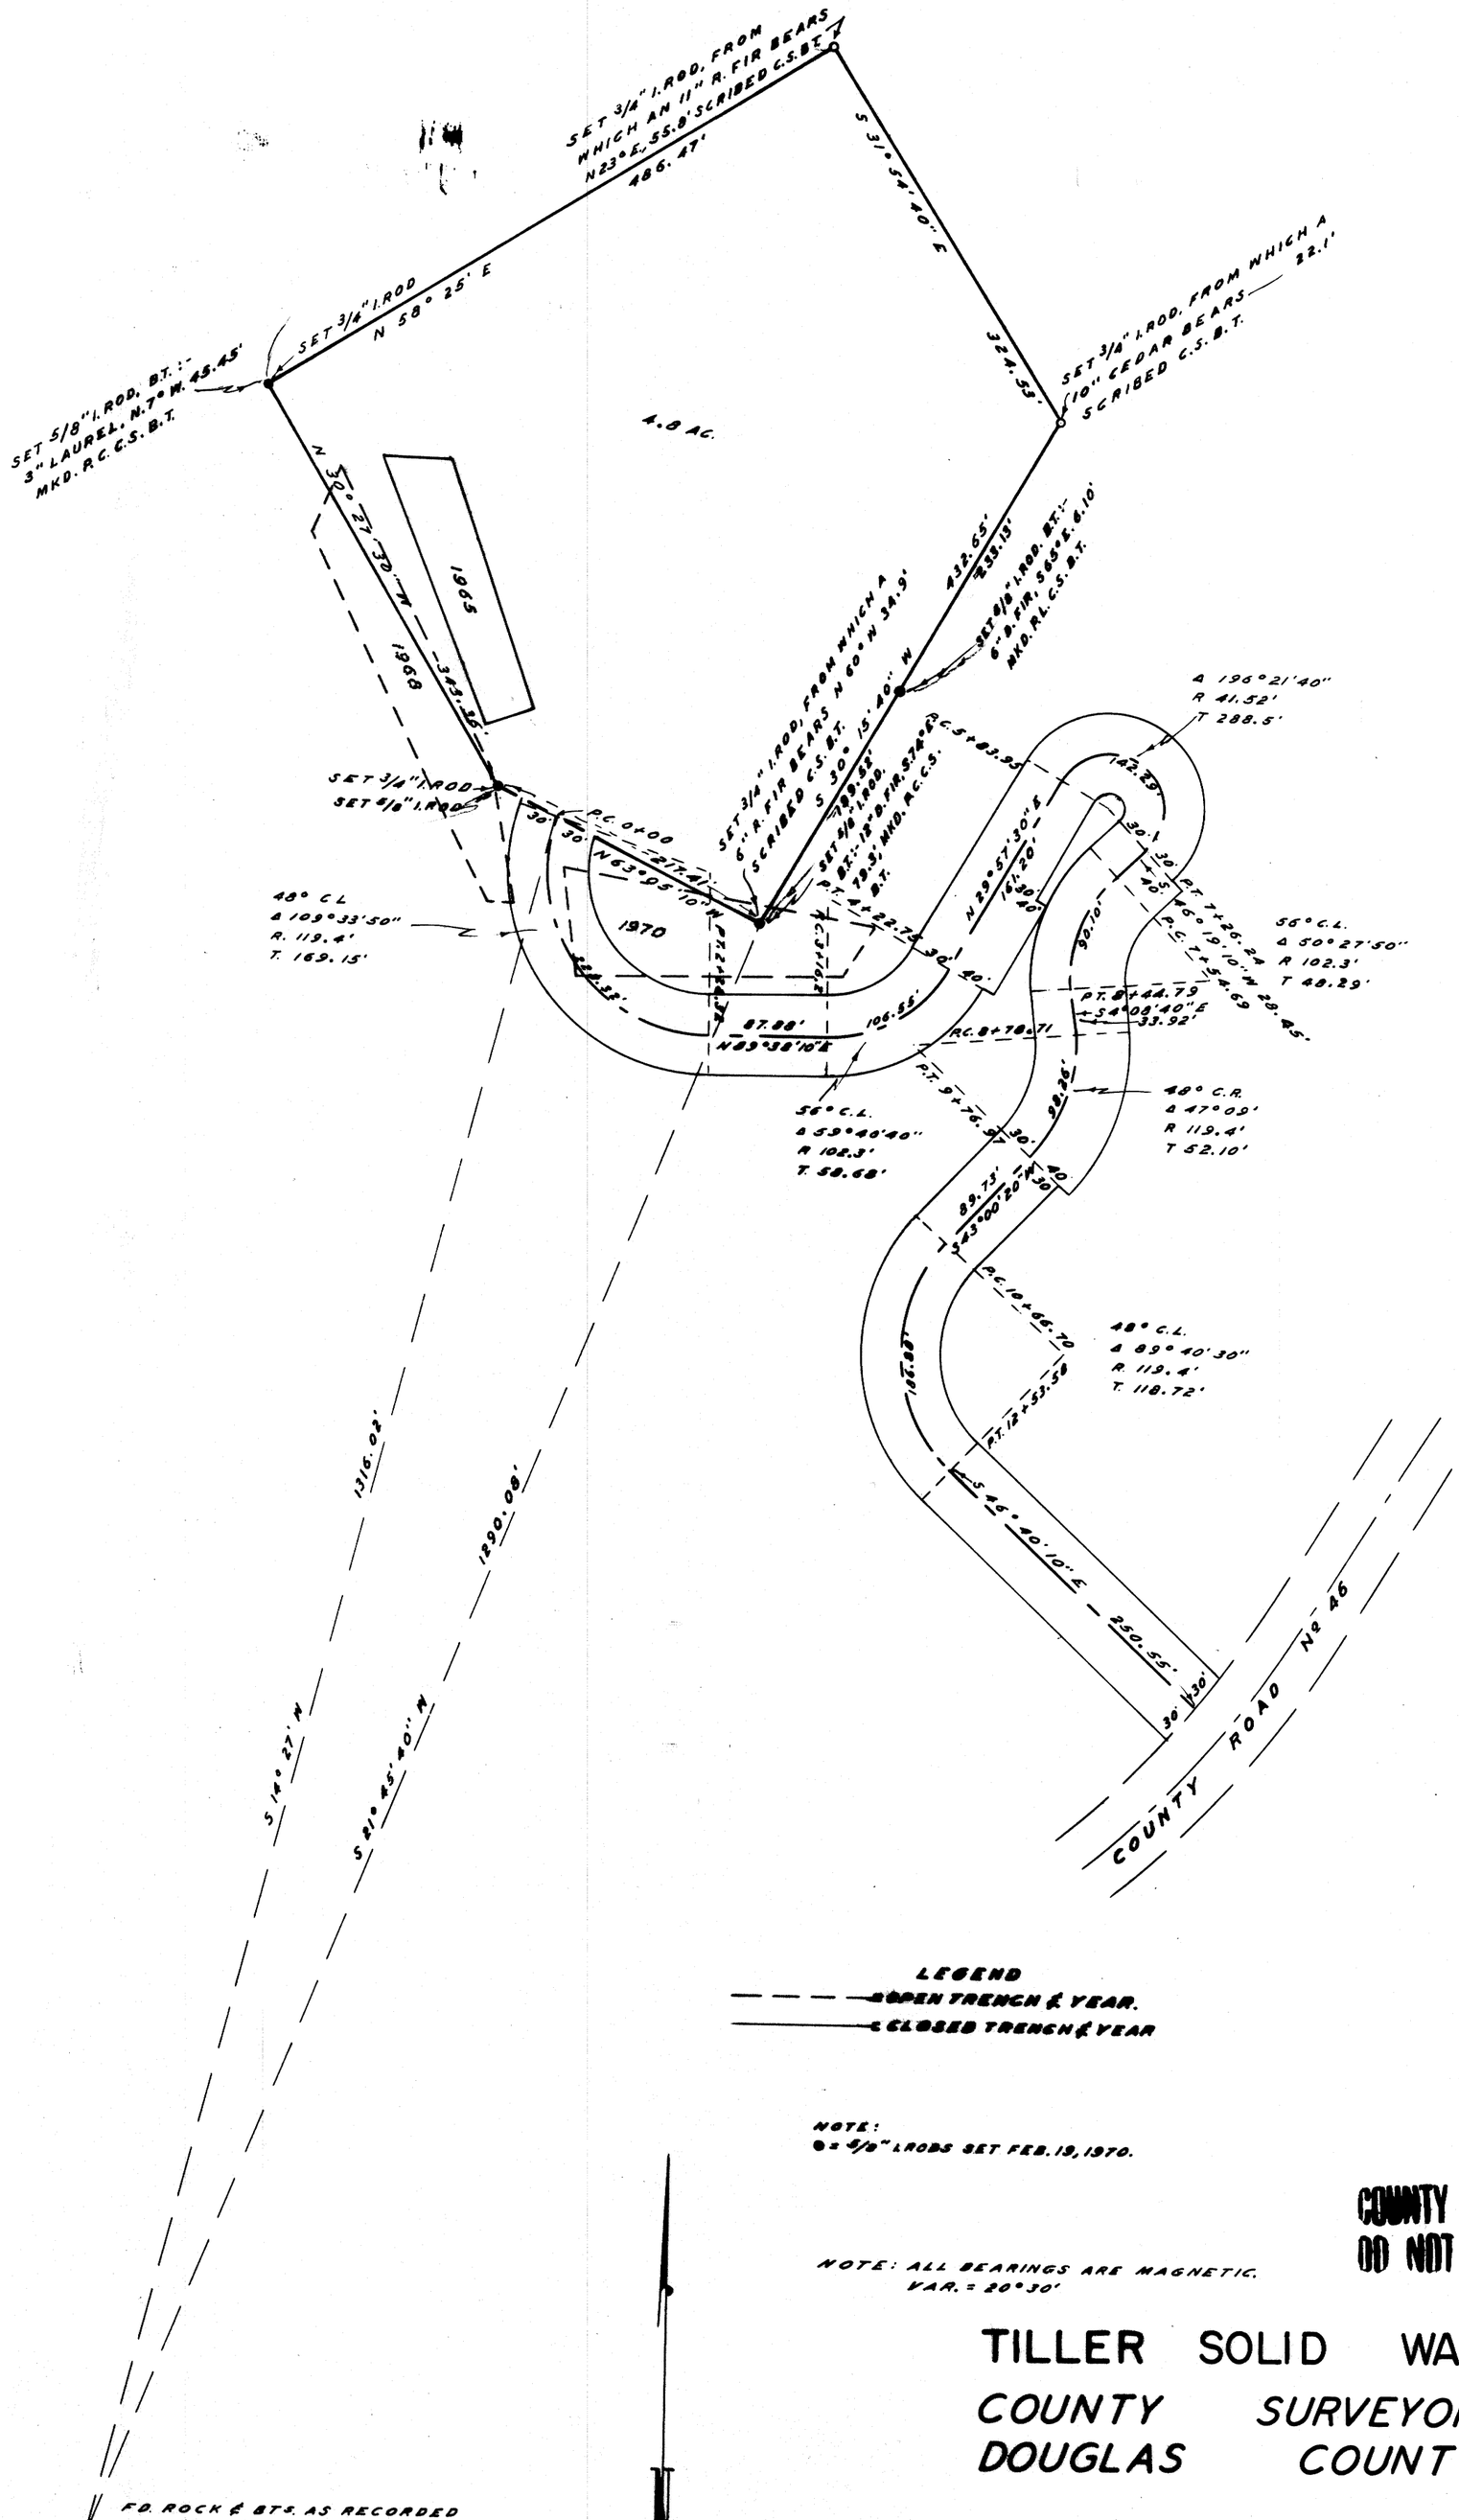

LEGEND
— — — OPEN TRENCH & YEAR.
——— CLOSED TRENCH & YEAR

NOTE:
● = 5/8" I.RODS SET FEB. 19, 1970.

NOTE: ALL BEARINGS ARE MAGNETIC.
VAR. = 20°30'

COUNTY SURVEYORS FILE DATA
DO NOT REMOVE FROM OFFICE

TILLER SOLID WASTE SITE

COUNTY SURVEYOR'S OFFICE
DOUGLAS COUNTY, OREGON

SURVEY FOR DESCRIPTION OF SPECIAL USE PERMIT AREA & ROAD
SECTION 13, T30S., R2W., W.M.

FRED M. DARBY — COUNTY SURVEYOR
SURVEYED JUNE 14, 1962 — BY
JAMES W. BYRON - DEPUTY — SCALE 1" = 100'
SURVEYED FOR DOUGLAS CO. HEALTH DEPT.

REGISTERED
OREGON
LAND SURVEYOR

James W. Byron

NOV. 6, 1953
JAMES W. BYRON
303