F.B. H-187
M 24-42

COUNTY SURVEYORS FILE DATA
DO NOT REMOVE FROM OFFICE

S. 9 (NE¼) T. 23 S., R. 4 W. W.M.

Survey To Determine lines + corners

For

Jim S. Whipple — Drain Oreg.

Scale 1" = 500' — Dec. 1962

REGISTERED
OREGON
LAND SURVEYOR

Wilford N. Haines

MAY 7, 1948
WILFORD N. HAINES
239

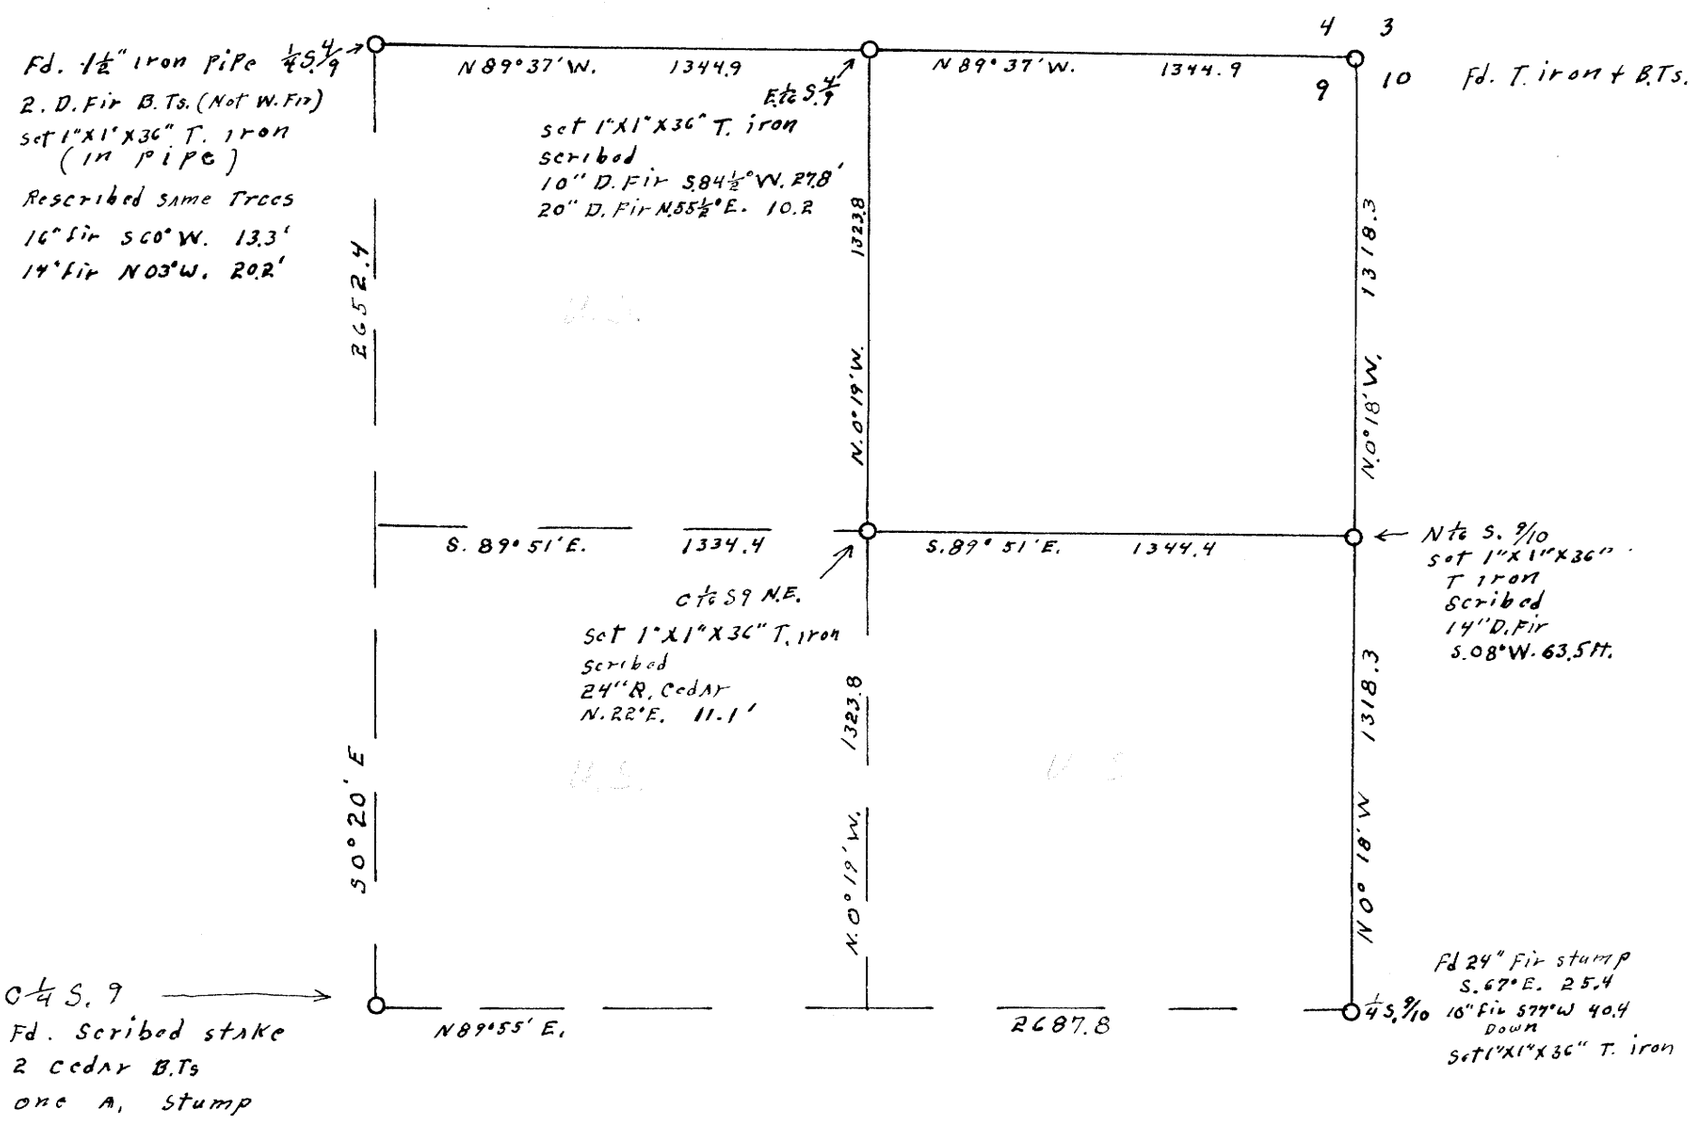

FILED L. L.
RECEIVED

DEC 24 1962

COUNTY SURVEYOR
DOUGLAS COUNTY, ORE.

F.B. H-187
MAP FILE M24-42