MAP FILE M 24 P-59

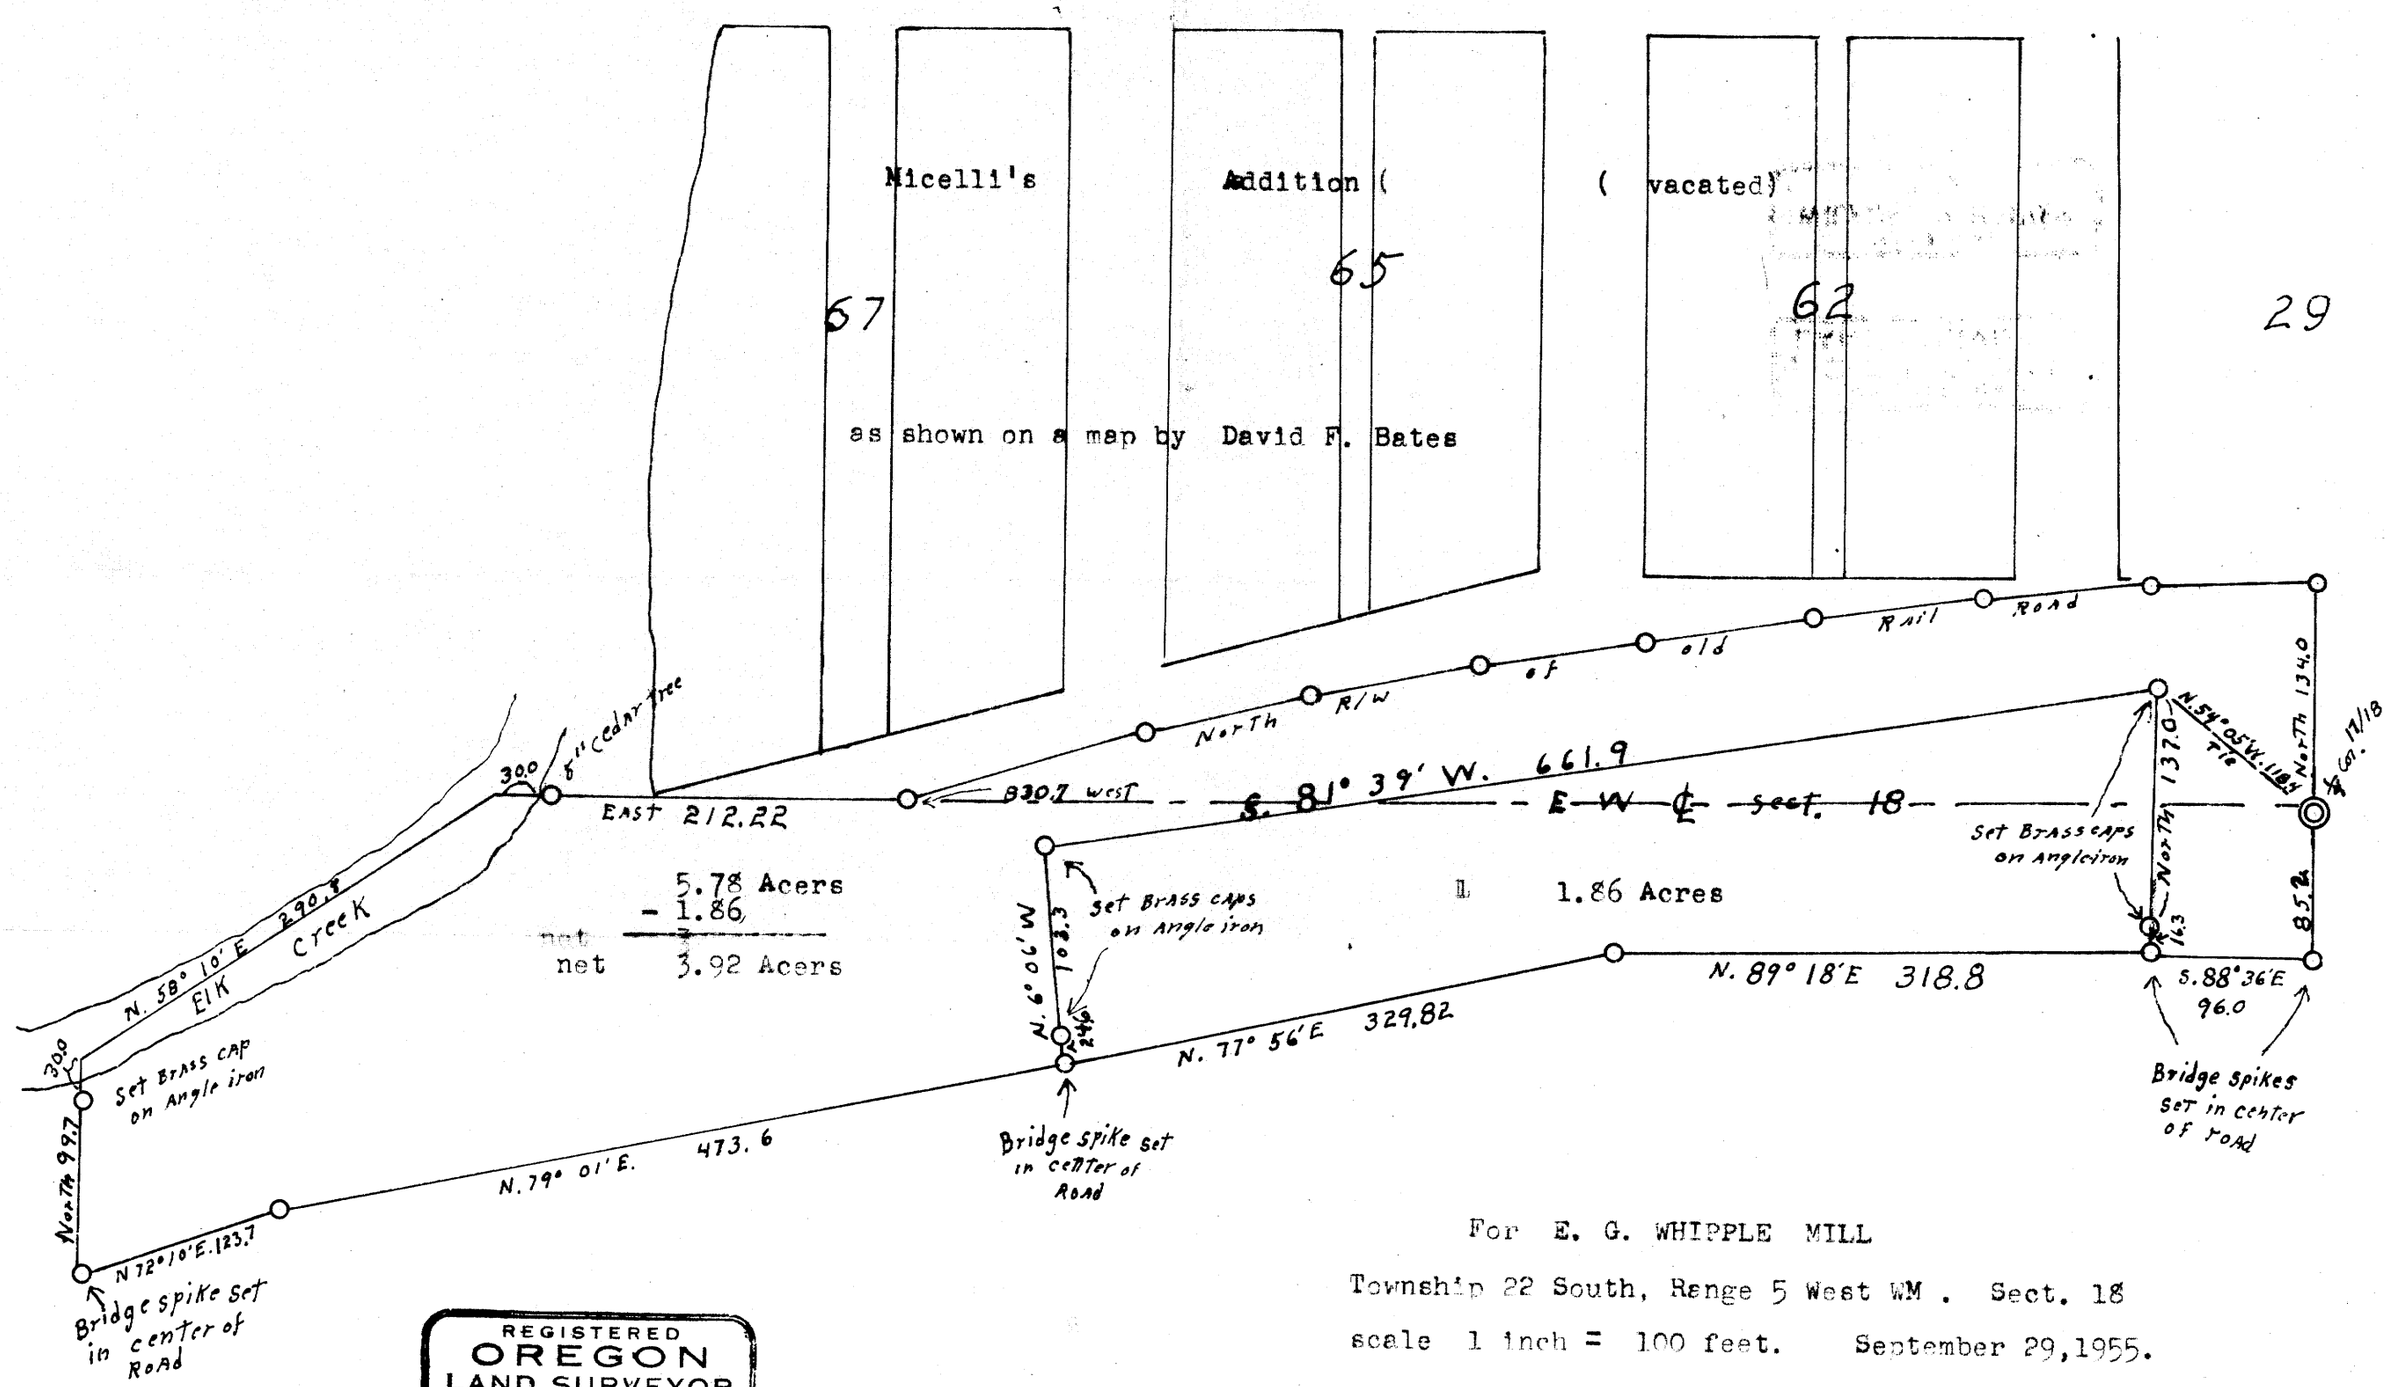

REGISTERED
OREGON
LAND SURVEYOR
Wilford N. Haines
MAY 7, 1948
WILFORD N. HAINES
239

For E. G. WHIPPLE MILL

Township 22 South, Range 5 West WM . Sect. 18

scale 1 inch = 100 feet. September 29,1955.

FILED
RECEIVED
FEB 7 1968
COUNTY SURVEYOR
DOUGLAS COUNTY, ORE.

MAP FILE M 24 P-59 P