M 24-71

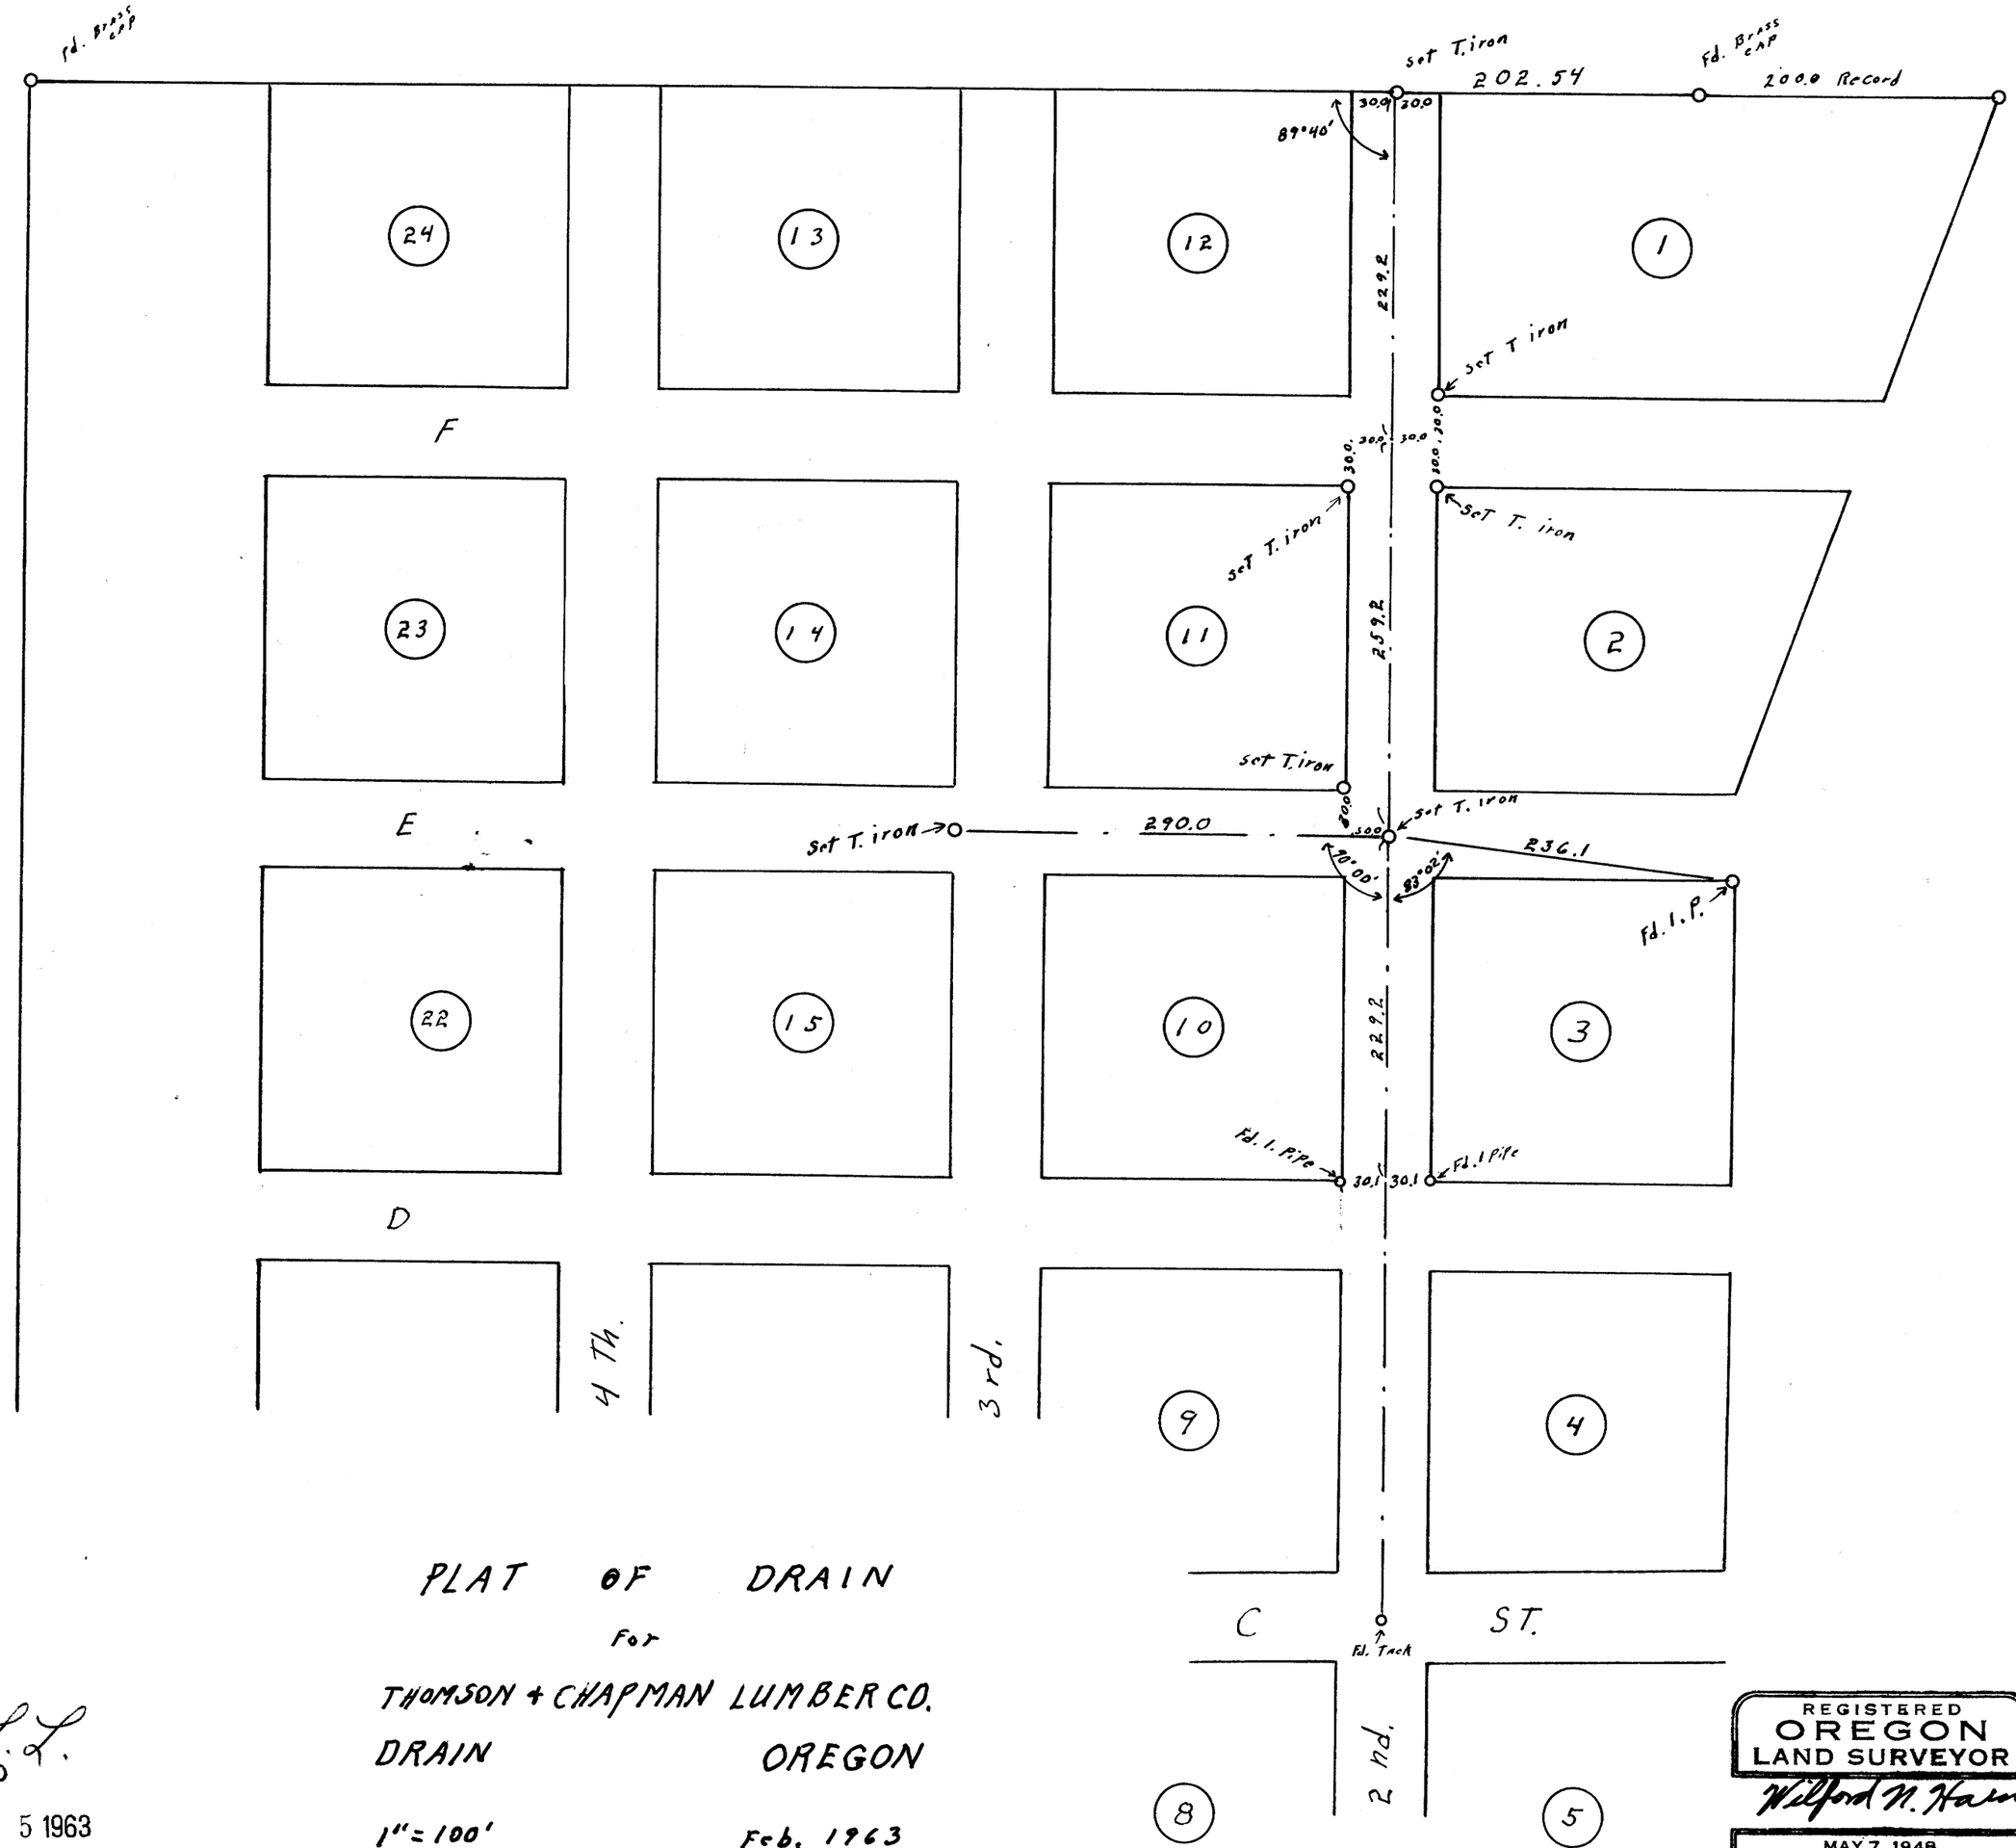

PLAT OF DRAIN

For

THOMSON + CHAPMAN LUMBER CO.

DRAIN OREGON

1" = 100' Feb. 1963

FILED L.L.
RECEIVED
MAR 5 1963
COUNTY SURVEYOR
DOUGLAS COUNTY, ORE.

REGISTERED
OREGON
LAND SURVEYOR
Wilford N. Haines
MAY 7, 1948
WILFORD N. HAINES
239

COUNTY SURVEYORS FILE DATA
DO NOT REMOVE FROM OFFICE

T22-5 SW SE Sec 8

MAP FILE M24 P 71