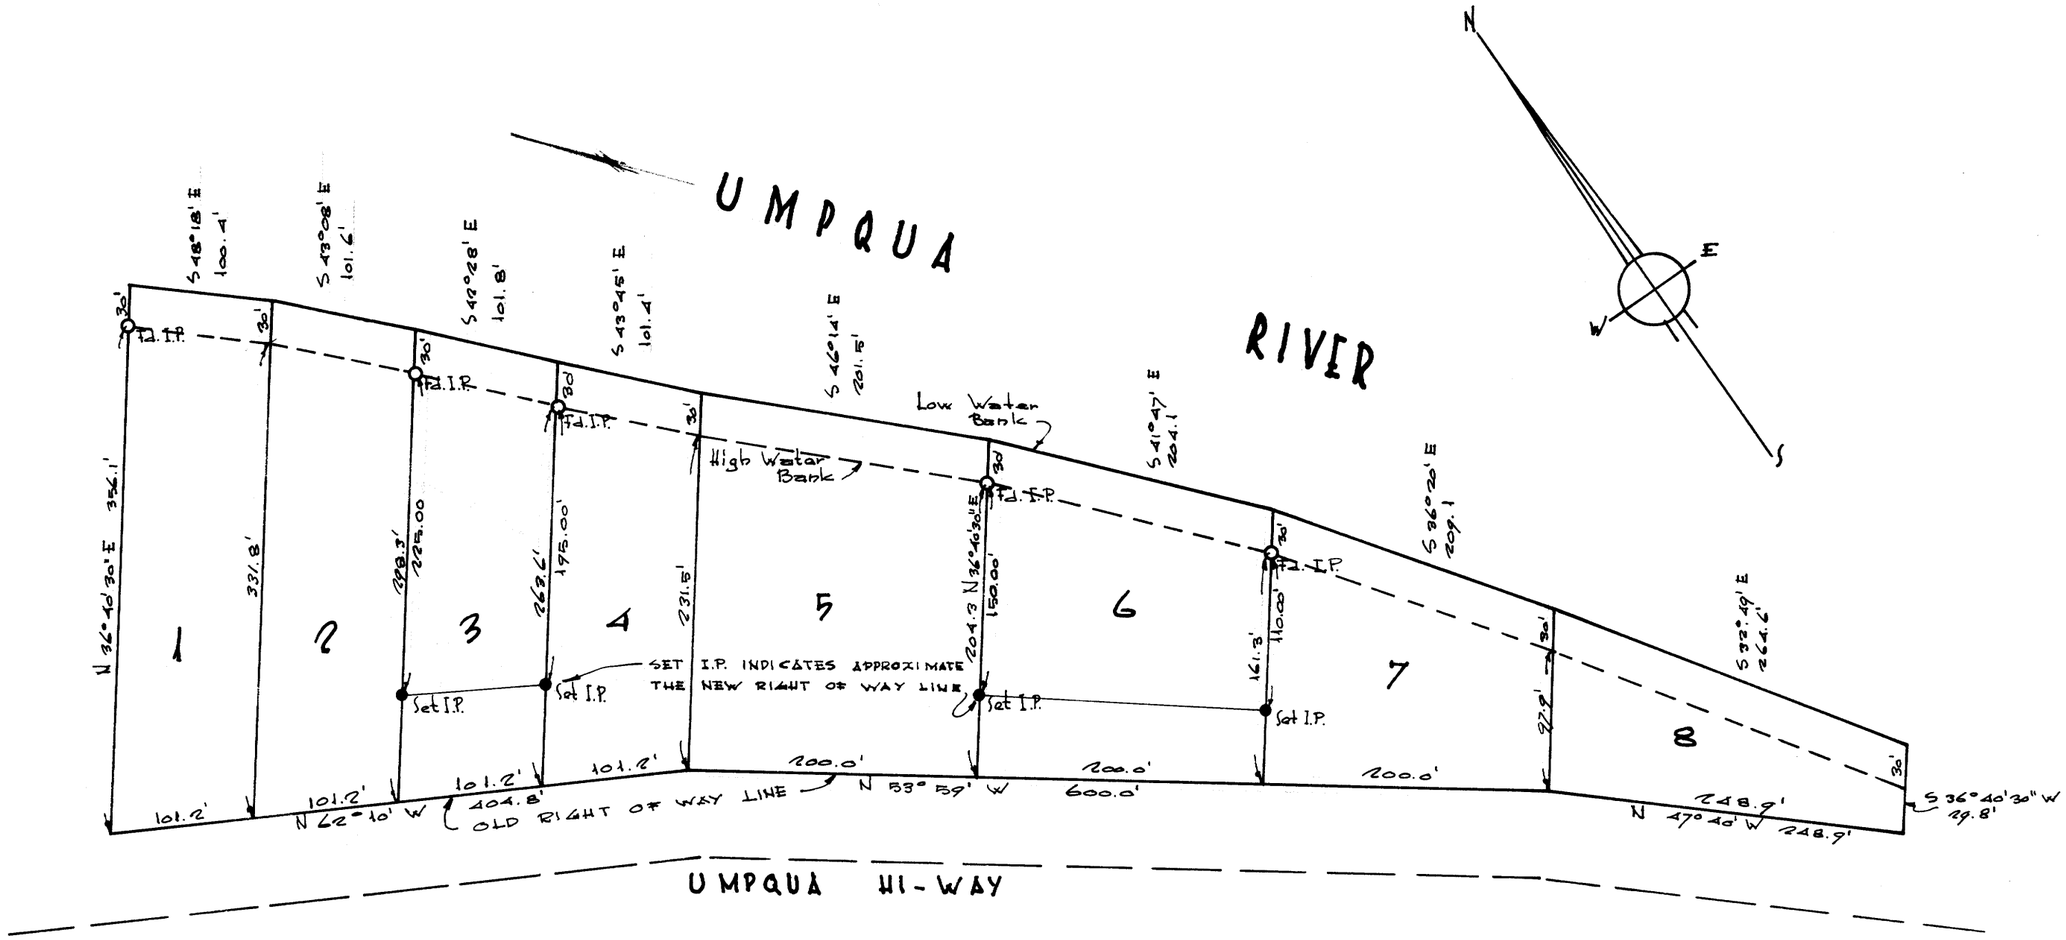

COUNTY SURVEYORS FILE DATA
DO NOT REMOVE FROM OFFICE

FILED
RECEIVED
MAR 13 1963
COUNTY SURVEYOR
DOUGLAS COUNTY, ORE.

REGISTERED PROFESSIONAL ENGINEER
OREGON
NOV. 1, 1961
ROY H. ERICKSEN

PROPERTY SURVEY

Hail's Harbor No 2 in Sections 6 & 7.
T. 22 S R.10W., WM. Lot 3 & 6

scale: 1" = 100' date: 12 March 1963
For: John Diehl Real Estate, Reedsport Ore.

MAP FILE M24 F 73
M 24-78