C.S. FILE 43/177
MAP FILE M24/9

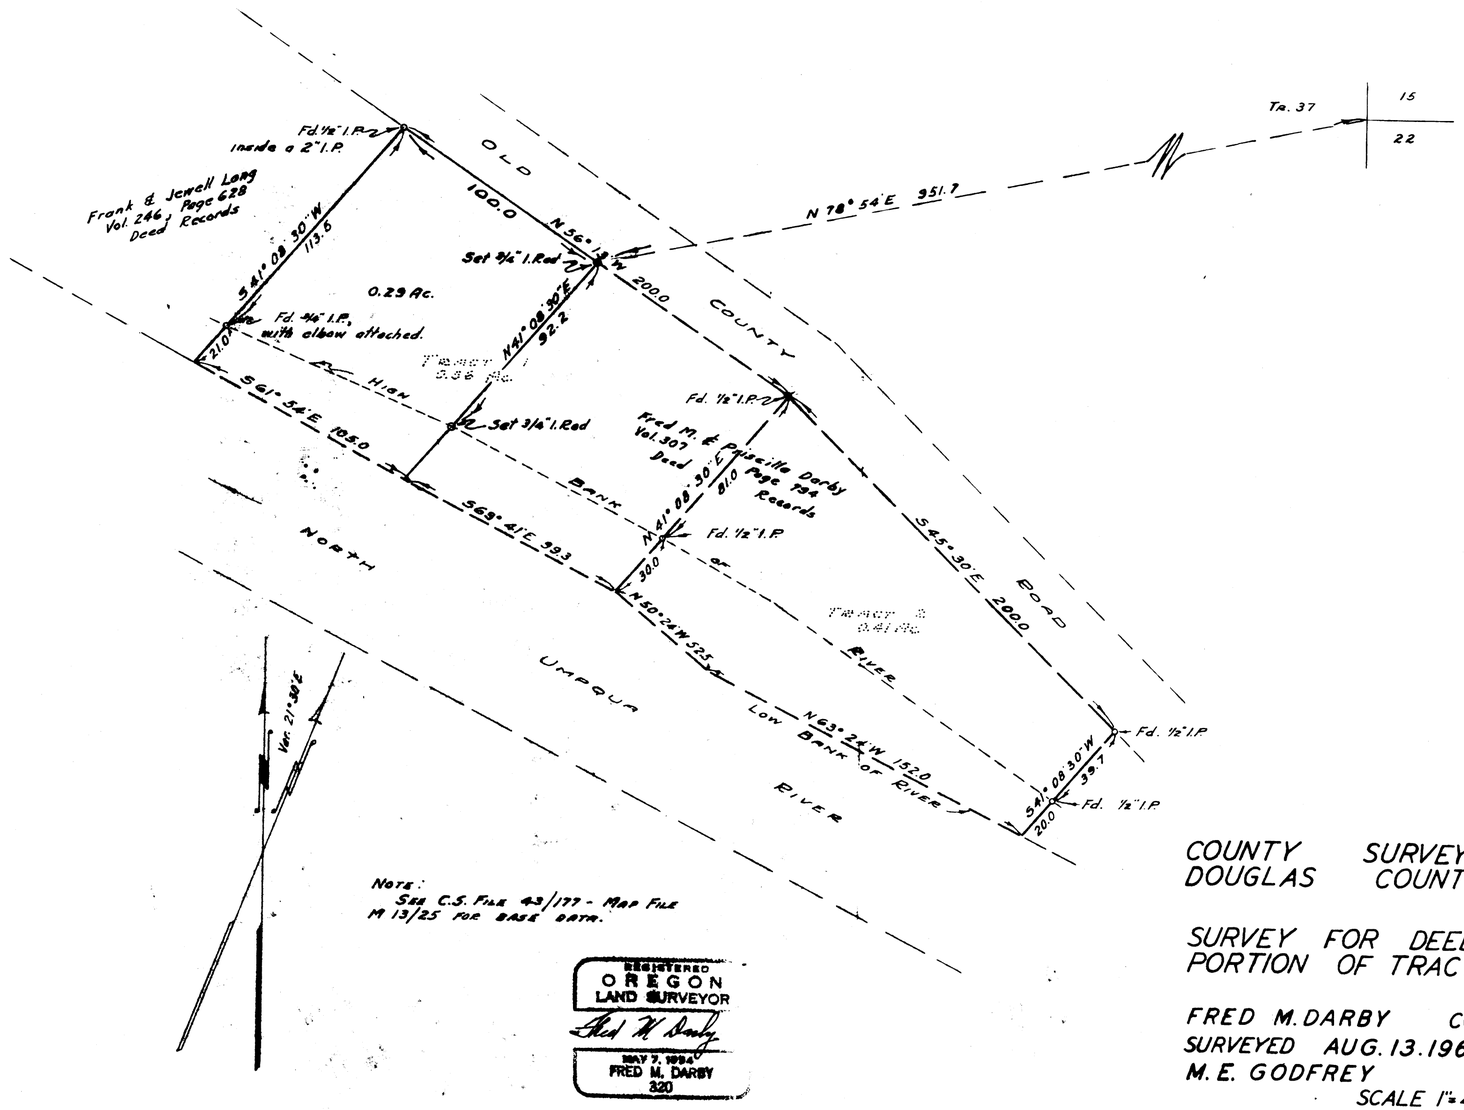

COUNTY SURVEYOR'S OFFICE
DOUGLAS COUNTY, OREGON

SURVEY FOR DEED DESCRIPTION,
PORTION OF TRACT 37, T26S, R2W.

FRED M. DARBY COUNTY SURVEYOR
SURVEYED AUG. 13. 1962. BY
M. E. GODFREY DEPUTY
SCALE 1"=40'

COUNTY SURVEYORS FILE DATA
DO NOT REMOVE FROM OFFICE

C.S. FILE 43/177
MAP FILE M24/9

C.S. FILE 43/177
MAP FILE M24/9