C.S. FILE 43/93
M 25-19

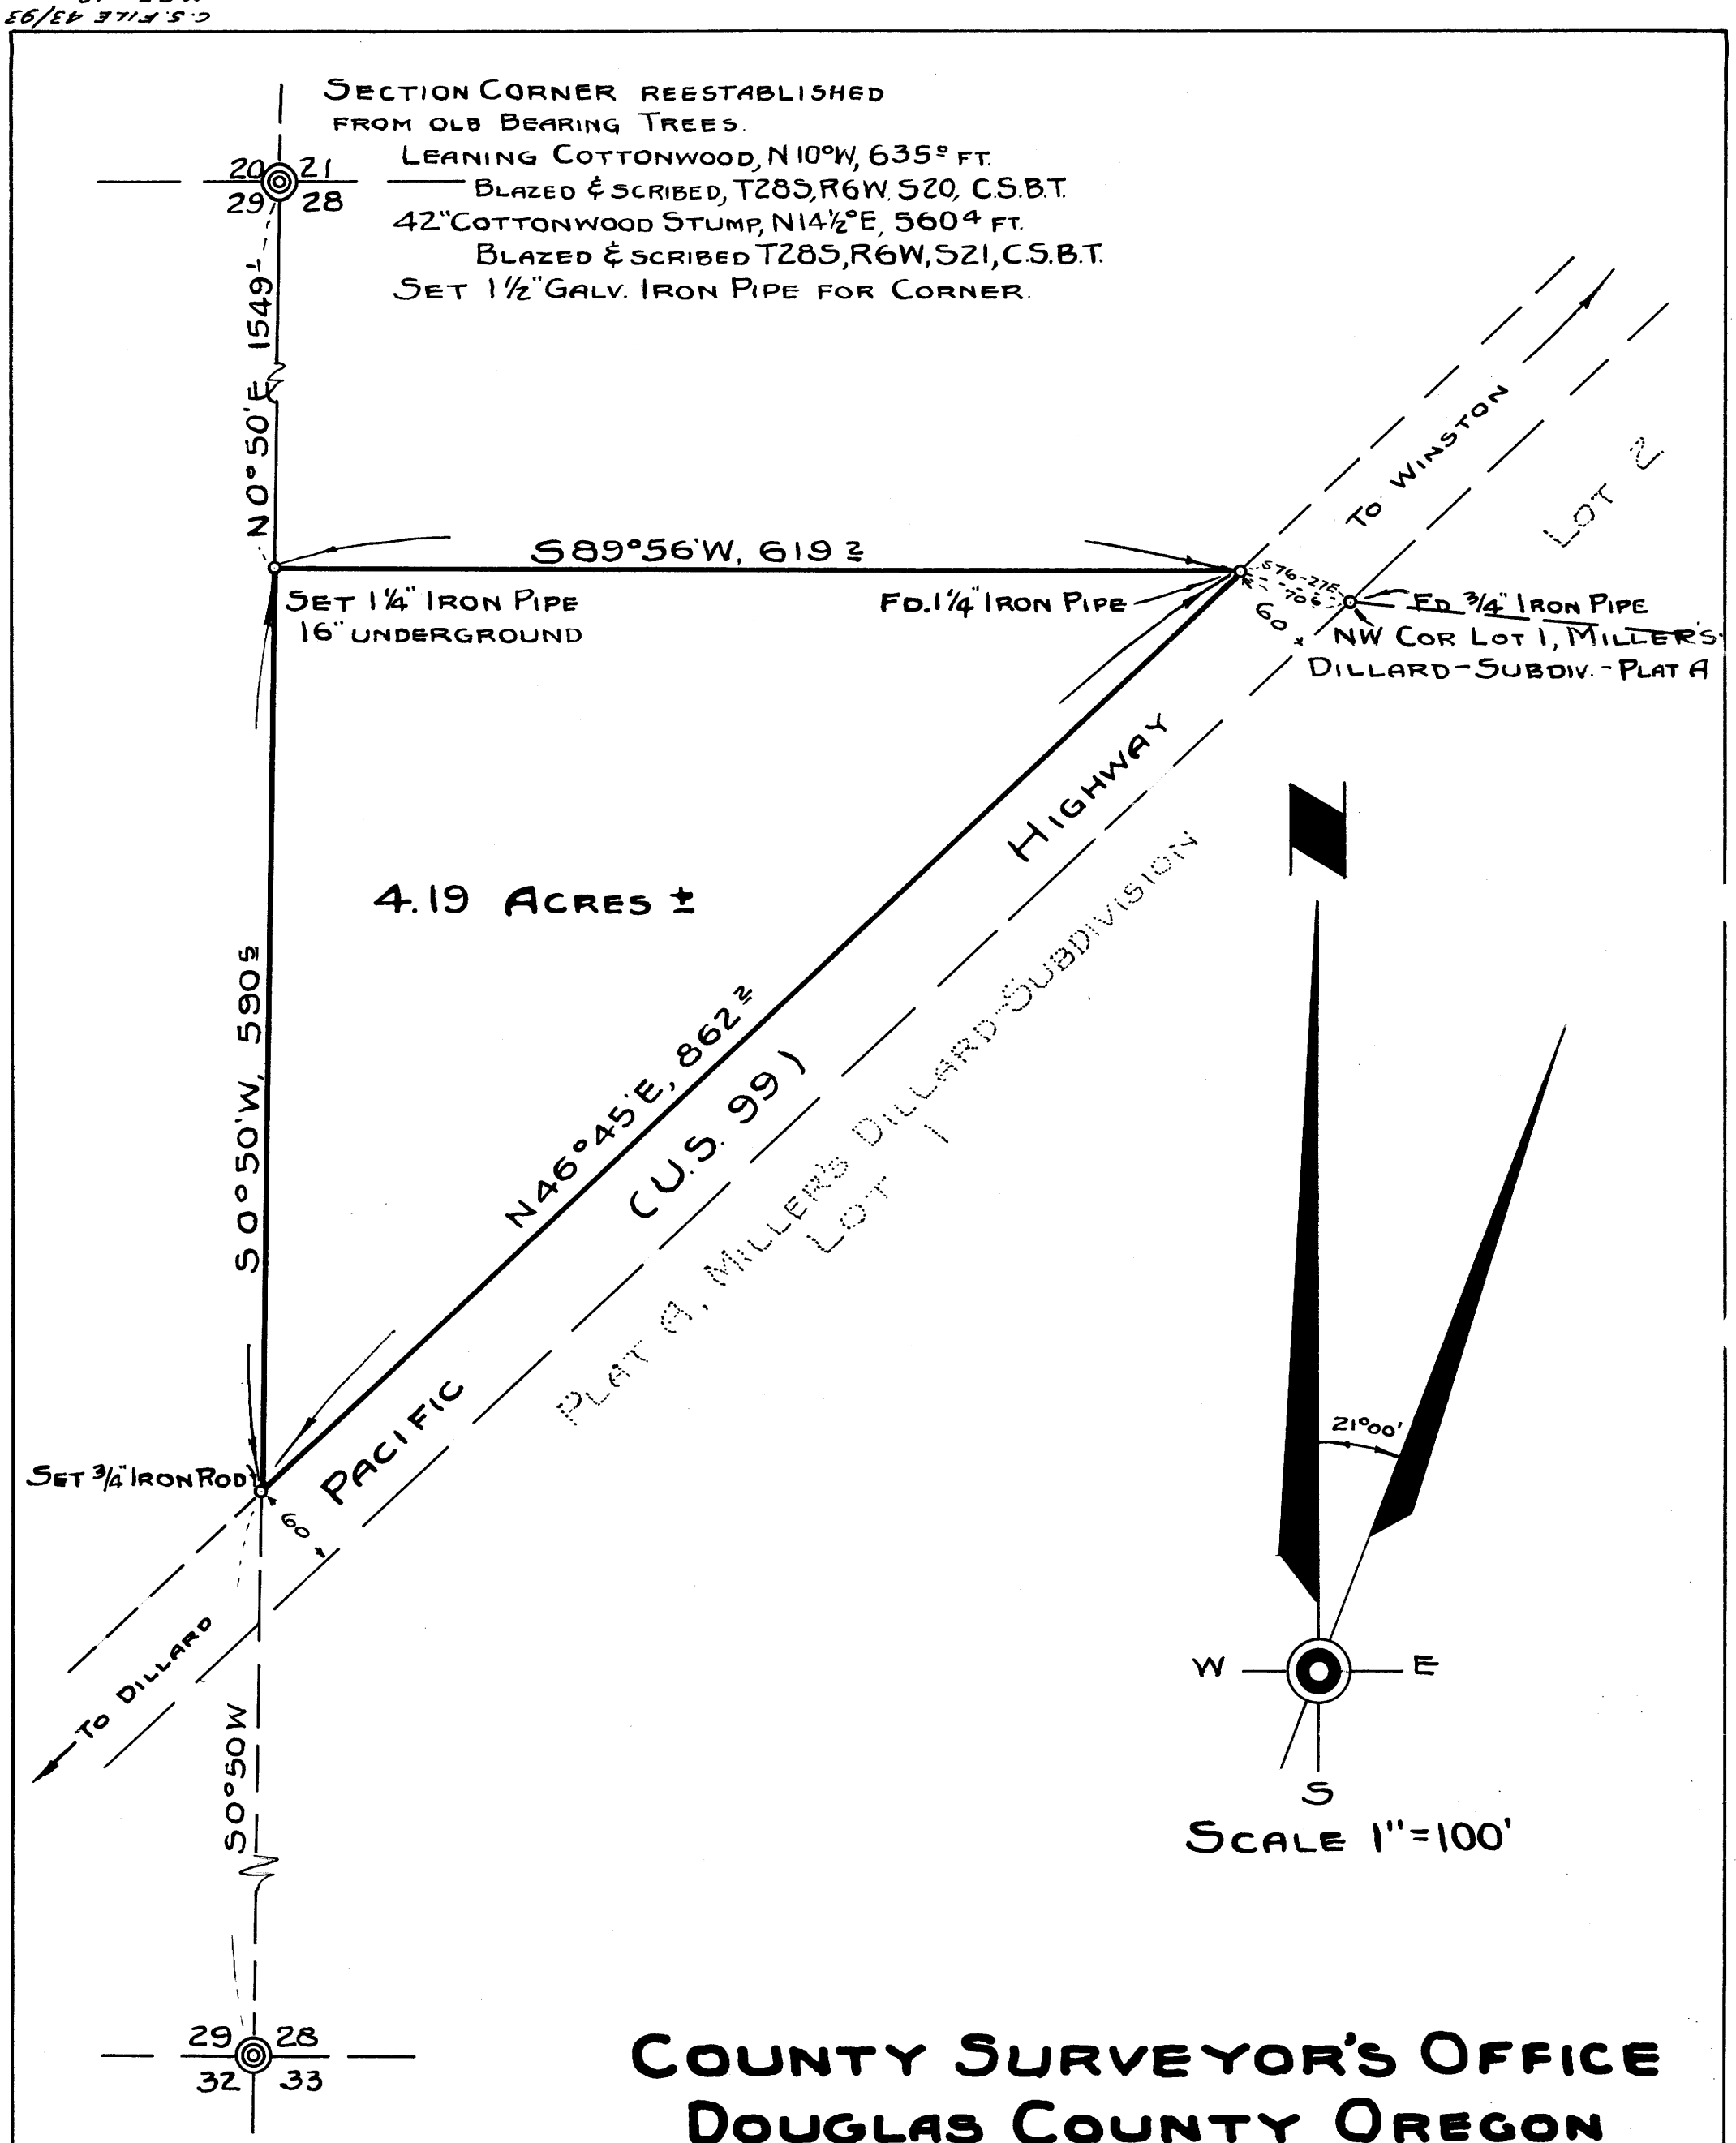

COUNTY SURVEYOR'S OFFICE
DOUGLAS COUNTY OREGON
SURVEY FOR DEED DESCRIPTION
SECTION 28, T28S., R6W. WM.

REGISTERED PROFESSIONAL ENGINEER 2741 OREGON NOV. 7, 1947 ARTHUR R. EVANS

BEN B. IRVING COUNTY SURVEYOR
SURVEYED & PLATTED, MAY, 1949, BY
A.R. EVANS, DEP. COUNTY SURVEYOR

COUNTY SURVEYORS FILE
DO NOT REMOVE FROM OFFICE

M 25-19 P
FILE 93 DRAWER 431