M 25-26

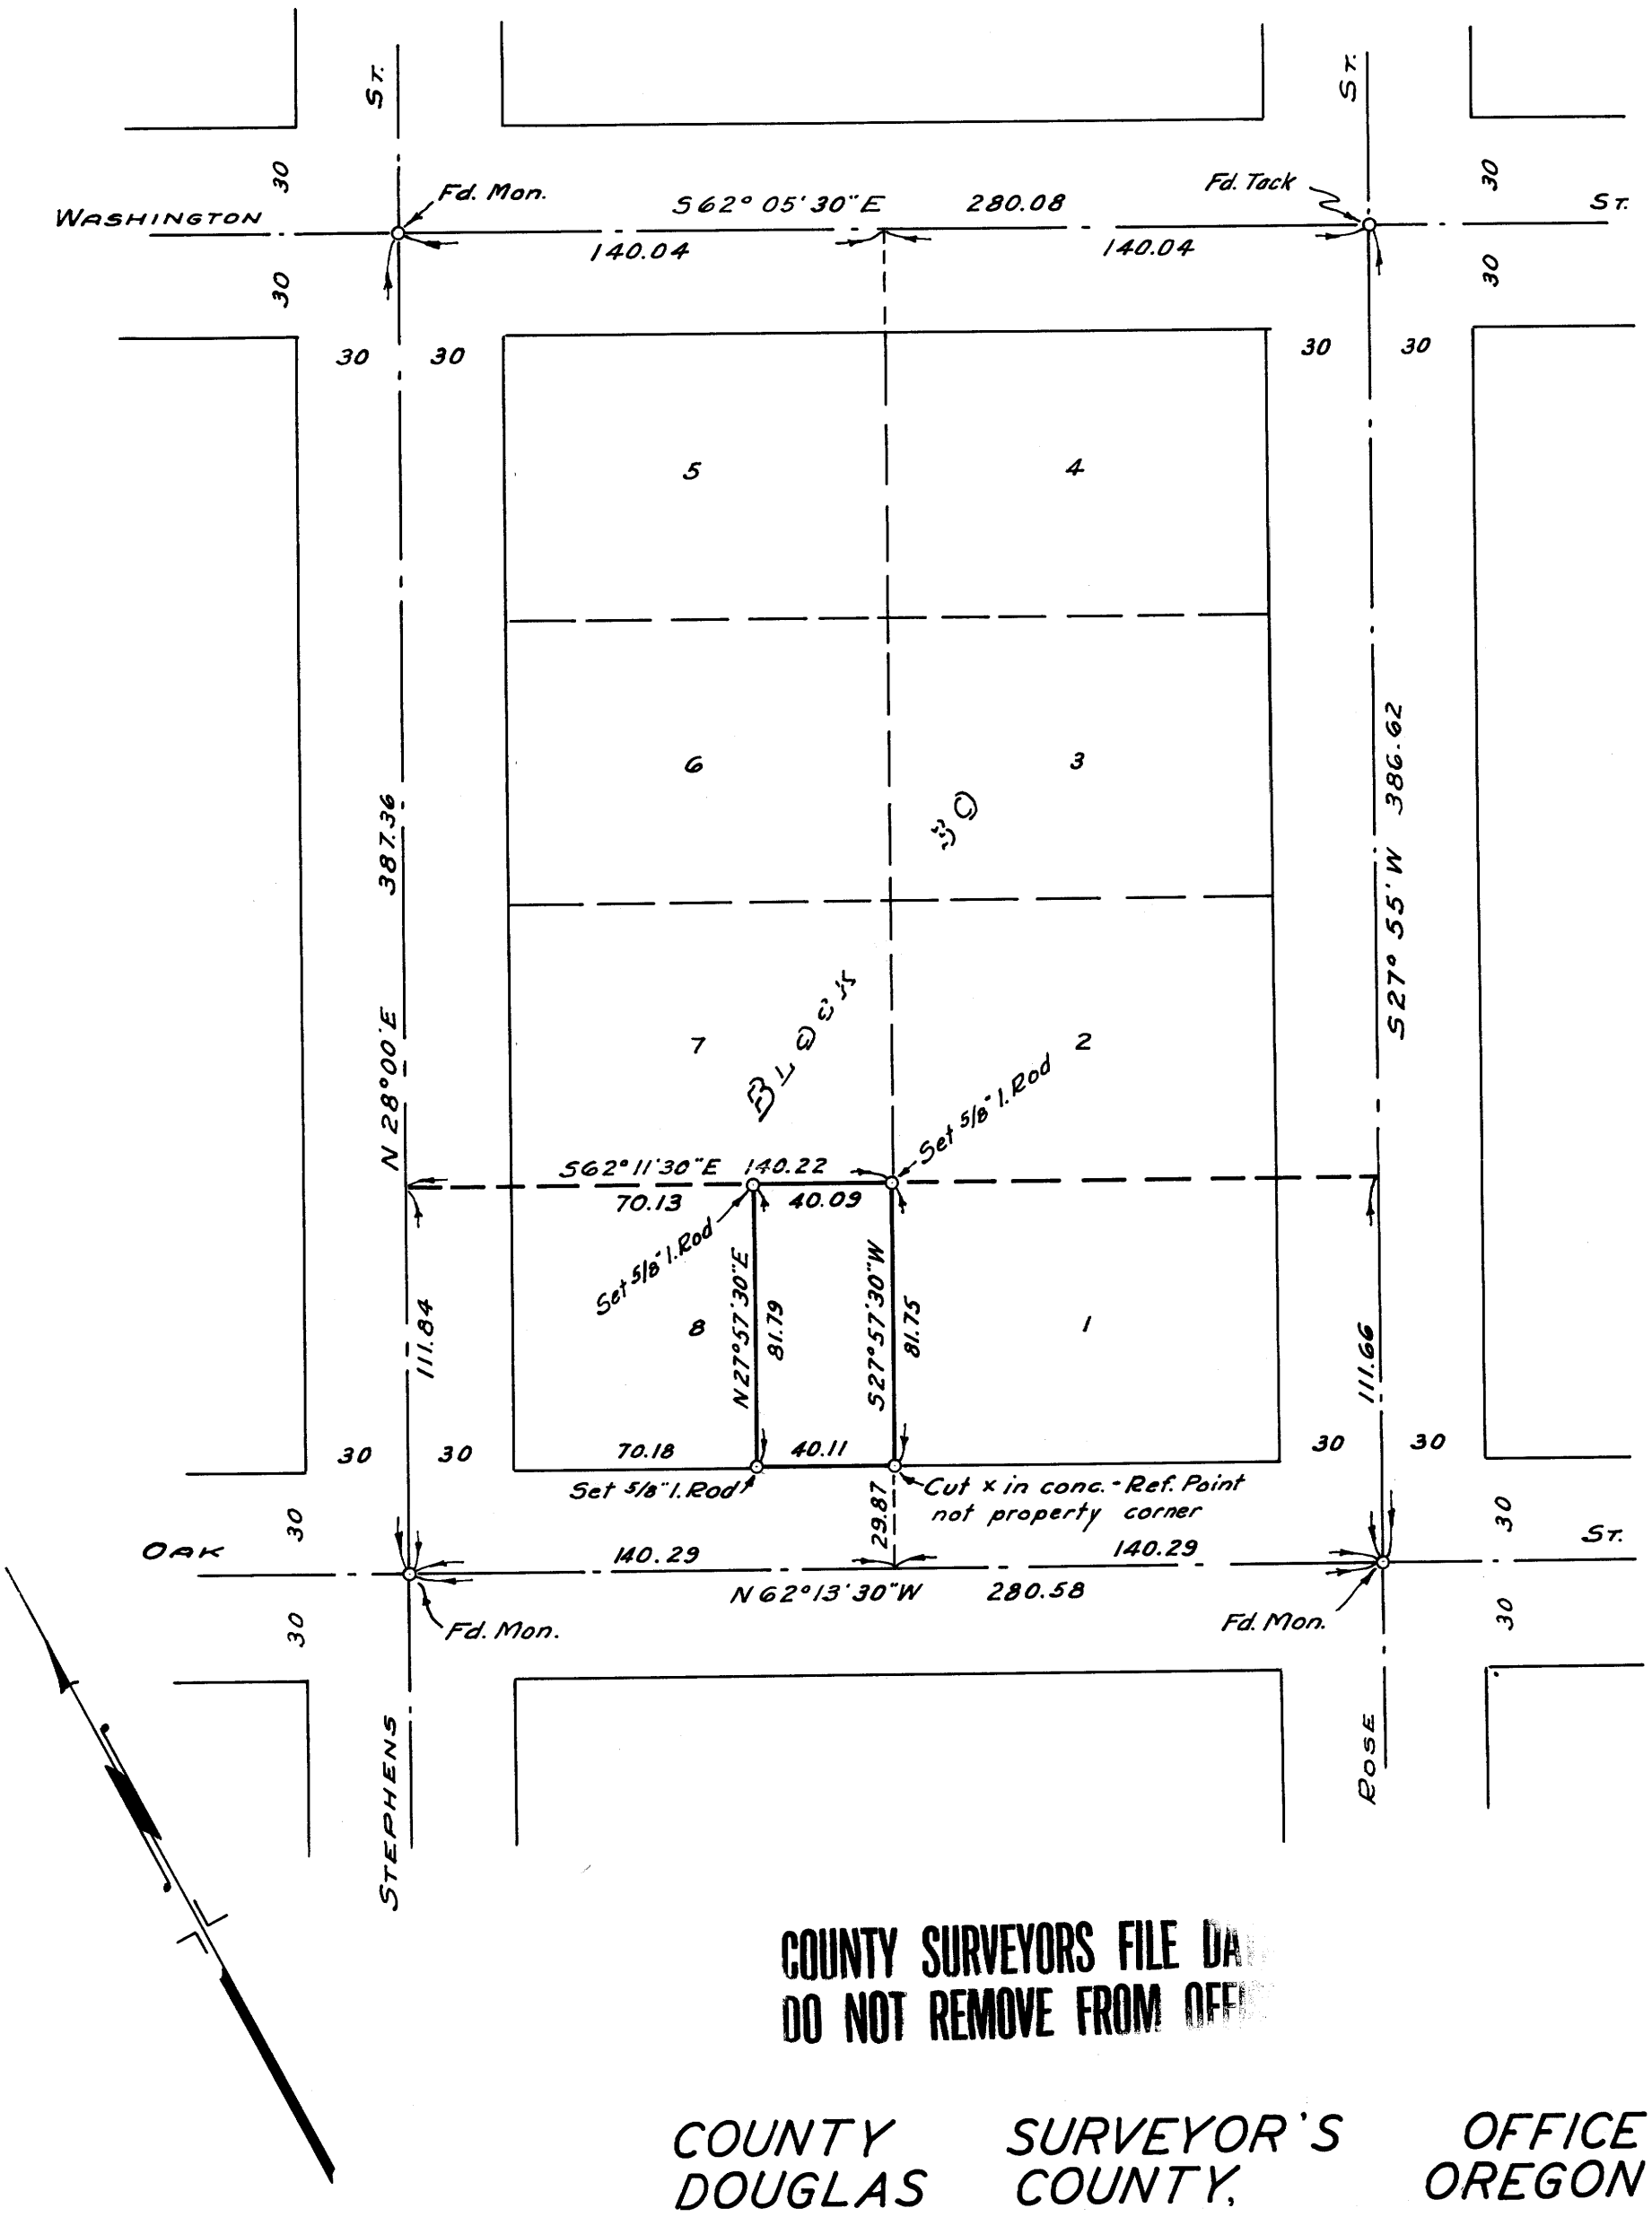

COUNTY SURVEYORS FILE DA
DO NOT REMOVE FROM OFF

COUNTY SURVEYOR'S OFFICE
DOUGLAS COUNTY, OREGON

SURVEY TO ESTABLISH CORNERS OF A PORTION OF LOT 8, BLOCK 30, CITY OF ROSEBURG.

REGISTERED PROFESSIONAL ENGINEER 2741 OREGON NOV. 7, 1947 ARTHUR R. EVANS

BEN. B. IRVING COUNTY SURVEYOR
SURVEYED APRIL 10, 1950 BY
ARTHUR R. EVANS DEPUTY
SCALE 1" = 50'

VOL. 5 PG. 33 C.S. File 44/10

Map File M 25-26

FILE IN DRAWER 44

COUNTY SURVEYOR'S OFFICE
DOUGLAS COUNTY OREGON

EAST 60 FT. LOT 4 BLOCK 30
ROSEBURG, OREGON

BEN. B. IRVING COUNTY SURVEYOR
Surveyed Feb 12 1946
N.E. RICHARDSON Deputy County Surveyor
SCALE 1" = 40'

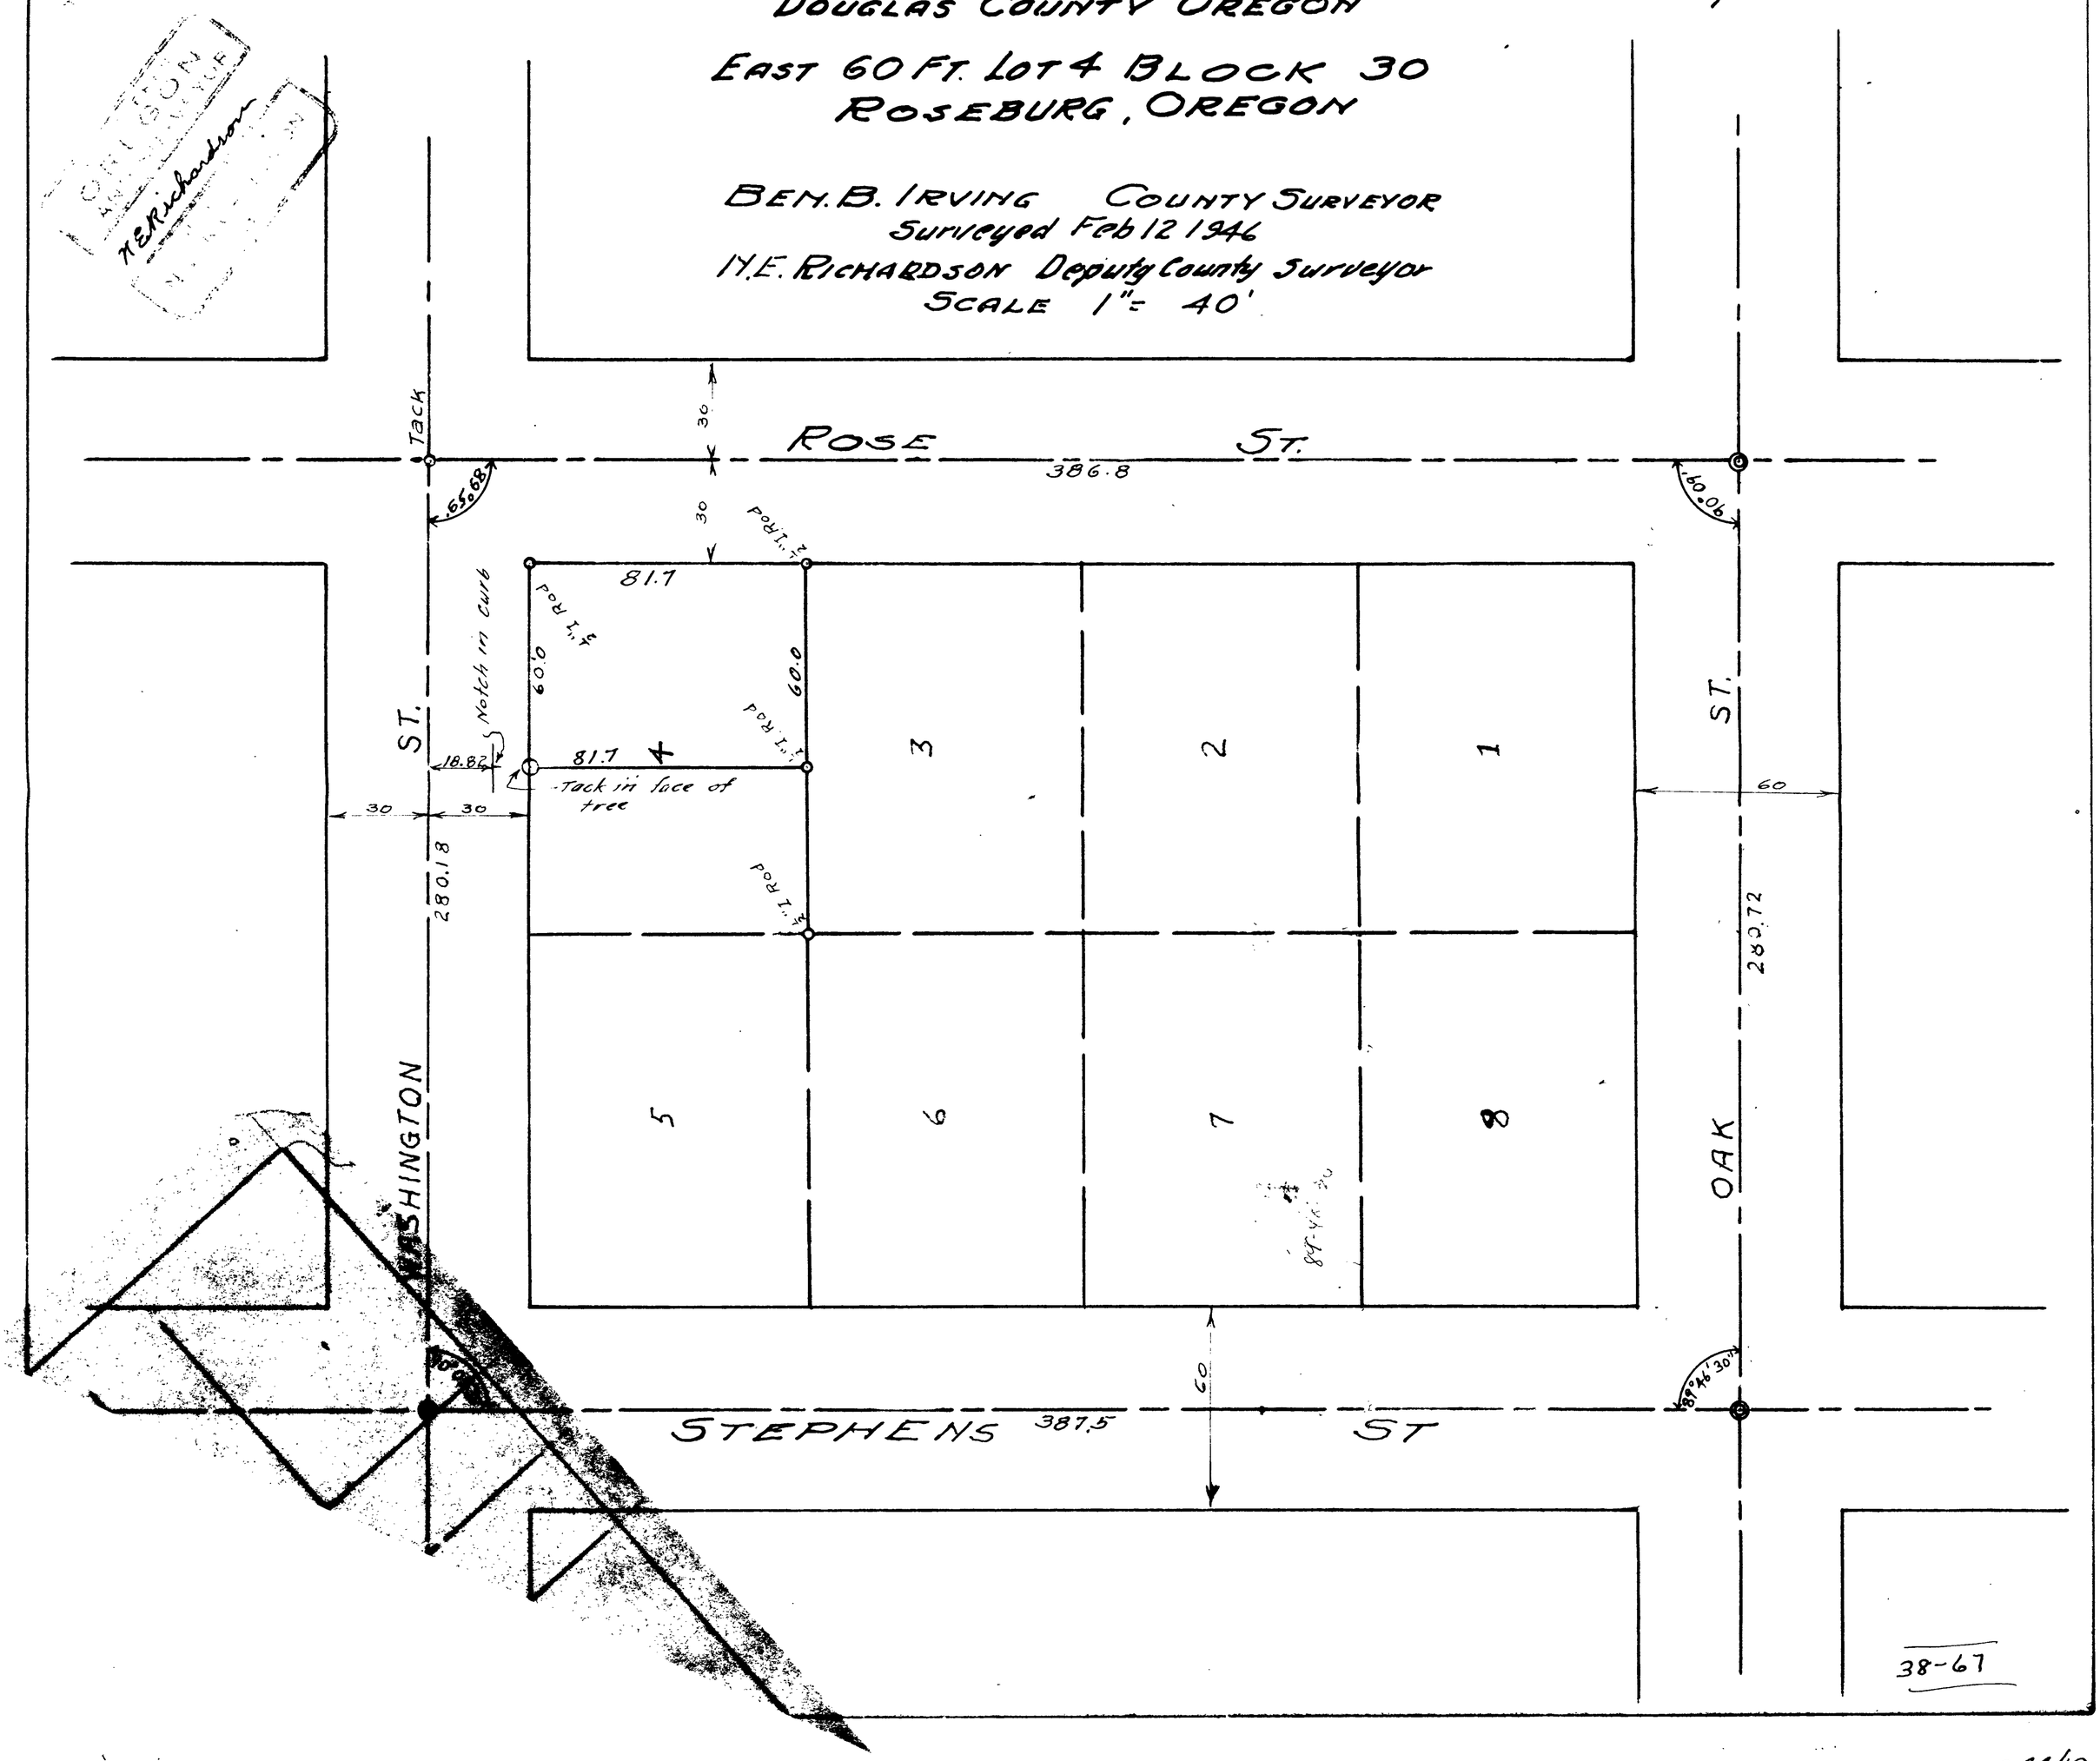

CS 44/10