M 25-36

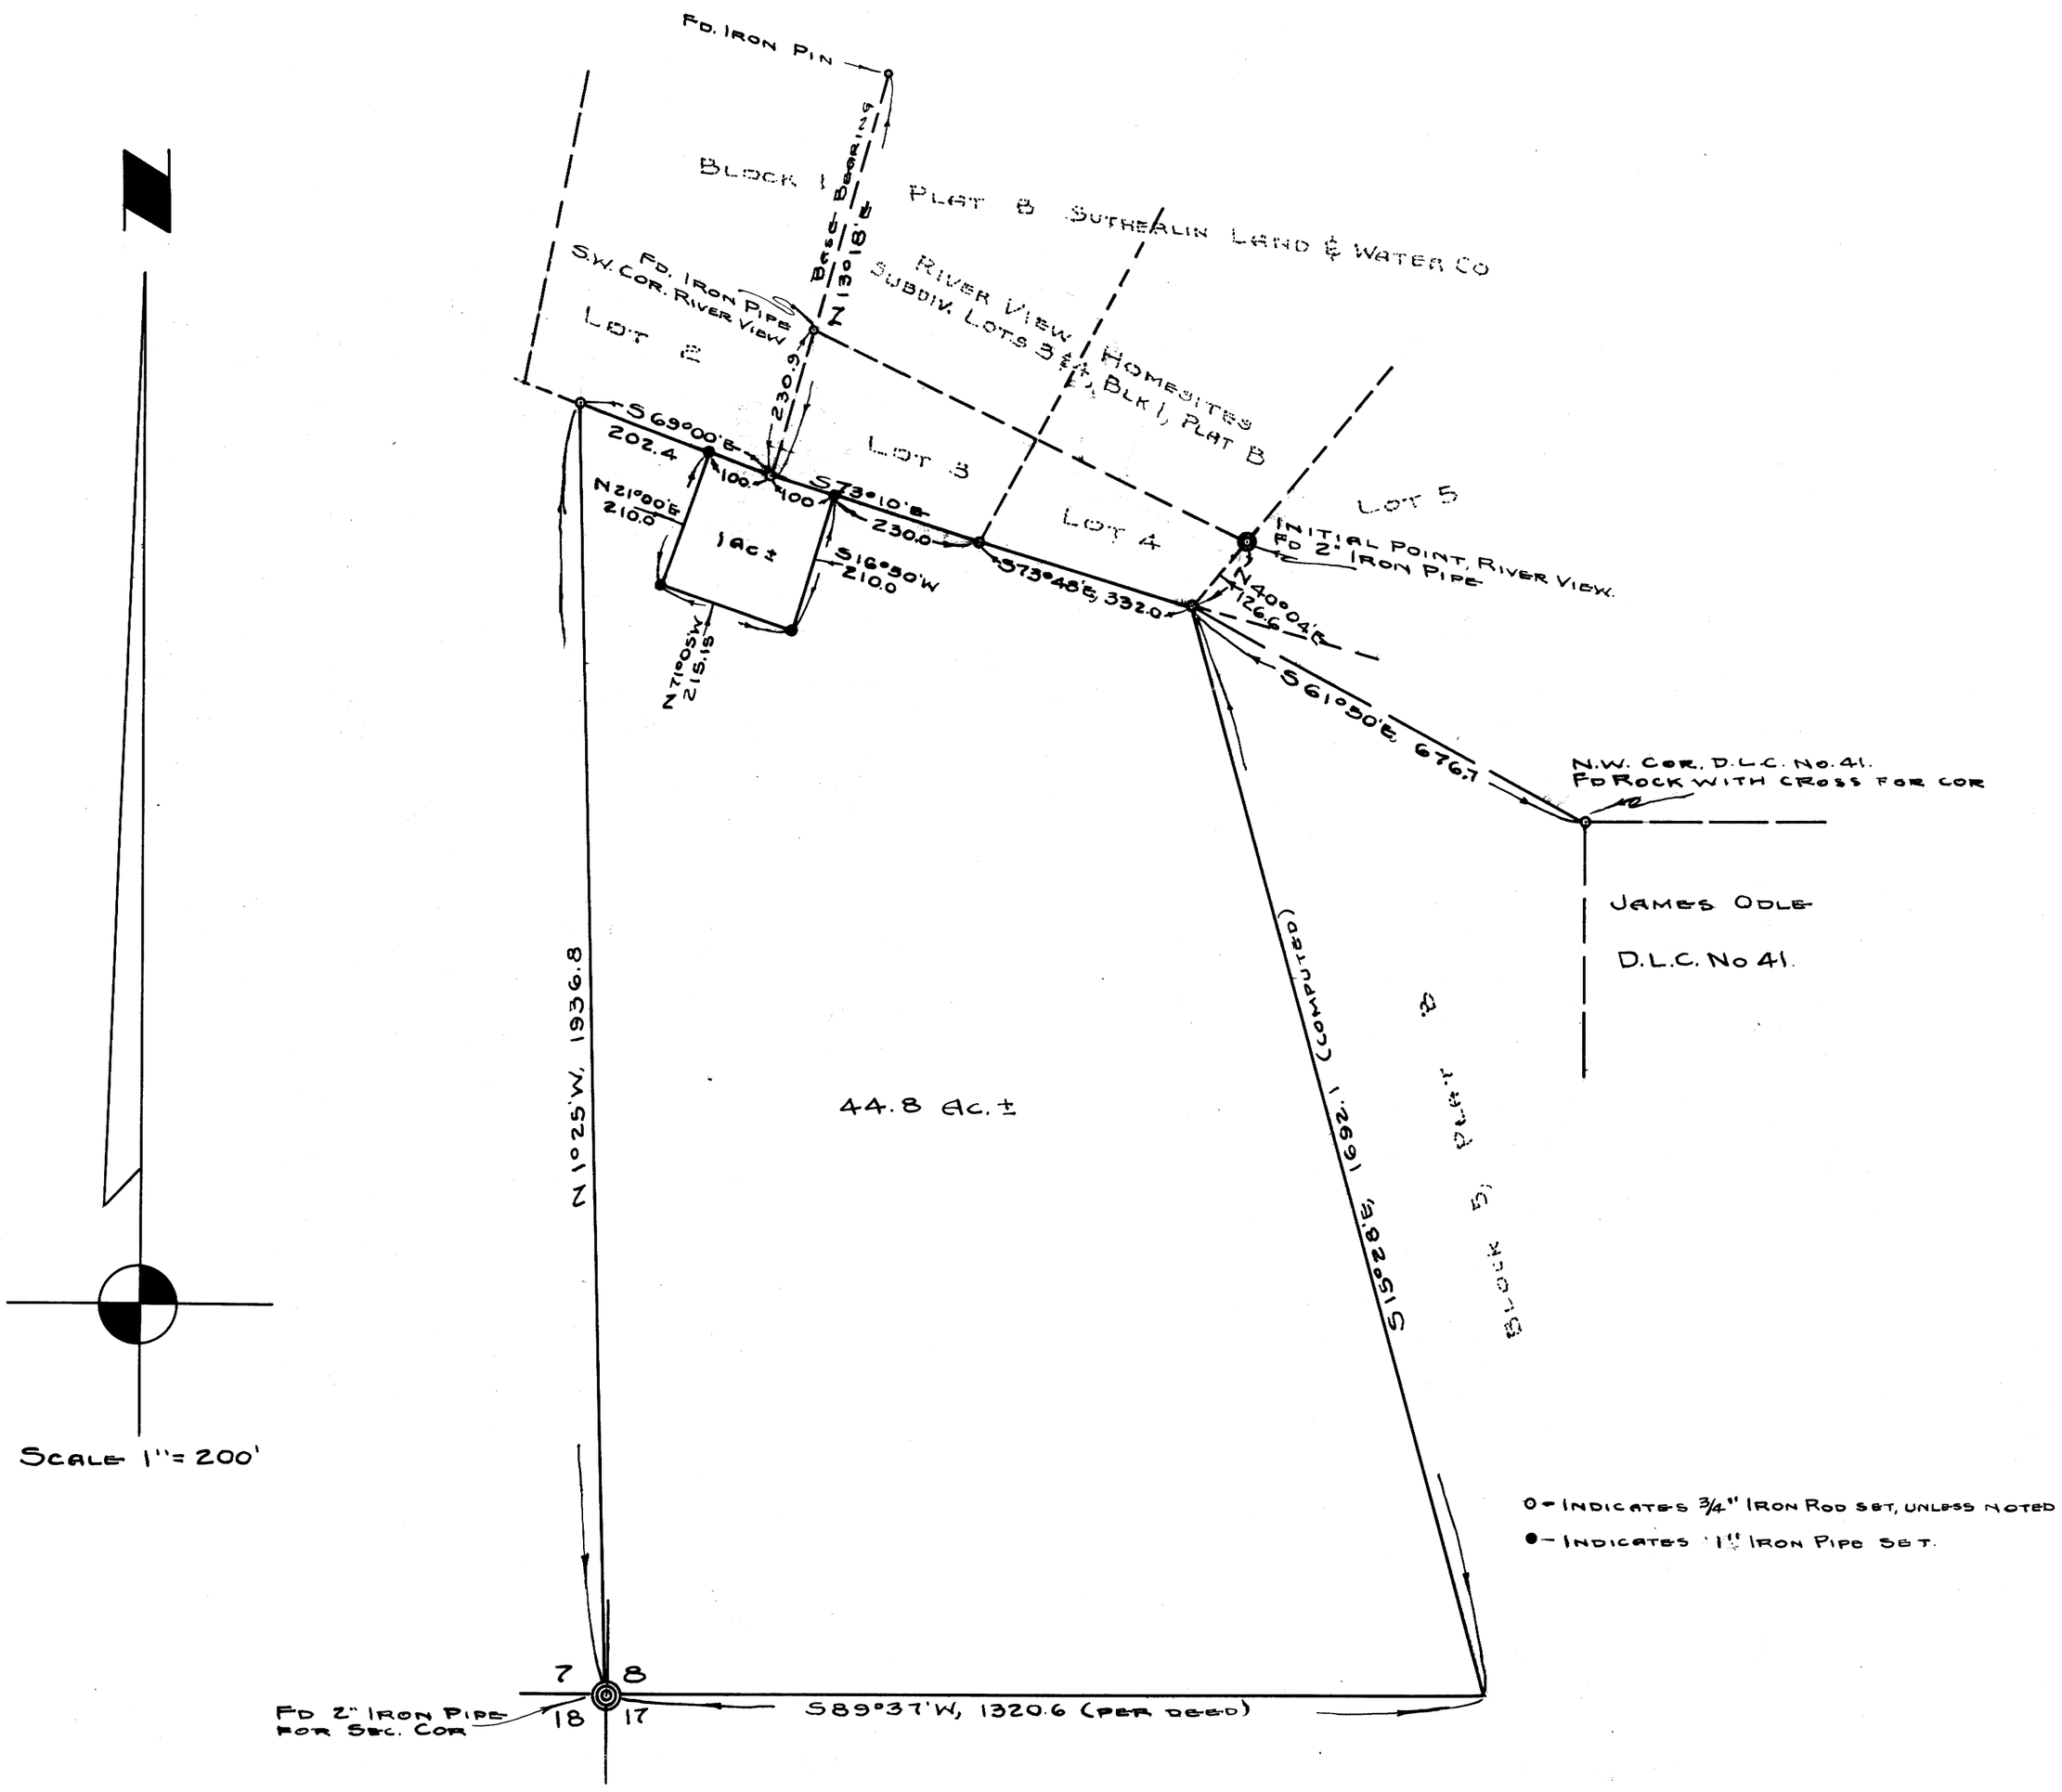

County Surveyor's Office
Douglas County Oregon
Survey for Deed Descriptions
In Sections 7 & 8, T25S, R4W. WM

REGISTERED
OREGON
LAND SURVEYOR

JULY 7, 1944
N. E. RICHARDSON
35

Ben B. Irving, C.E. County Surveyor
Surveyed, August, 1950, By
N.E. Richardson Deputy

COUNTY SURVEYORS FILE DA
DO NOT REMOVE FROM OFF

Platted, 1-18-51, By A.R. Evans, P.E. Deputy County Surveyor

C.S. File 44/80

Map File M25-36