MAP FILE M 25-62

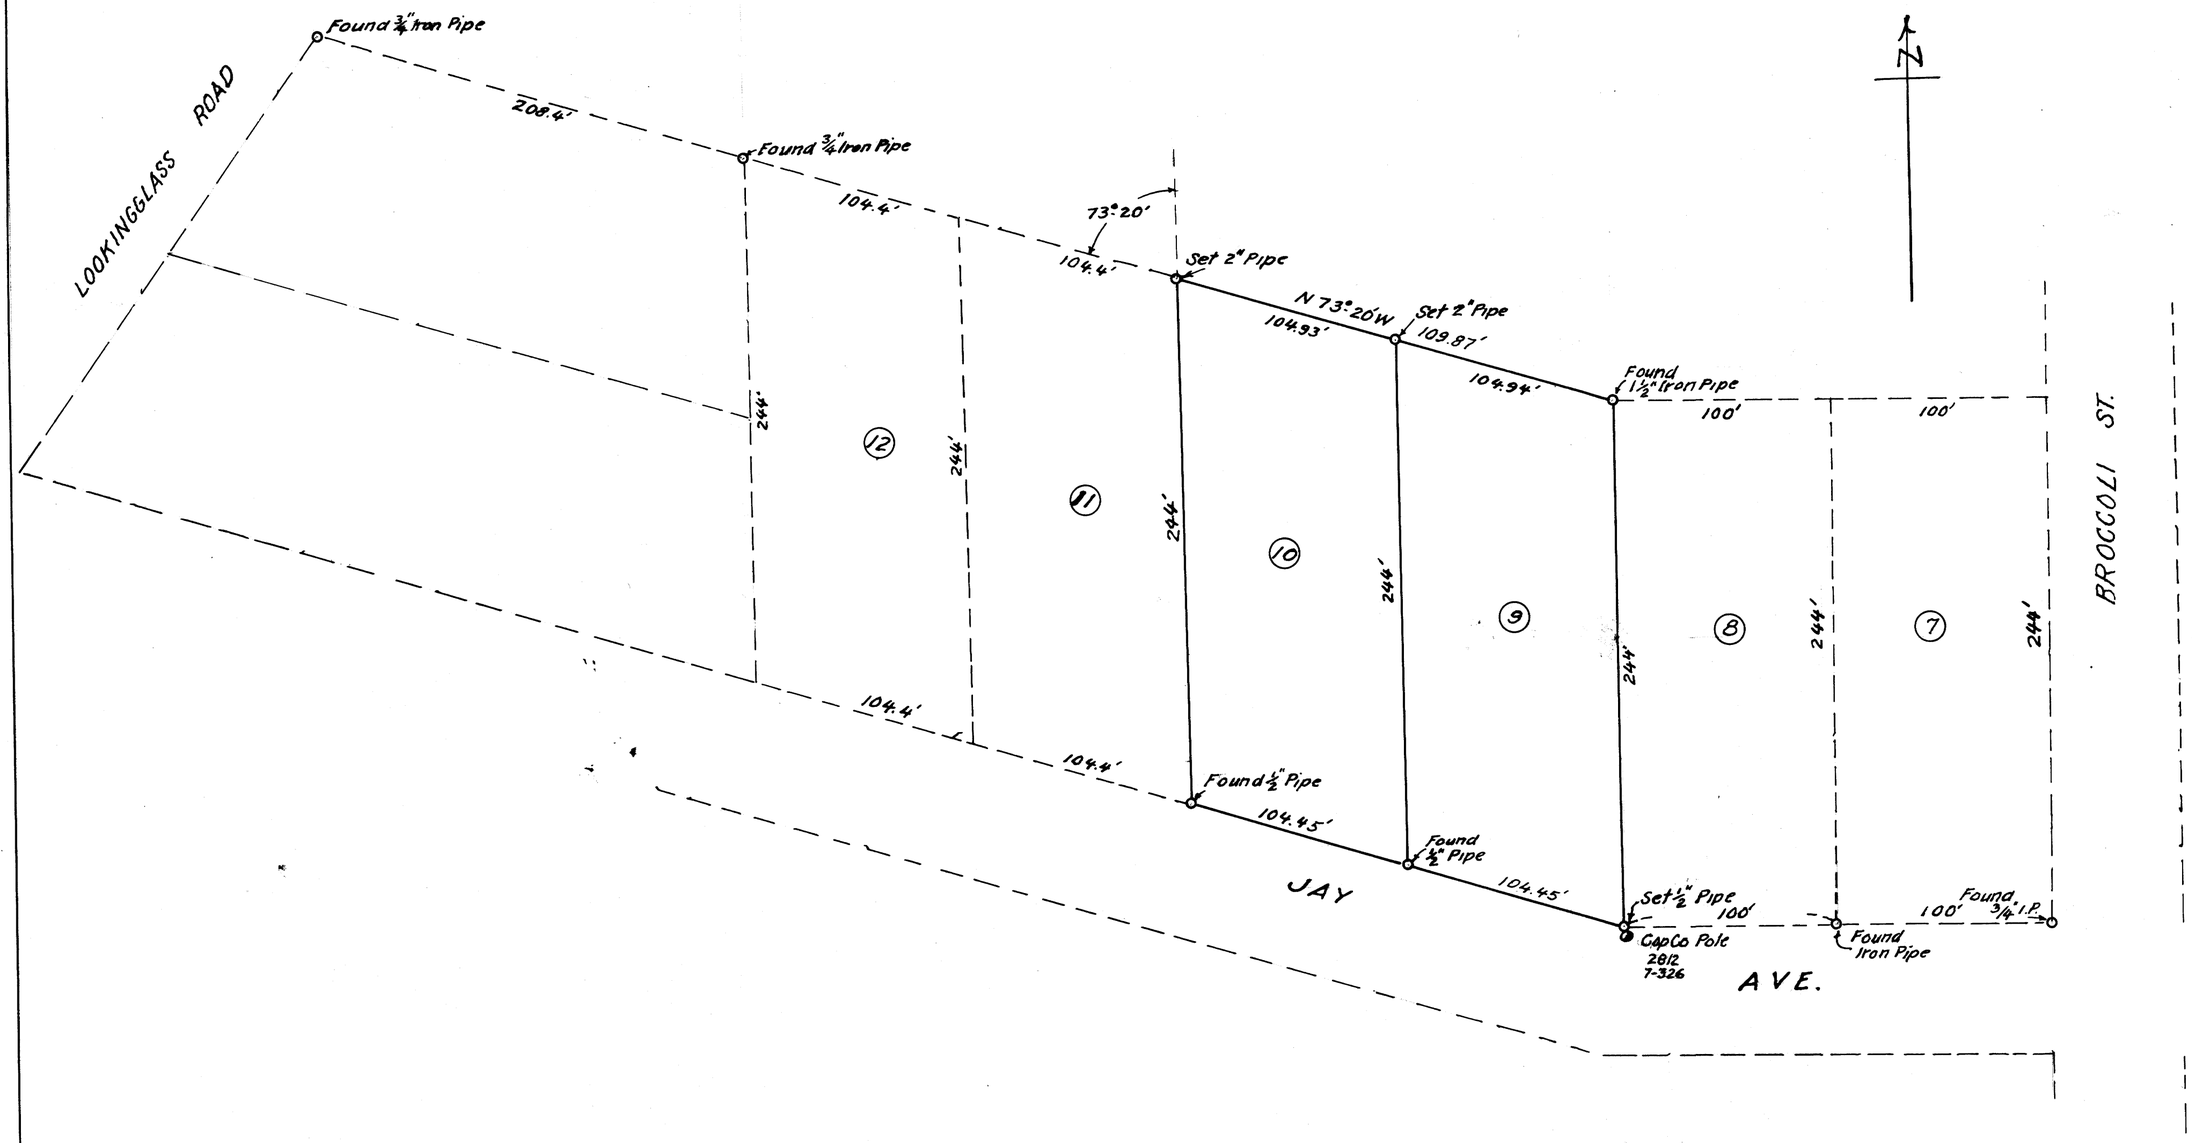

REGISTERED PROFESSIONAL ENGINEER
1587
Arthur Boyer
OREGON
MAY 5, 1933
ARTHUR BOYER

FILED
RECEIVED
MAY 22 1963
COUNTY SURVEYOR
DOUGLAS COUNTY, ORE.

LEON MULKEY
2812 W. JAY AVE. ROSEBURG, ORE.
LOTS 9 & 10 IN BLOCK 1 SHINN'S ADDN. N. OF JAY AVE
& W. OF BROCCOLI ST., ROSEBURG
SEPT. 19, 1962 AB. 1" = 50'

M 25-62

COUNTY SURVEYORS FILE DATA
DO NOT REMOVE FROM OFFICE