M 25-63

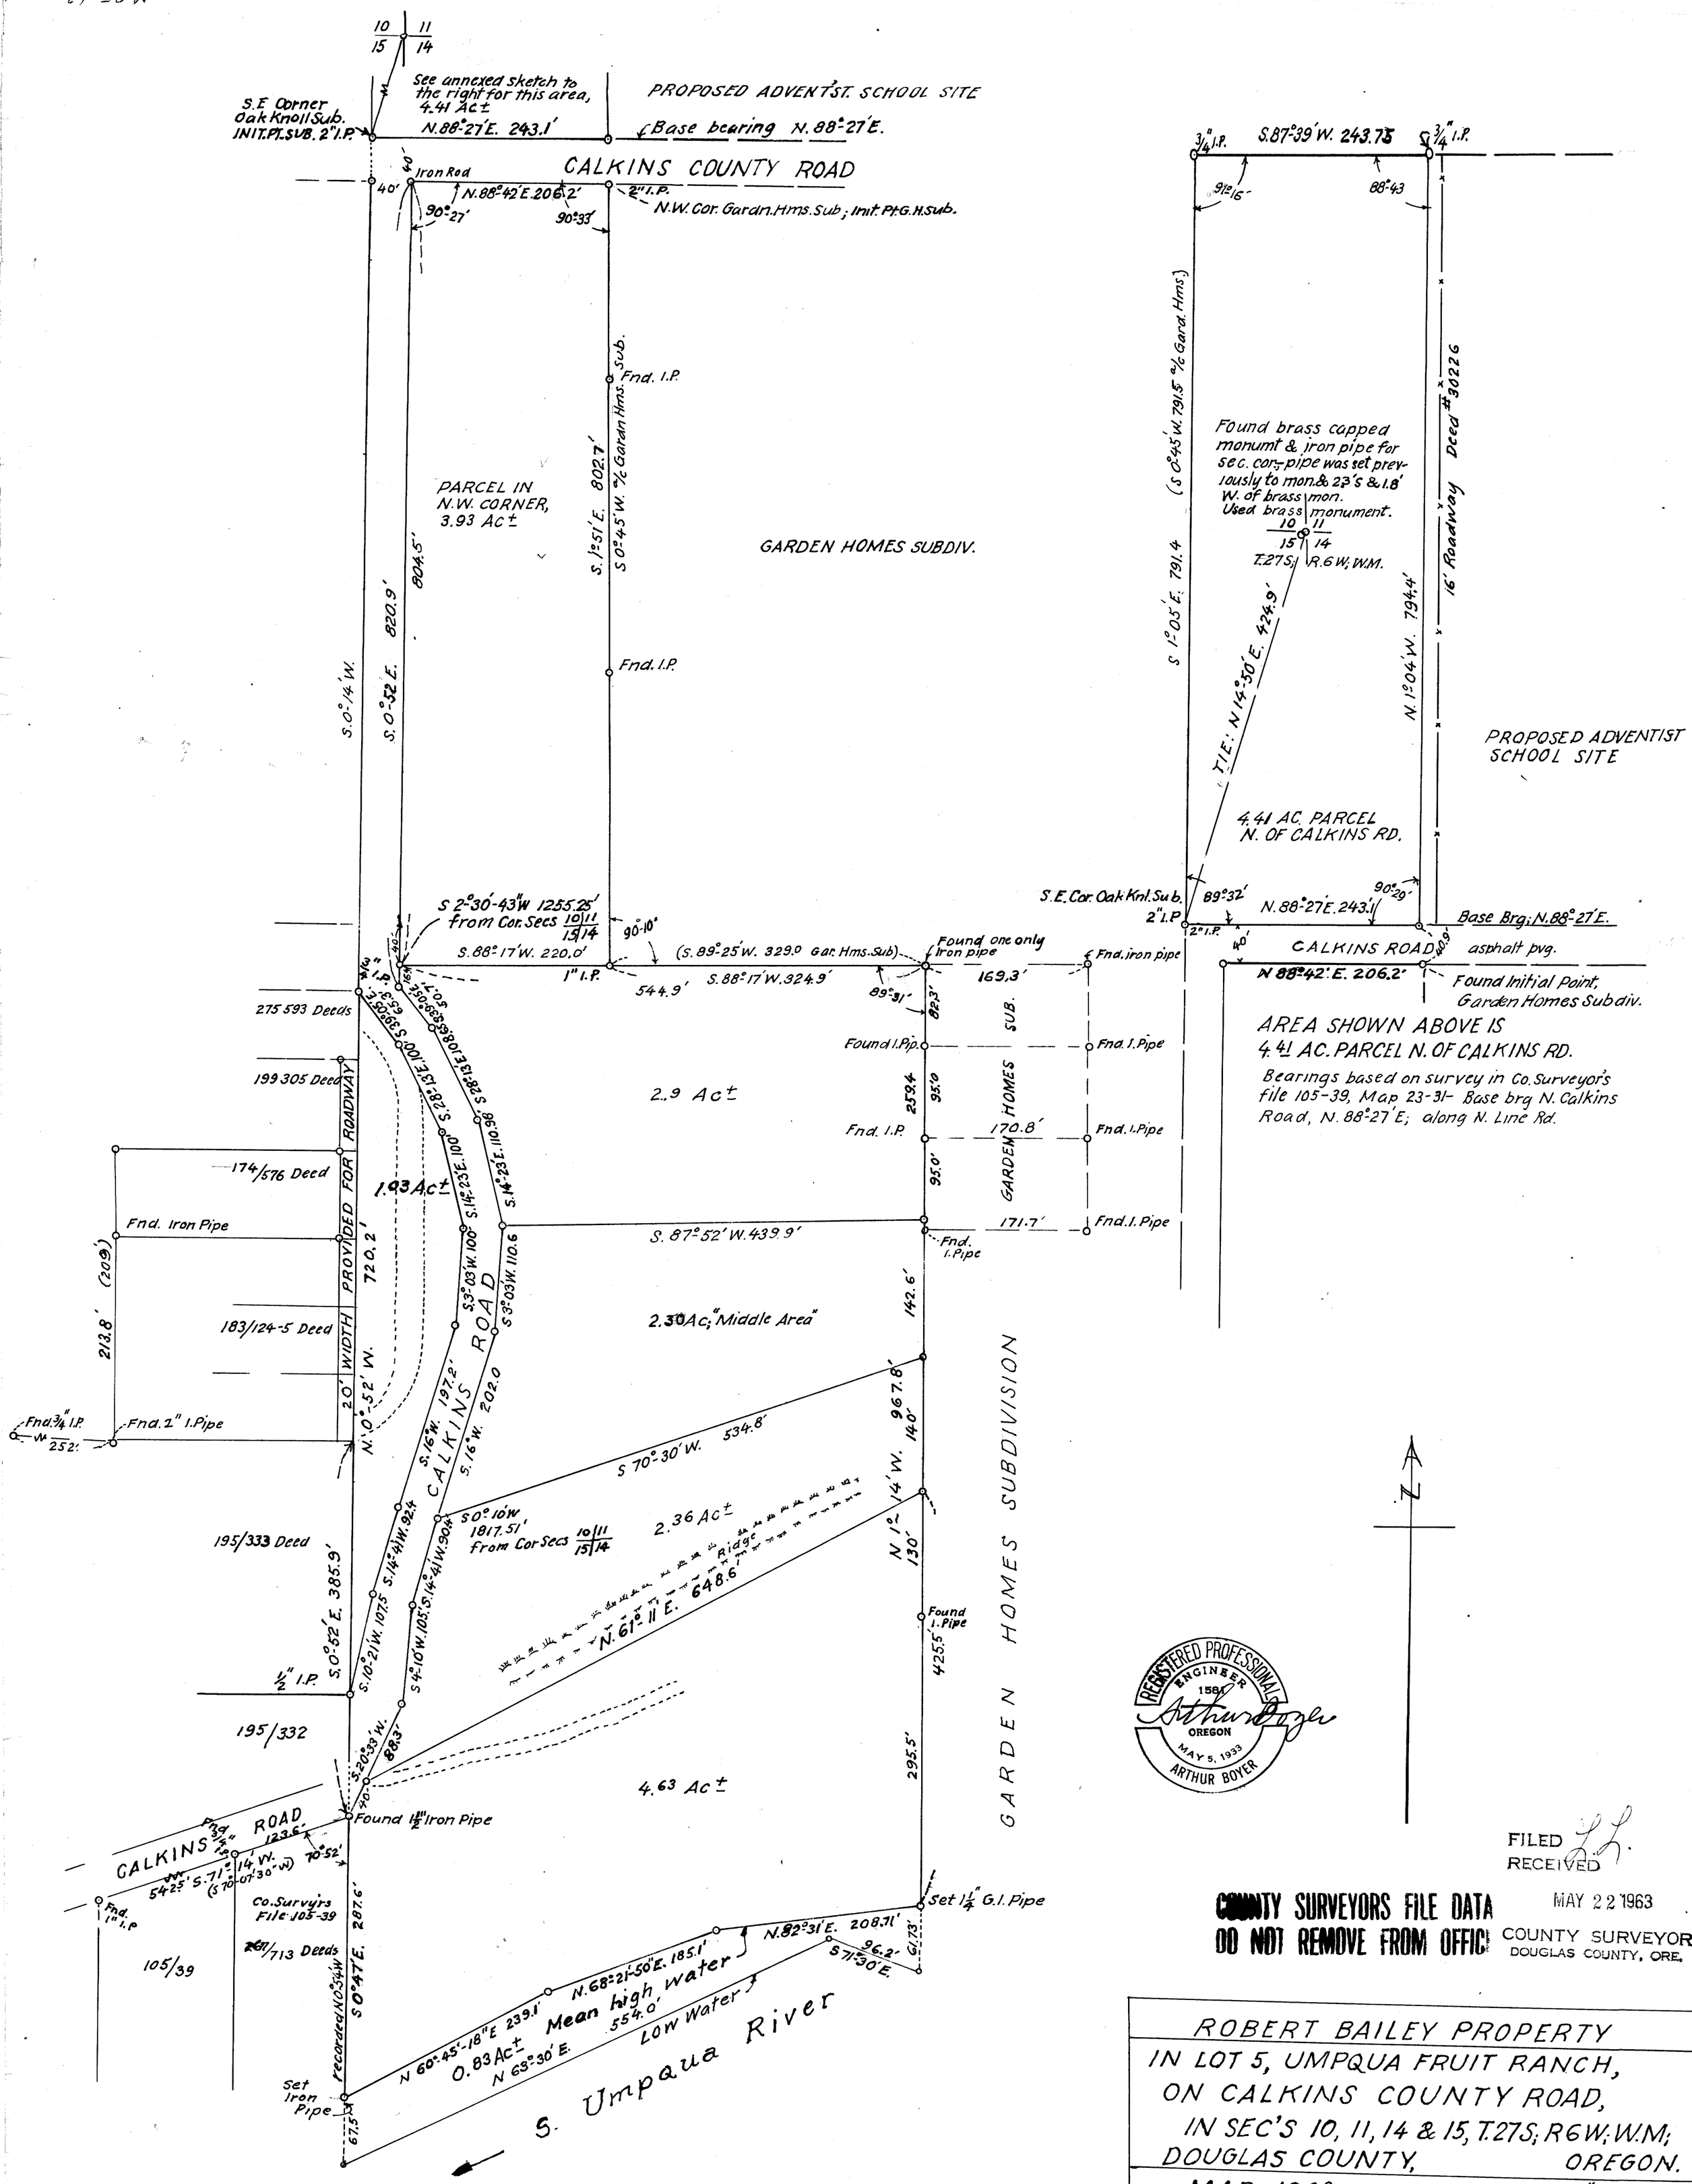

FILED
RECEIVED
MAY 22 1963
COUNTY SURVEYOR
DOUGLAS COUNTY, ORE.

COUNTY SURVEYORS FILE DATA
DO NOT REMOVE FROM OFFICE

ROBERT BAILEY PROPERTY
IN LOT 5, UMPQUA FRUIT RANCH,
ON CALKINS COUNTY ROAD,
IN SEC'S 10, 11, 14 & 15, T.27S; R6W; W.M;
DOUGLAS COUNTY, OREGON.
MAR. 1963 1" = 100 ft.
AB.

MAP FILE M 25-63