COUNTY SURVEYORS FILE DATA
DO NOT REMOVE FROM OFFICE

C.S. 40/355
M 25-72

THIS COPY MADE FROM
A XEROX 2510
DATE July 28, 89

Edwin J Woodford

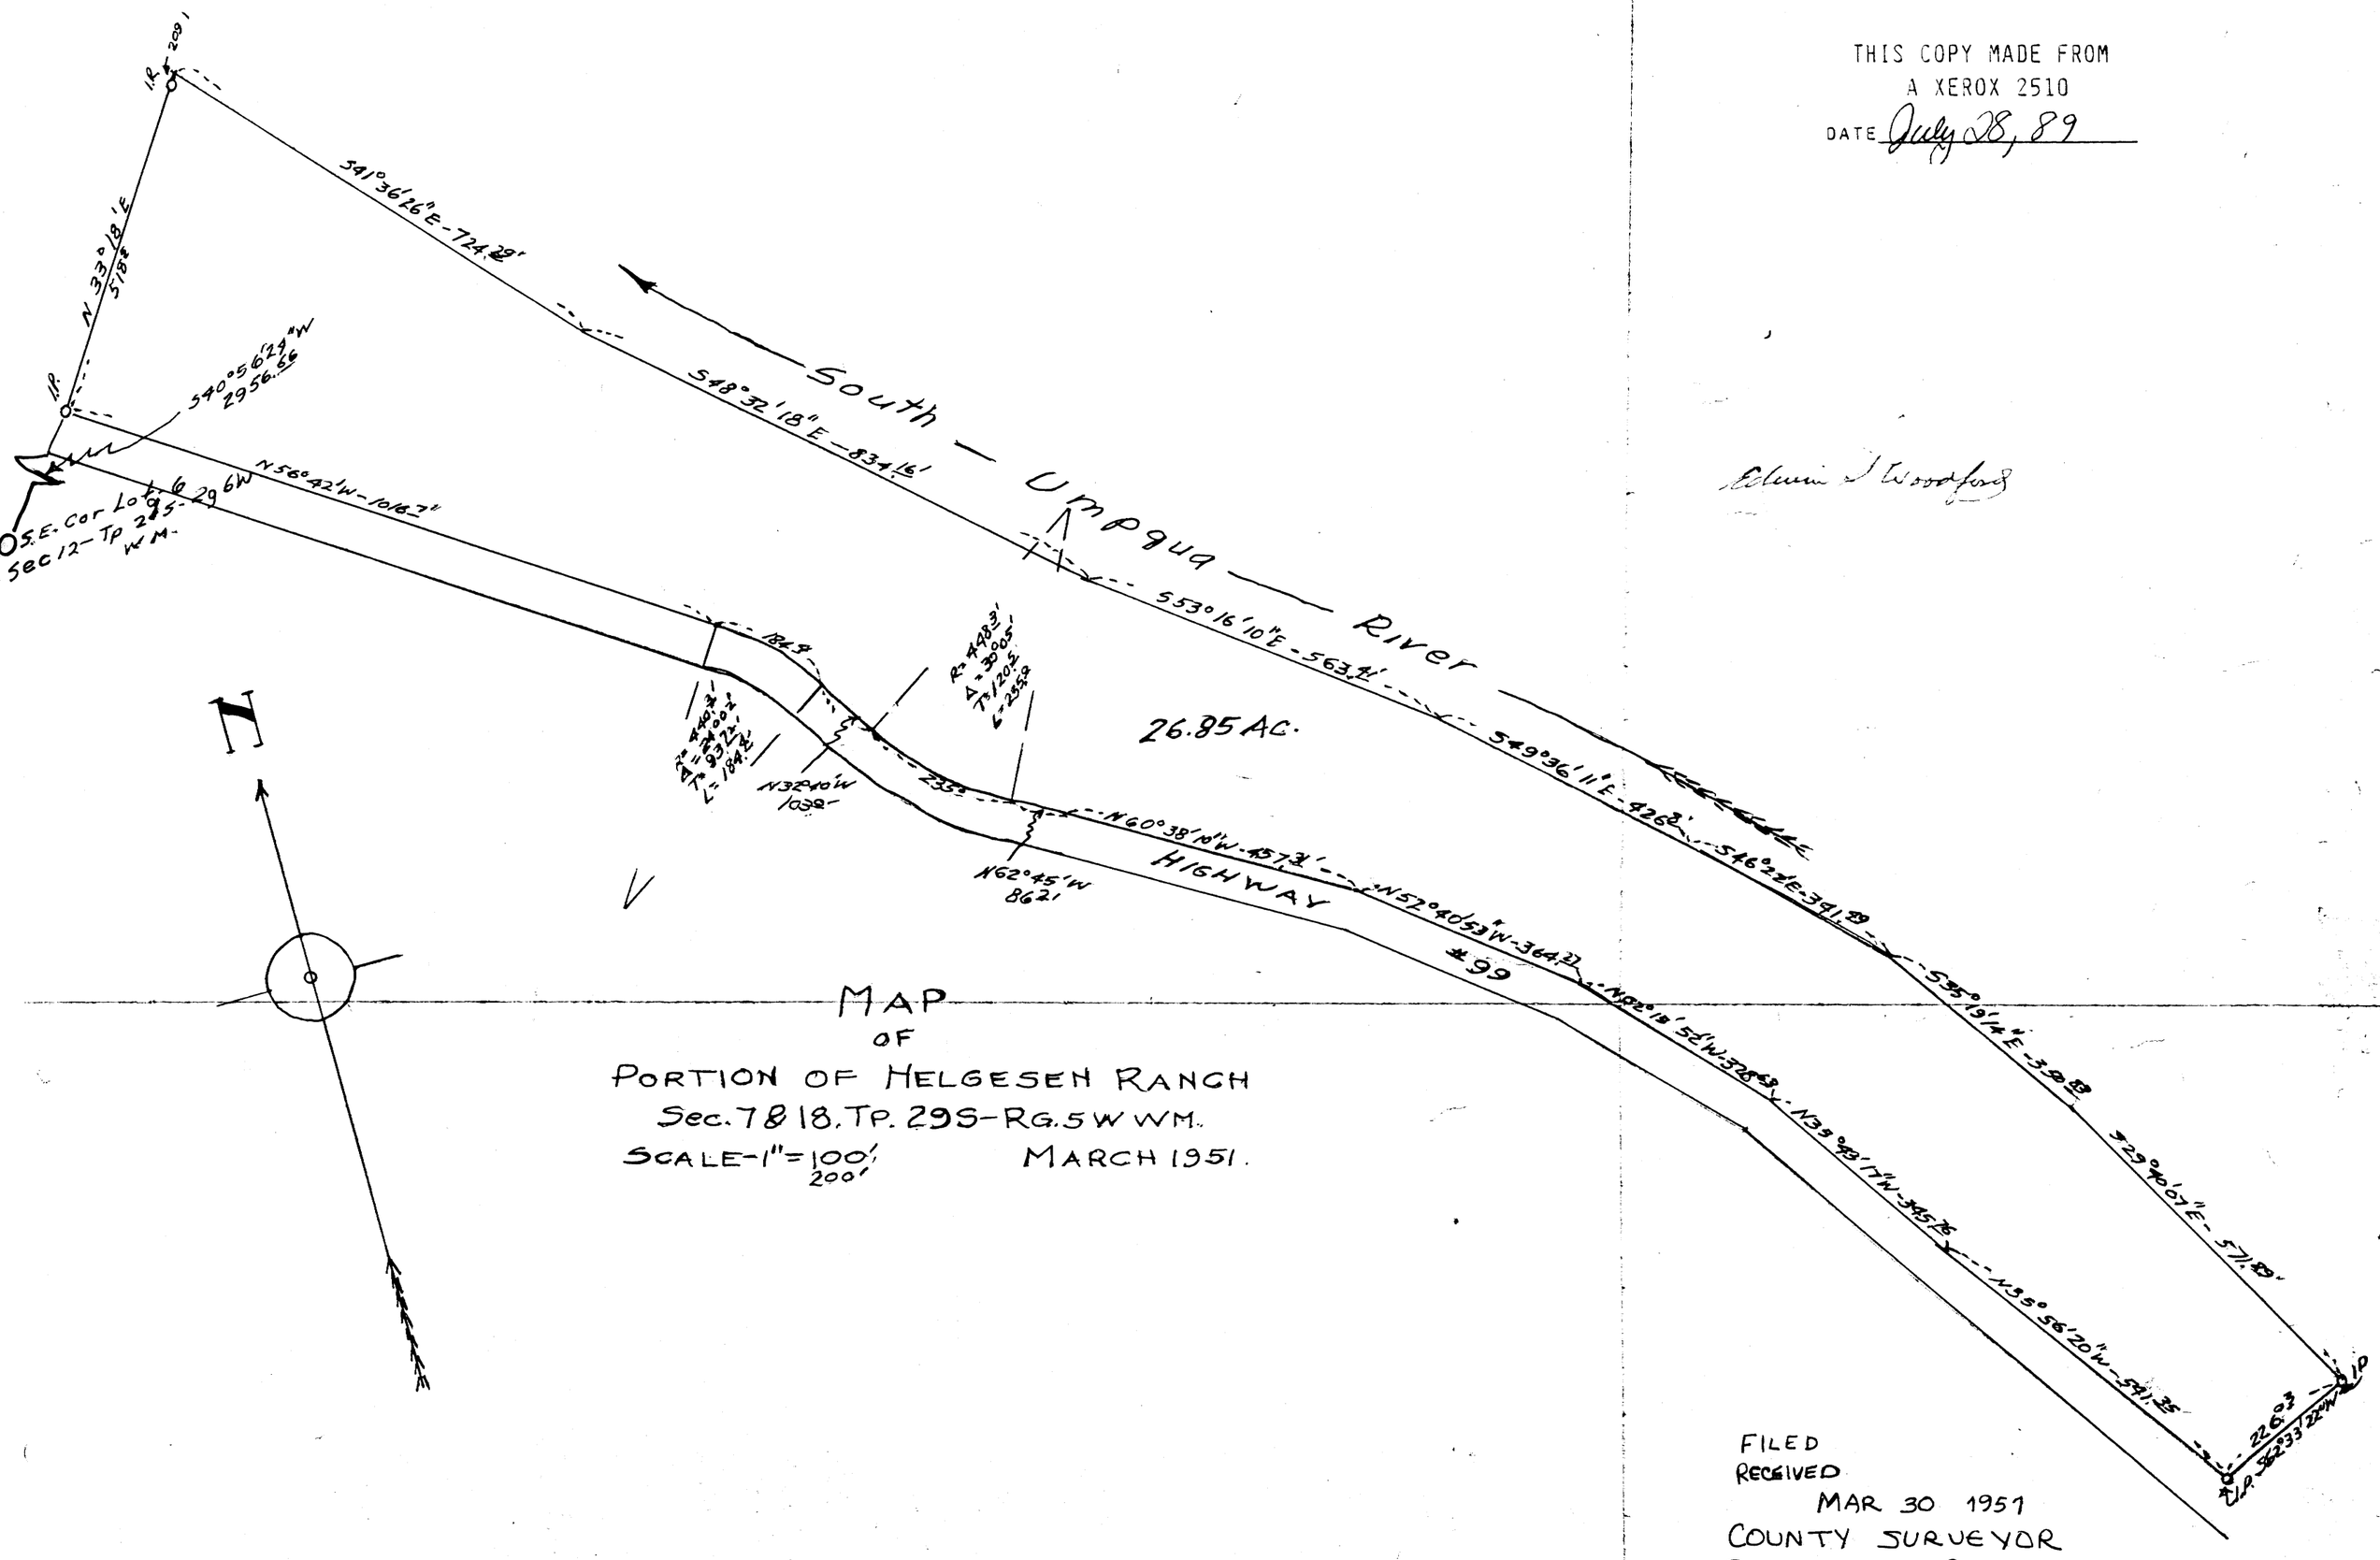

MAP
OF
PORTION OF HELGESEN RANCH
Sec. 7 & 18, TP. 29S-RG. 5W WM.
SCALE-1"=100' 200'
MARCH 1951.

FILED
RECEIVED
MAR 30 1951
COUNTY SURVEYOR
Douglas County, Ore.

C.S. 40/355
M 25-72