C.S. FILE 53/30
M 26-22

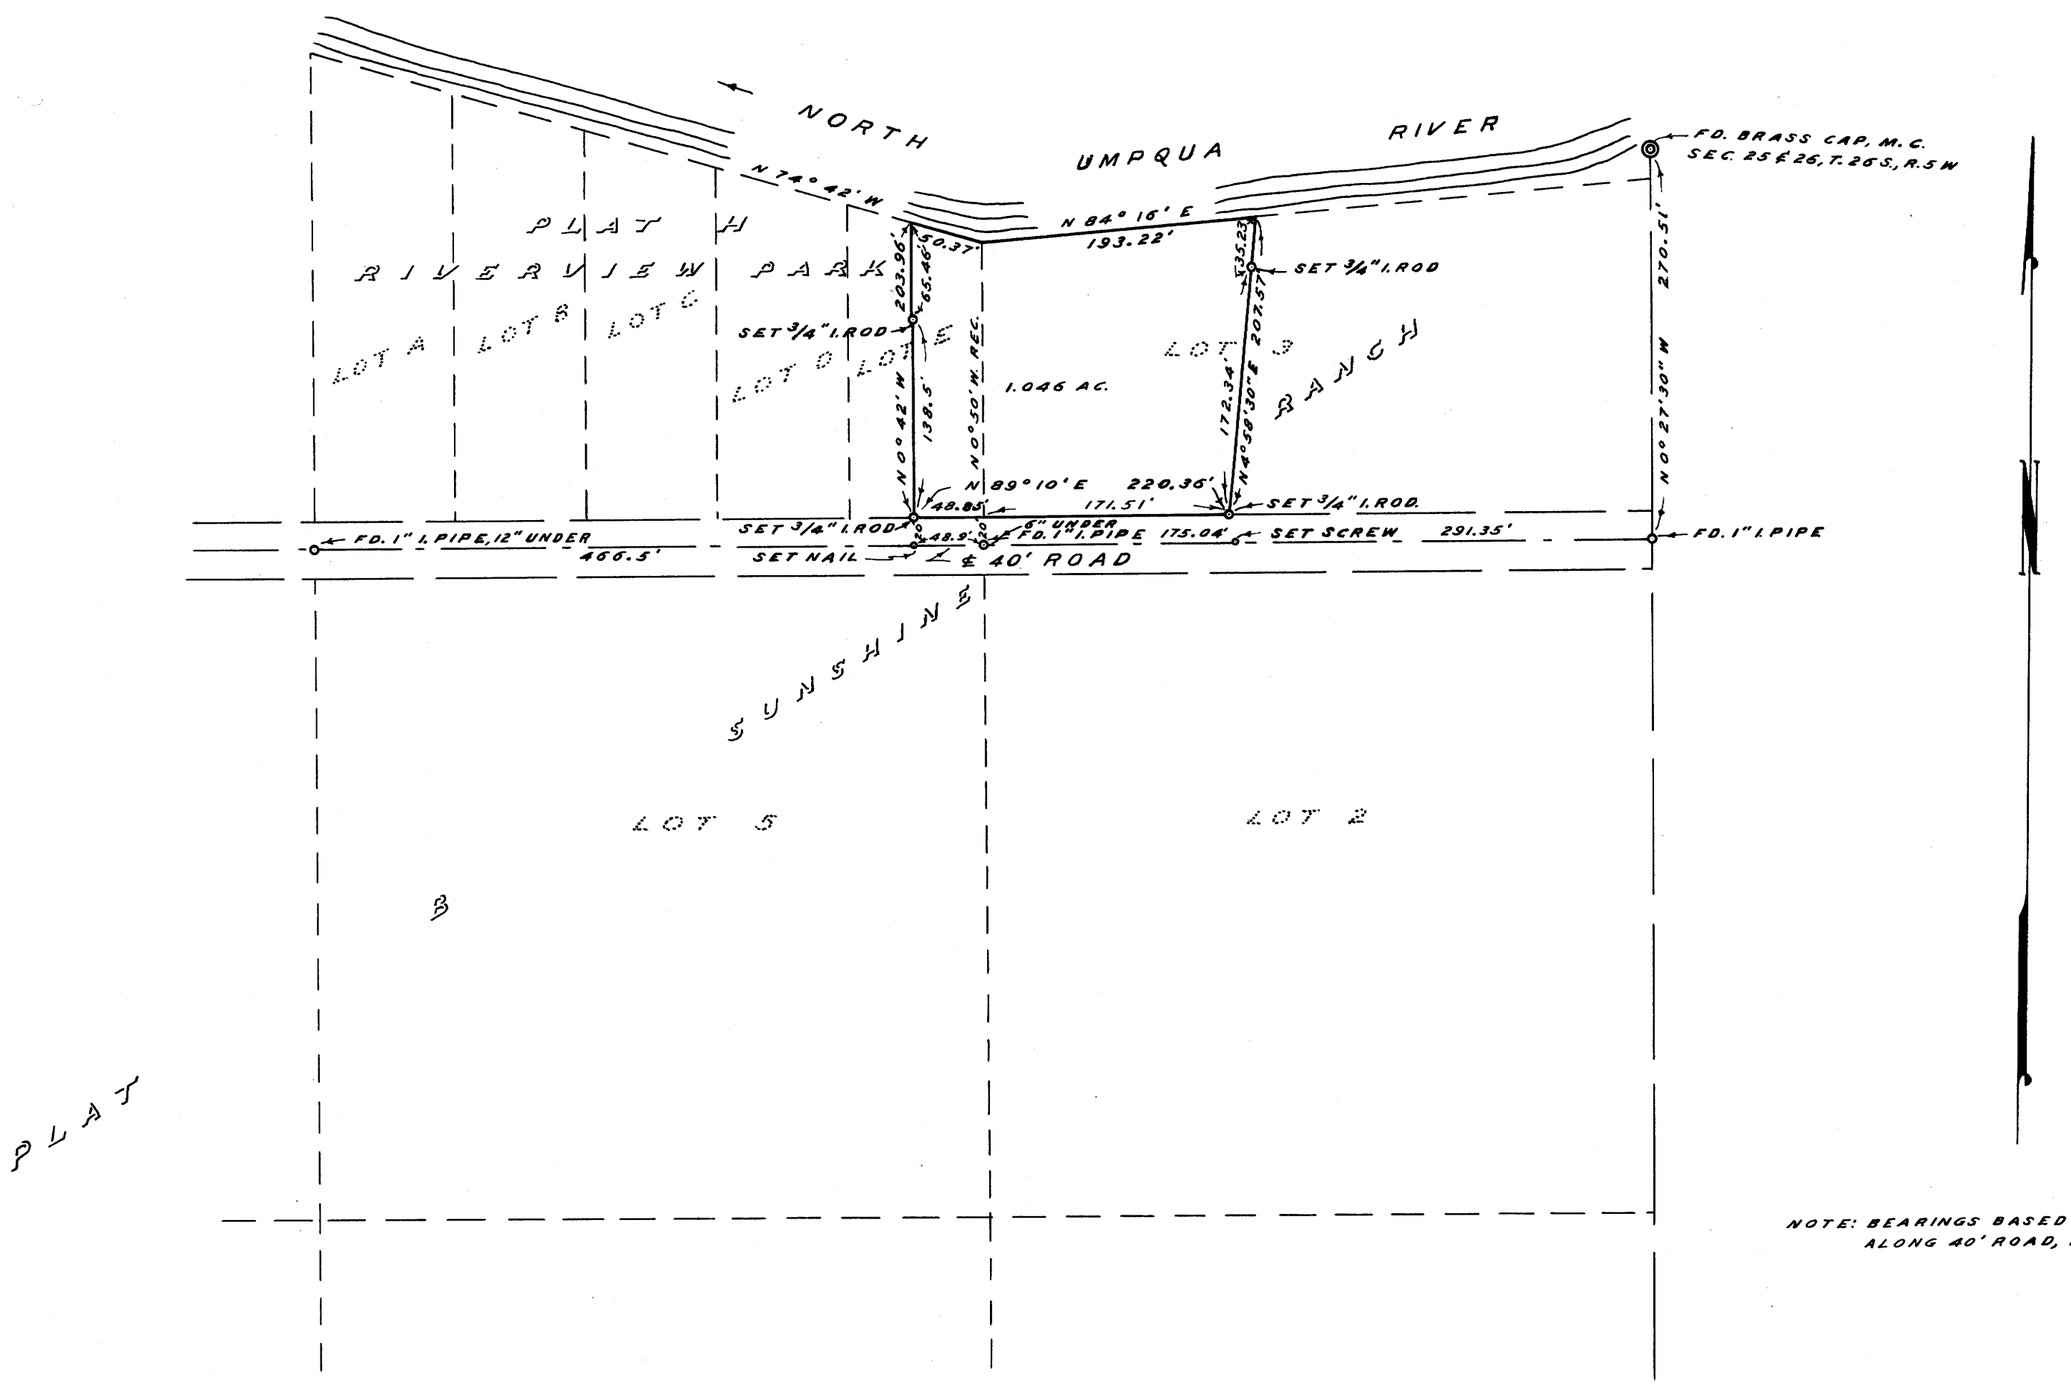

NOTE: BEARINGS BASED ON N 89° 10' E ALONG 40' ROAD, PER REC.

COUNTY SURVEYORS FILE DA
DO NOT REMOVE FROM OFF

SURVEY FOR DEED DESCRIPTION IN PLAT H, RIVERVIEW PARK & PLAT B, SUNSHINE RANCH, IN T.26S., R.5W., W. M.

SURVEYED JULY 13, 1963 BY
JAMES W. BYRON SCALE 1" = 100'
SURVEYED FOR FRANK STRADER

REGISTERED
OREGON
LAND SURVEYOR
James W. Byron
NOV. 6, 1953
JAMES W. BYRON
303

FILED
RECEIVED
JUL 22 1963
COUNTY SURVEYOR
DOUGLAS COUNTY, ORE.

C.S. FILE 53/30
M26-22