


NOTE: ALL BEARINGS CALCULATED FROM ANGLES TURNED IN DEFLECTION FROM MERIDIAN ESTABLISHED BY SOLAR OBSERVATION TAKEN DURING COURSE OF THIS SURVEY

**COUNTY SURVEYOR'S OFFICE
DOUGLAS COUNTY OREGON
SURVEY FOR DEED DESCRIPTION
SECTION 33, T29S, R5W.W.M.**

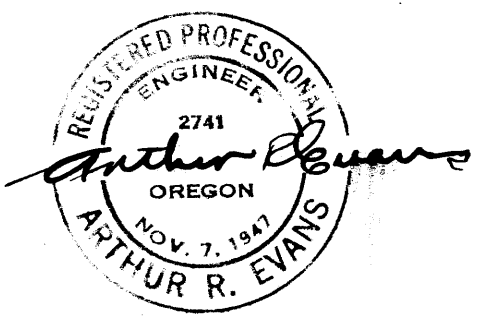

BEN B. IRVING COUNTY SURVEYOR
SURVEYED 9-24-49 BY
A.R. EVANS, DEPUTY COUNTY SURVEYOR
SCALE 1" = 60'

COUNTY SURVEYORS FILE DATA
DO NOT REMOVE FROM OFFICE