M26-41

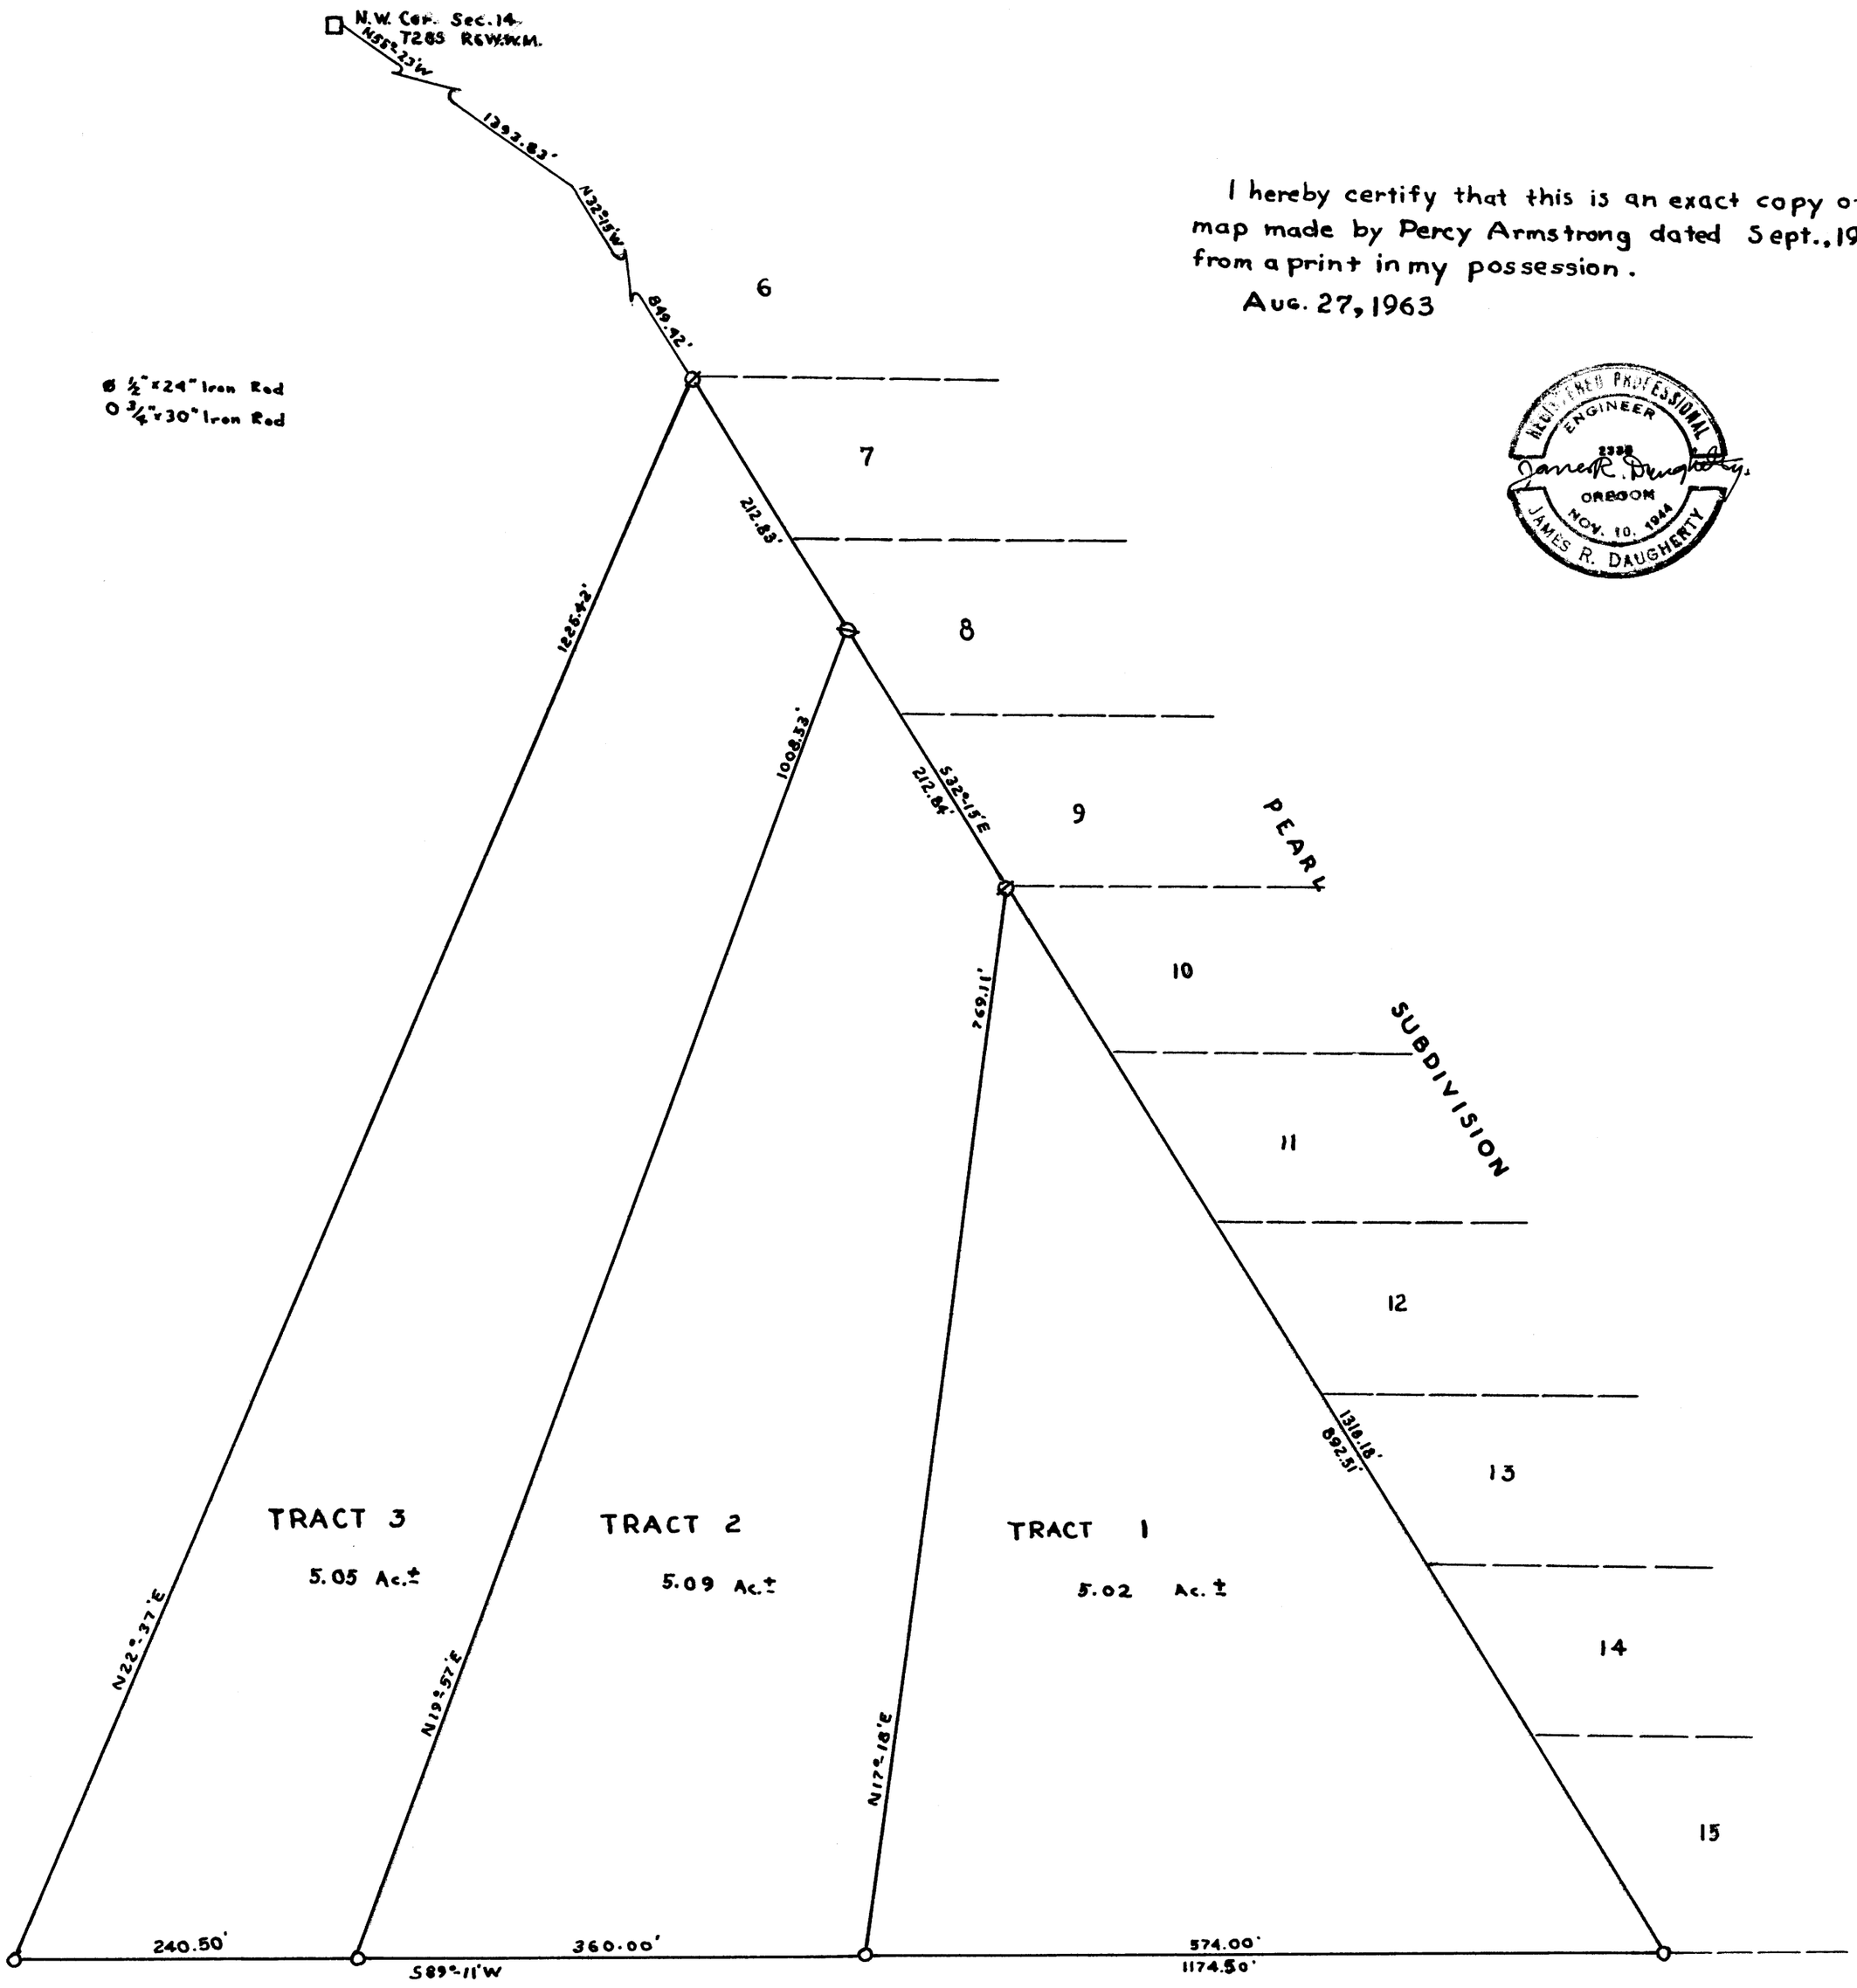

⊗ ½"×24" Iron Rod
O ¾"×30" Iron Rod

I hereby certify that this is an exact copy of a map made by Percy Armstrong dated Sept., 1949 from a print in my possession.
Aug. 27, 1963

REGISTERED PROFESSIONAL ENGINEER 2338 OREGON NOV. 10, 1944 JAMES R. DAUGHERTY

PLAT OF PART OF

CHARLES WHITE PROPERTY

IN SEC. 14, T28S - R6W - W.M. - DOUGLAS COUNTY, OREGON

SEPTEMBER, 1949

SCALE 1"=100'

COUNTY SURVEYORS FILE
DO NOT REMOVE FROM

FILED
RECEIVED
AUG 28 1963
COUNTY SURVEYOR
DOUGLAS COUNTY, ORE.

MAP FILE M26 + 41