COUNTY SURVEYORS FILE DO
DO NOT REMOVE FROM OFF

C.S. FILE 41/145
M26-45

SURVEY TO ESTABLISH SUBDIVISIONAL LINES E½, SEC. 32, T29½S, R7W. WM

GRANT AND EVANS, ENGINEERS
ROSEBURG, OREGON
SURVEYED, MARCH 1953, SCALE 1" = 400'

REGISTERED PROFESSIONAL ENGINEER 2741 OREGON NOV. 7, 1947 ARTHUR R. EVANS

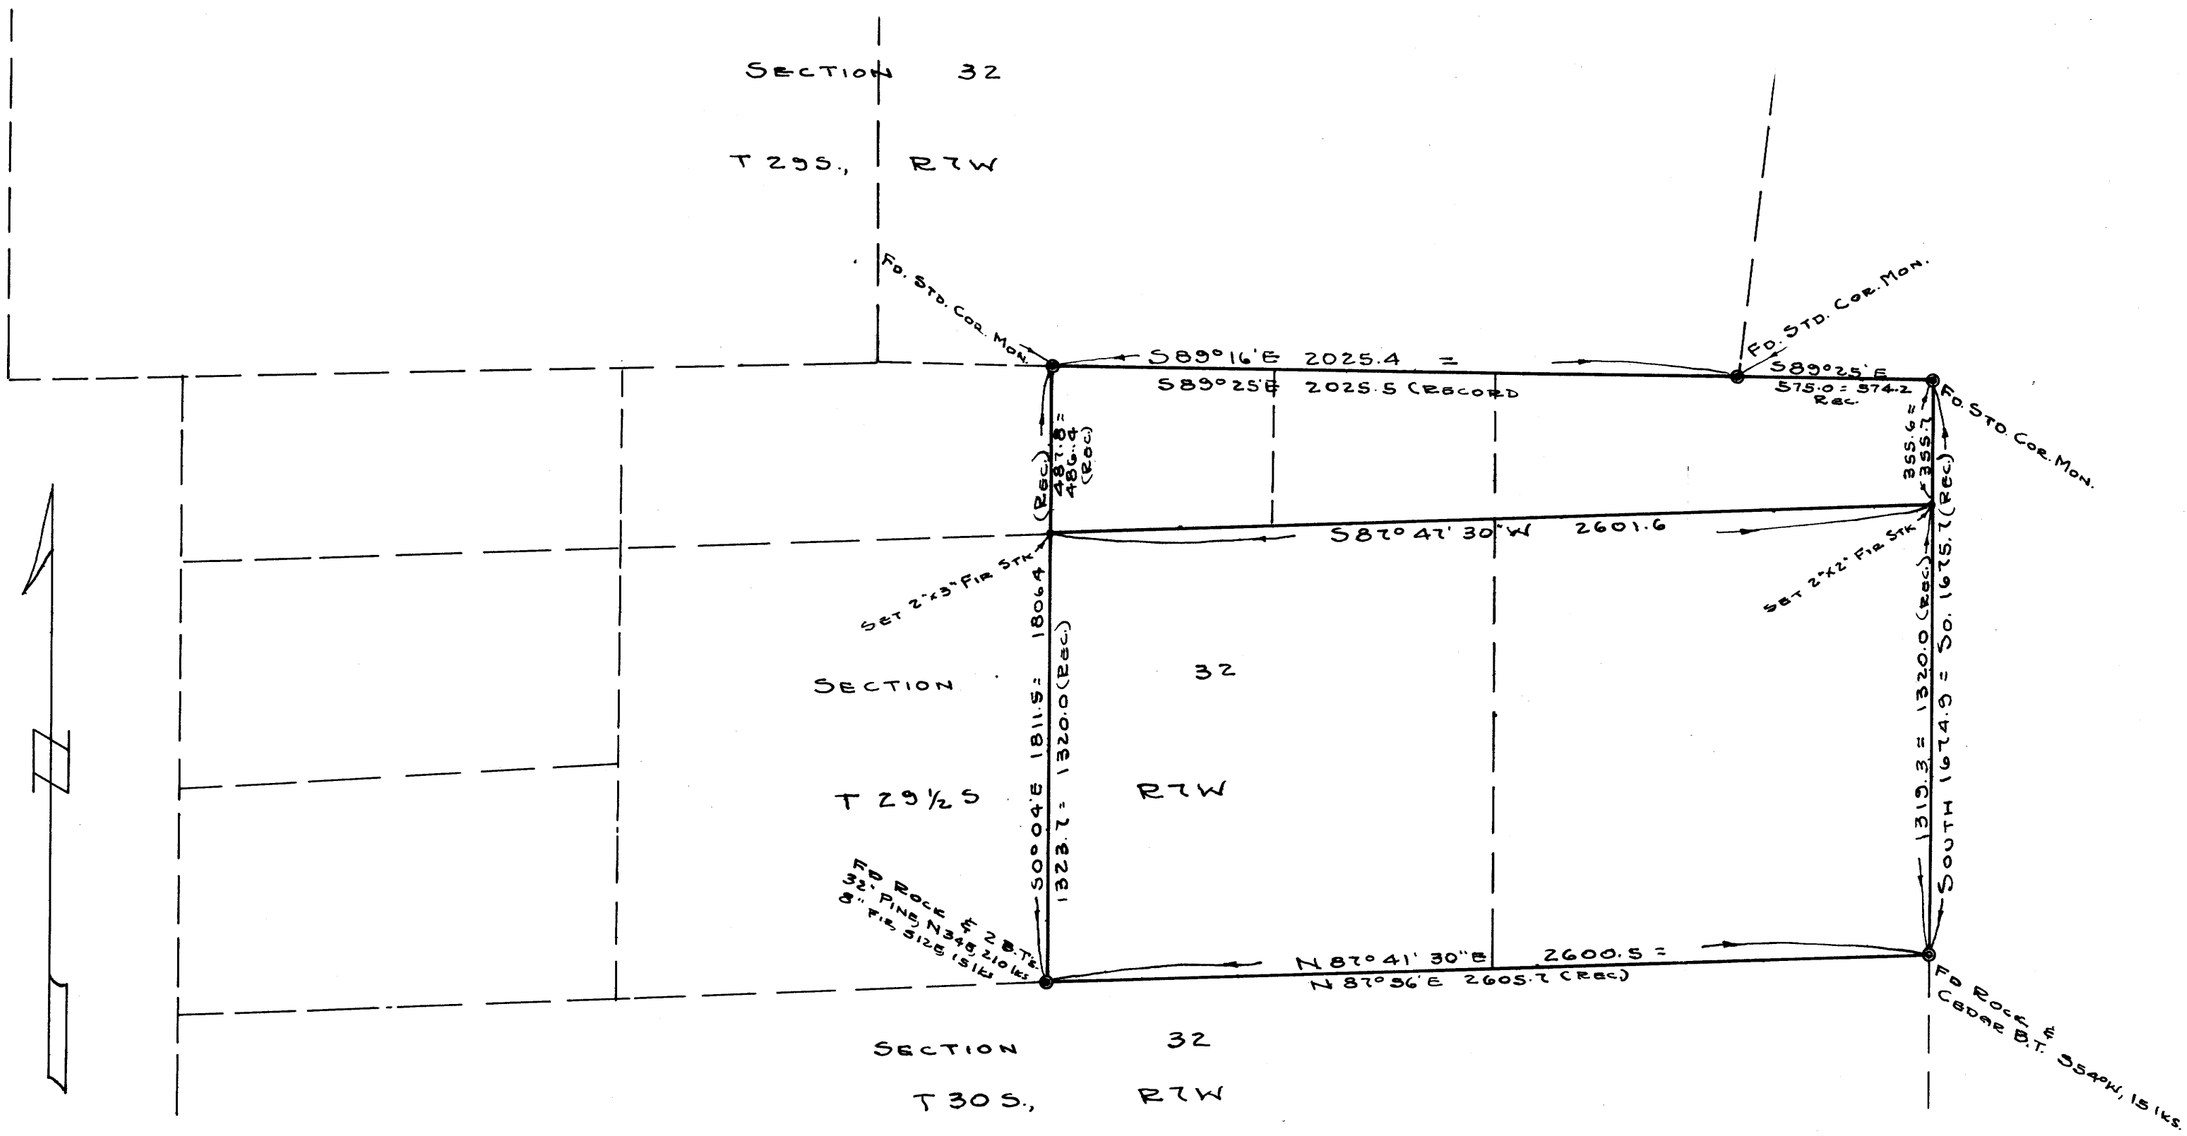

FILED
RECEIVED
APR 28 1953
COUNTY SURVEYOR
DOUGLAS COUNTY, ORE.

BEARINGS ARE BASED ON RECORD BEARING OF LINE BETWEEN S.E. COR. SEC. 32, T29S, R7W. & N.E. COR, SEC 32, T 29½S, R7W.

C.S. FILE 41/145
M26-45

3

1