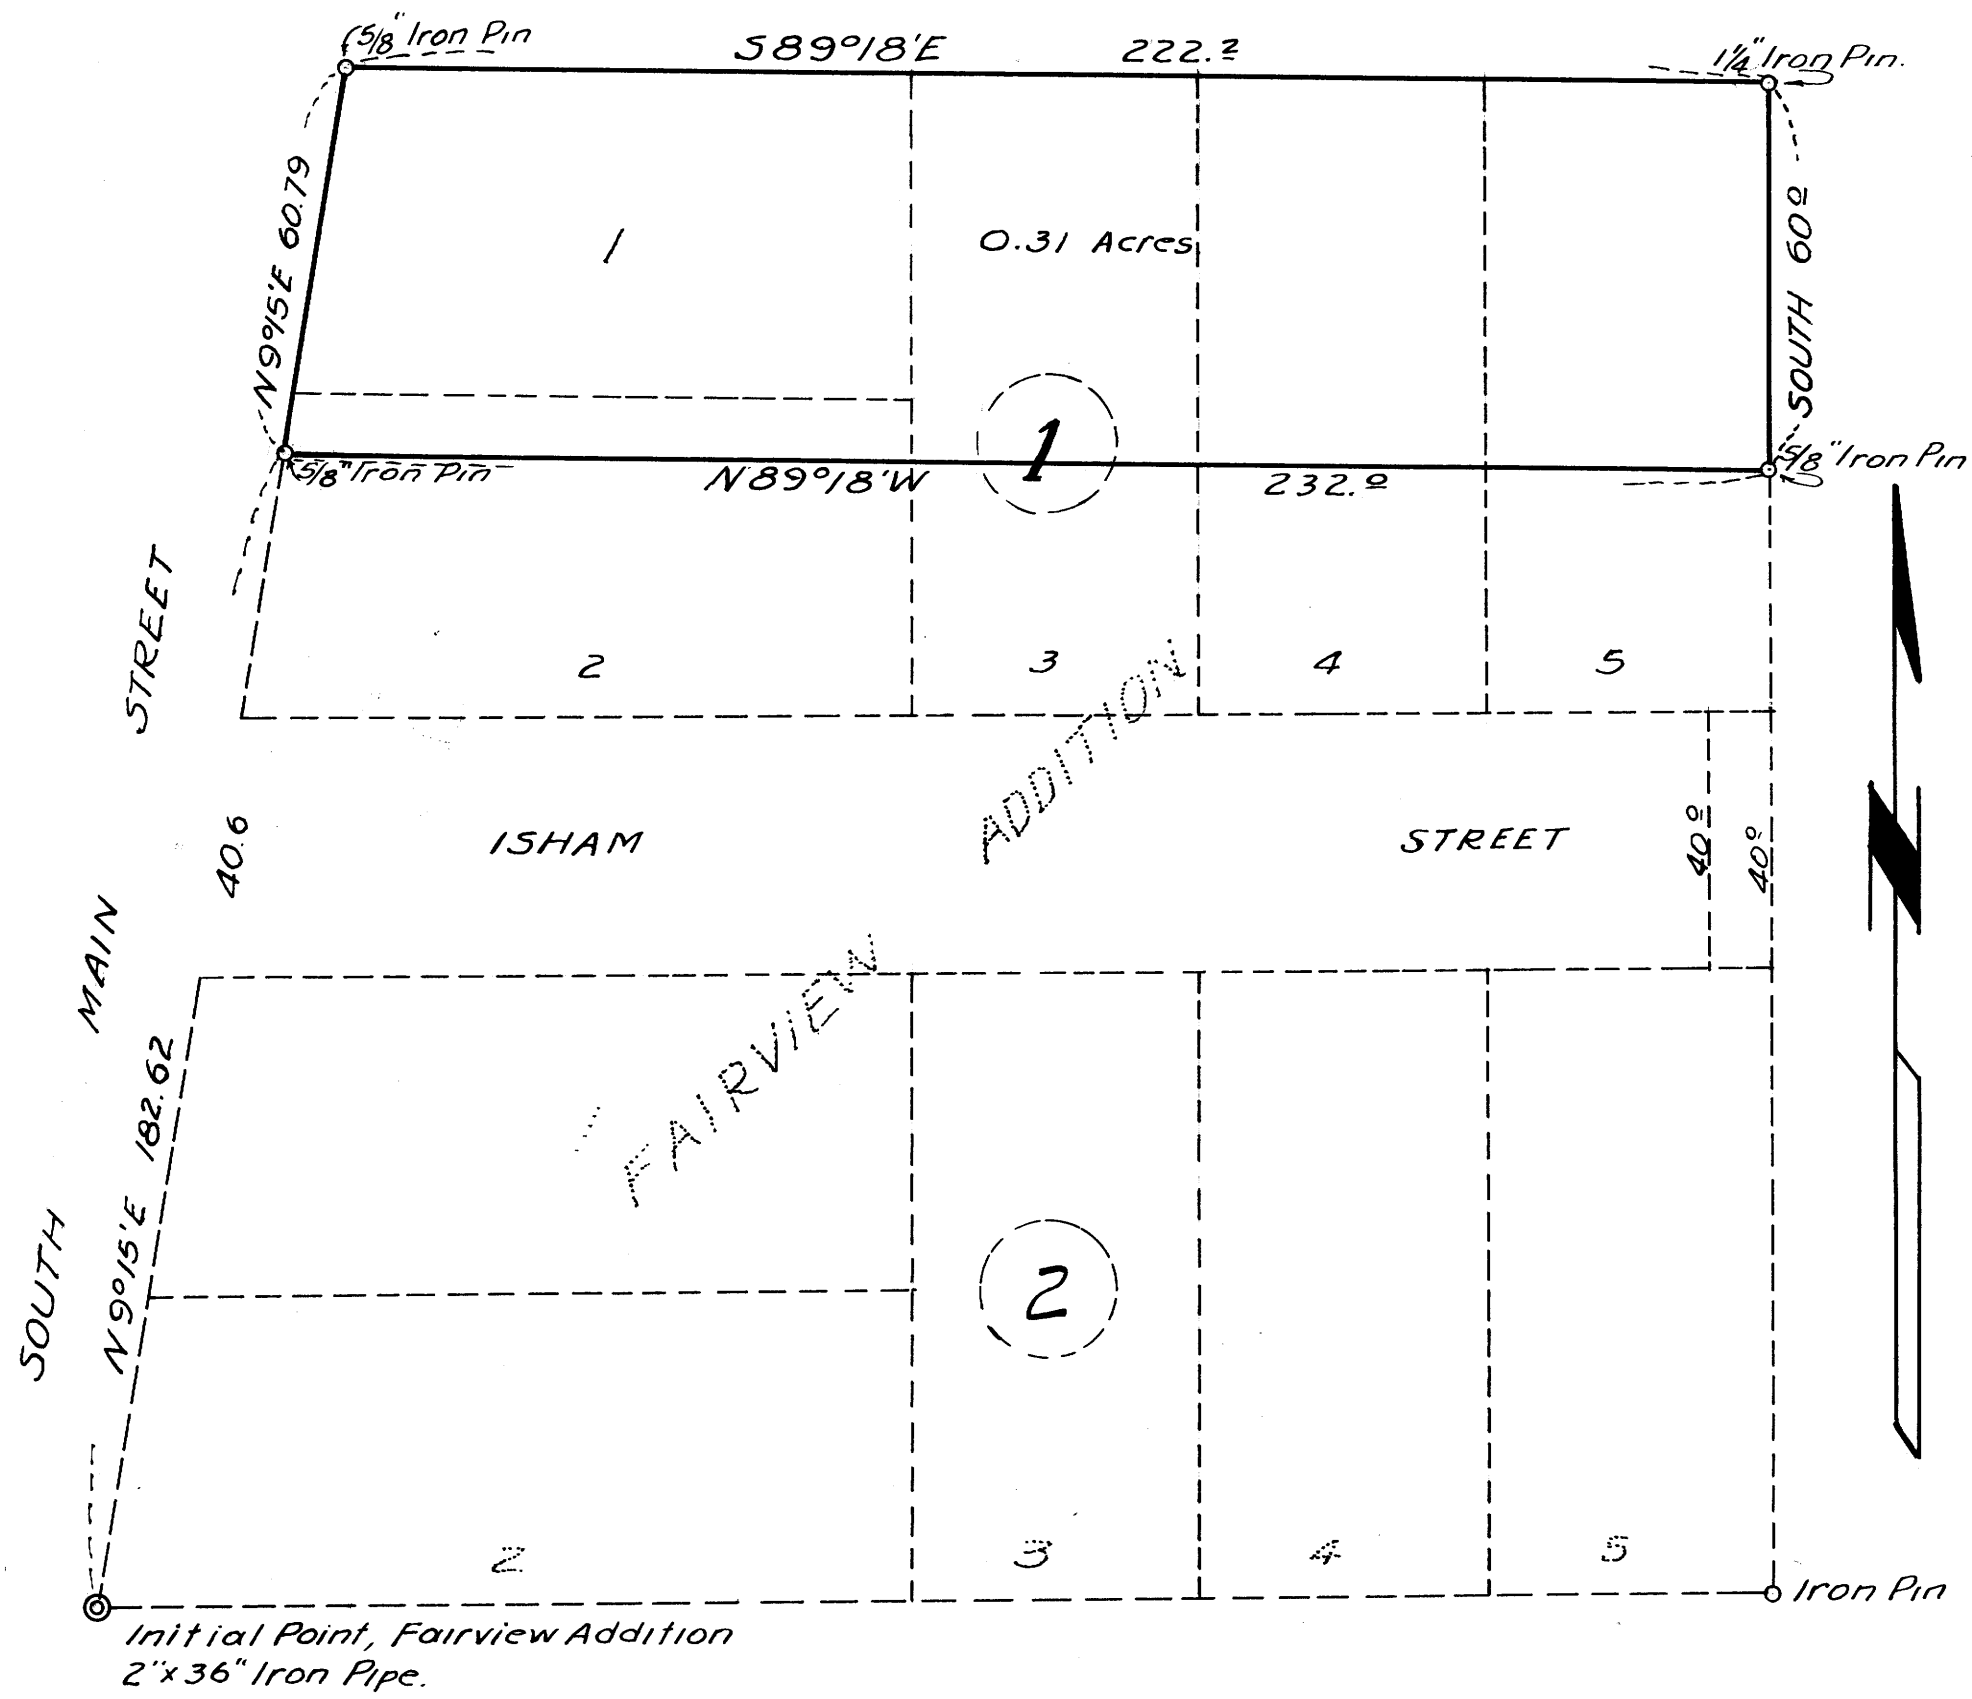

COUNTY SURVEYORS OFFICE
DOUGLAS COUNTY OREGON
SURVEY OF LOT 1, AND PARTS OF
LOTS 2, 3, 4, AND 5, BLK. 1, FAIRVIEW
ADDITION TO ROSEBURG, OREGON

BEN B. IRVING COUNTY SURVEYOR
SURVEYED MAY 27, 1947 BY
N. E. RICHARDSON DEPUTY
SCALE 1" = 30'

COUNTY SURVEYORS FILE
DO NOT REMOVE FROM