M26-54

SURVEY OF ROSEBURG PAVING INC. PROPERTY IN SECTION 36, T. 26 S., R. 6 W. W. M. DOUGLAS COUNTY, OREGON

SURVEYOR- W.S. BARNES

SEPT. 1963

SCALE 1"=60'

COUNTY SURVEYORS FILE DA
DO NOT REMOVE FROM OFFI

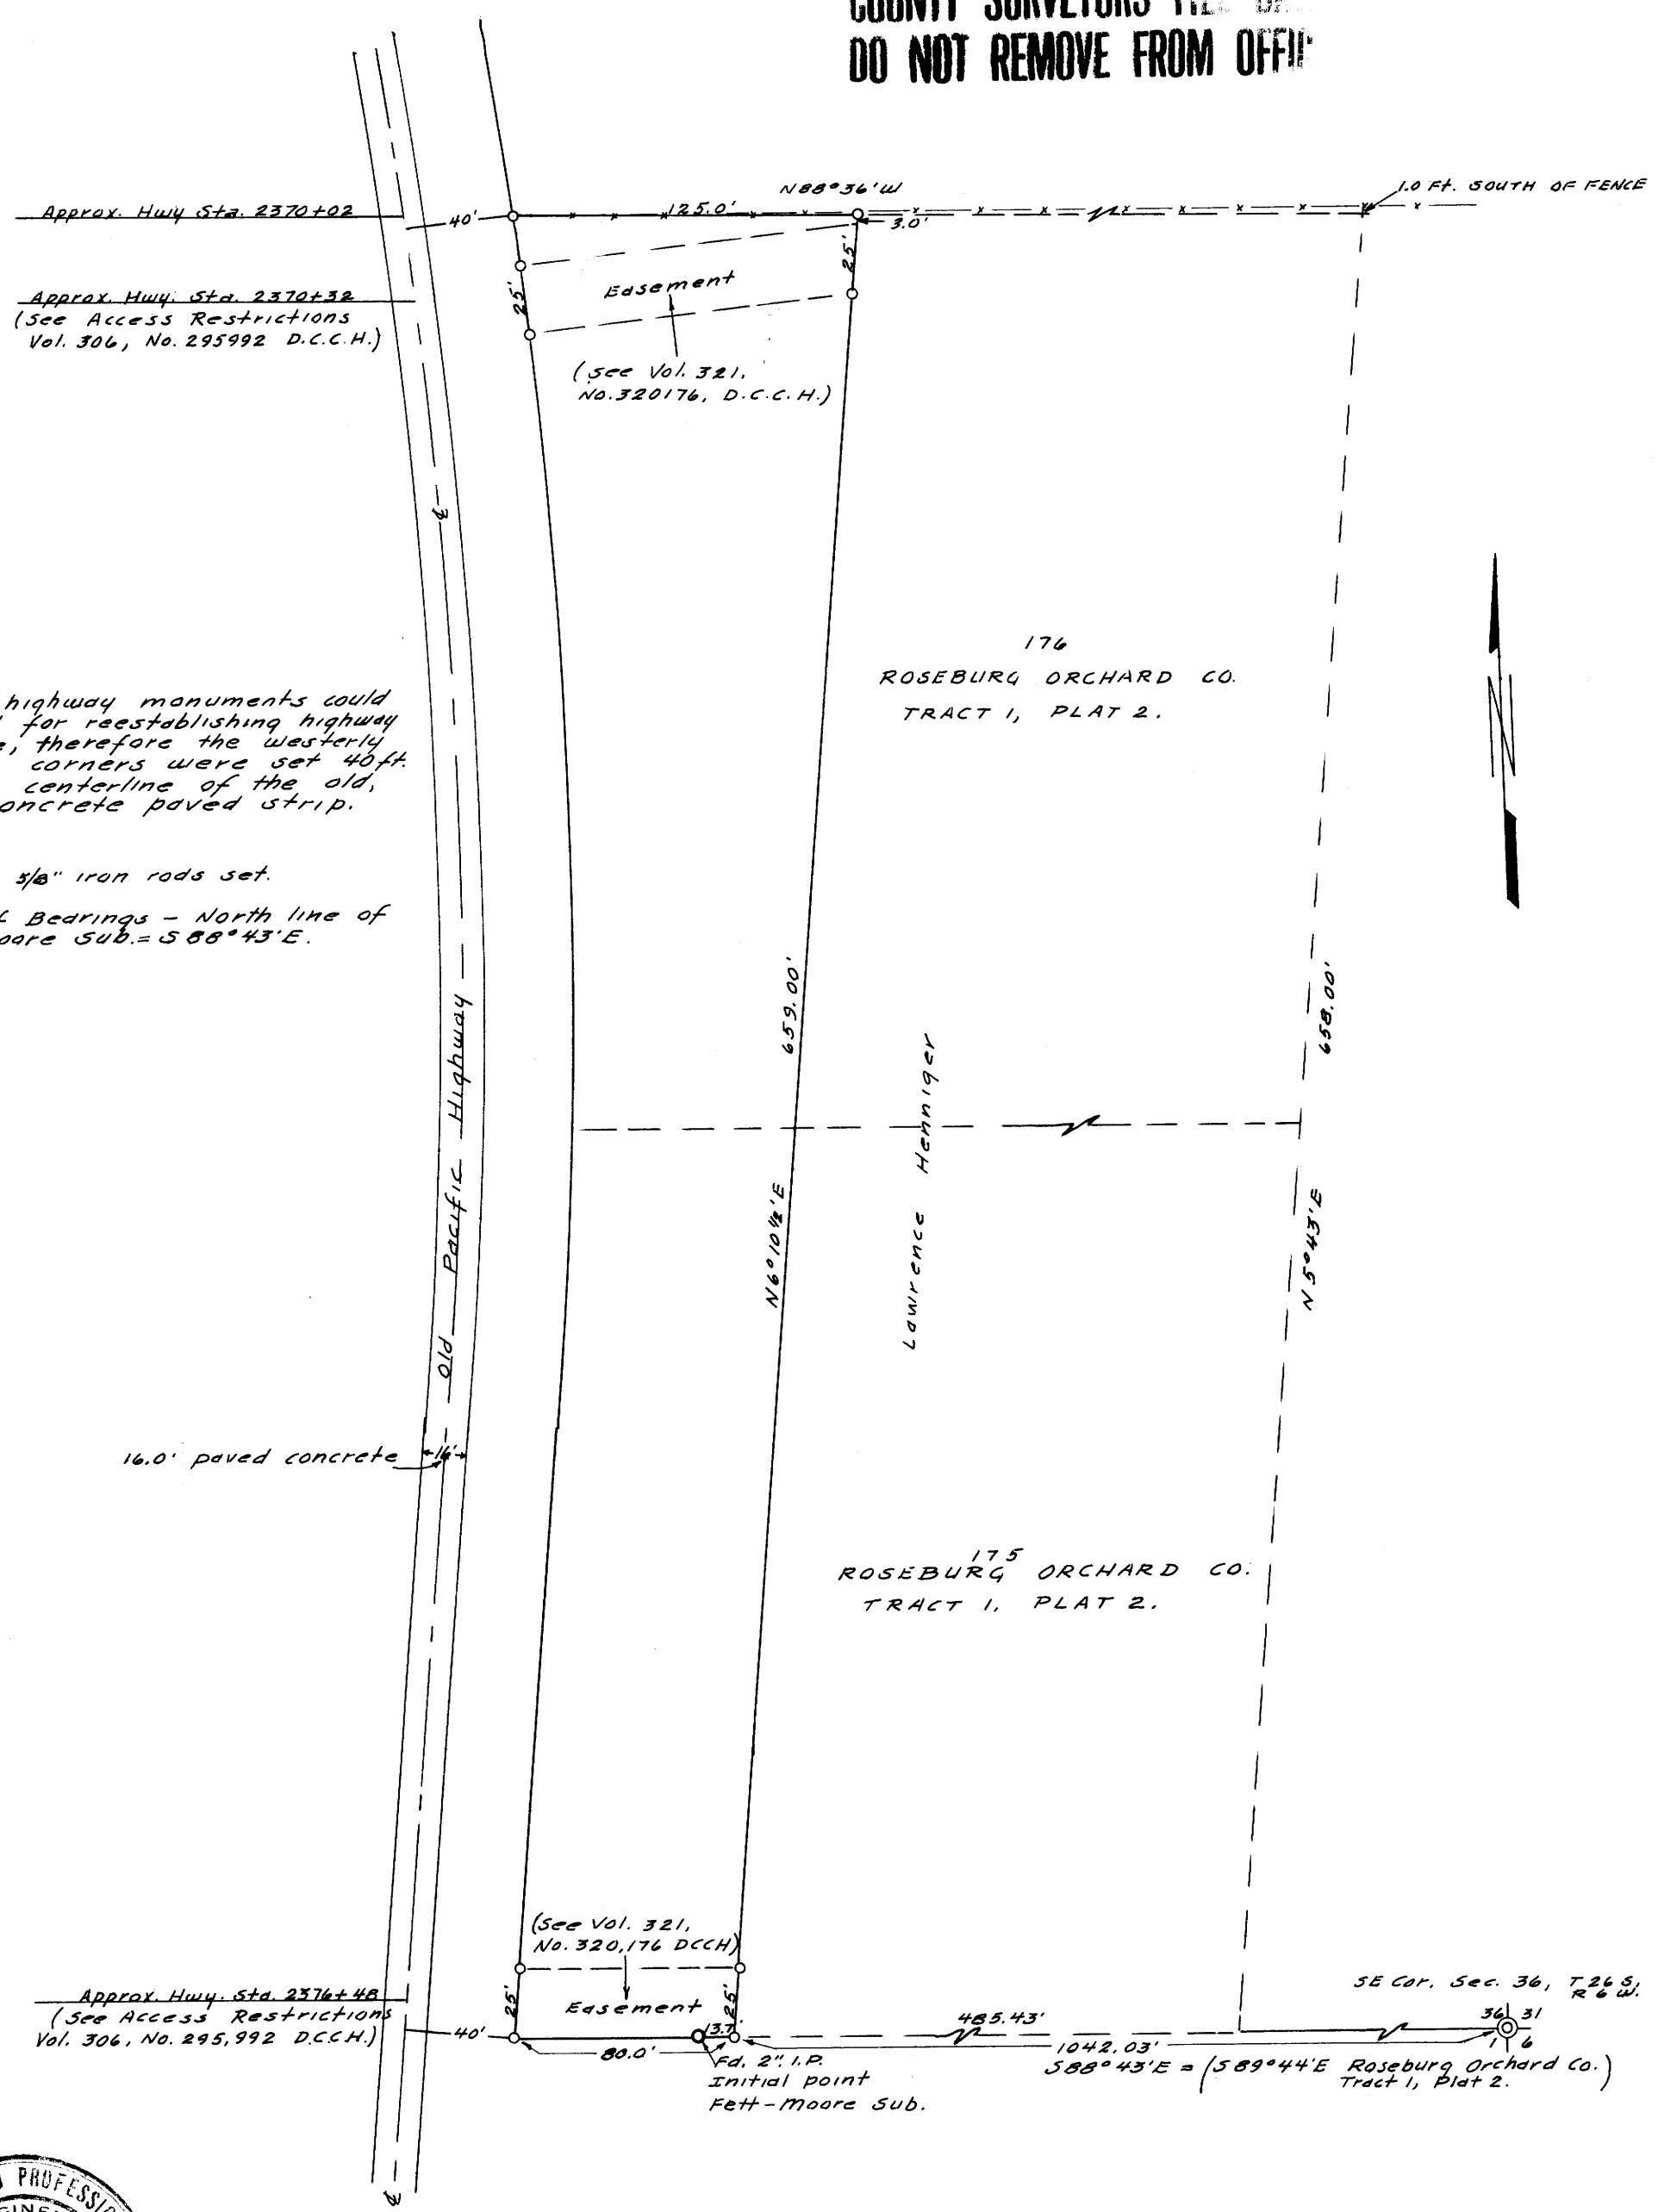

REGISTERED PROFESSIONAL ENGINEER 2128 OREGON SEPT. 5, 1941 William S. Barnes

W. S. Barnes

FILED L.L.
RECEIVED

SEP 12 1963

COUNTY SURVEYOR
DOUGLAS COUNTY, ORE.

MAP FILE M 26-54