M26-64

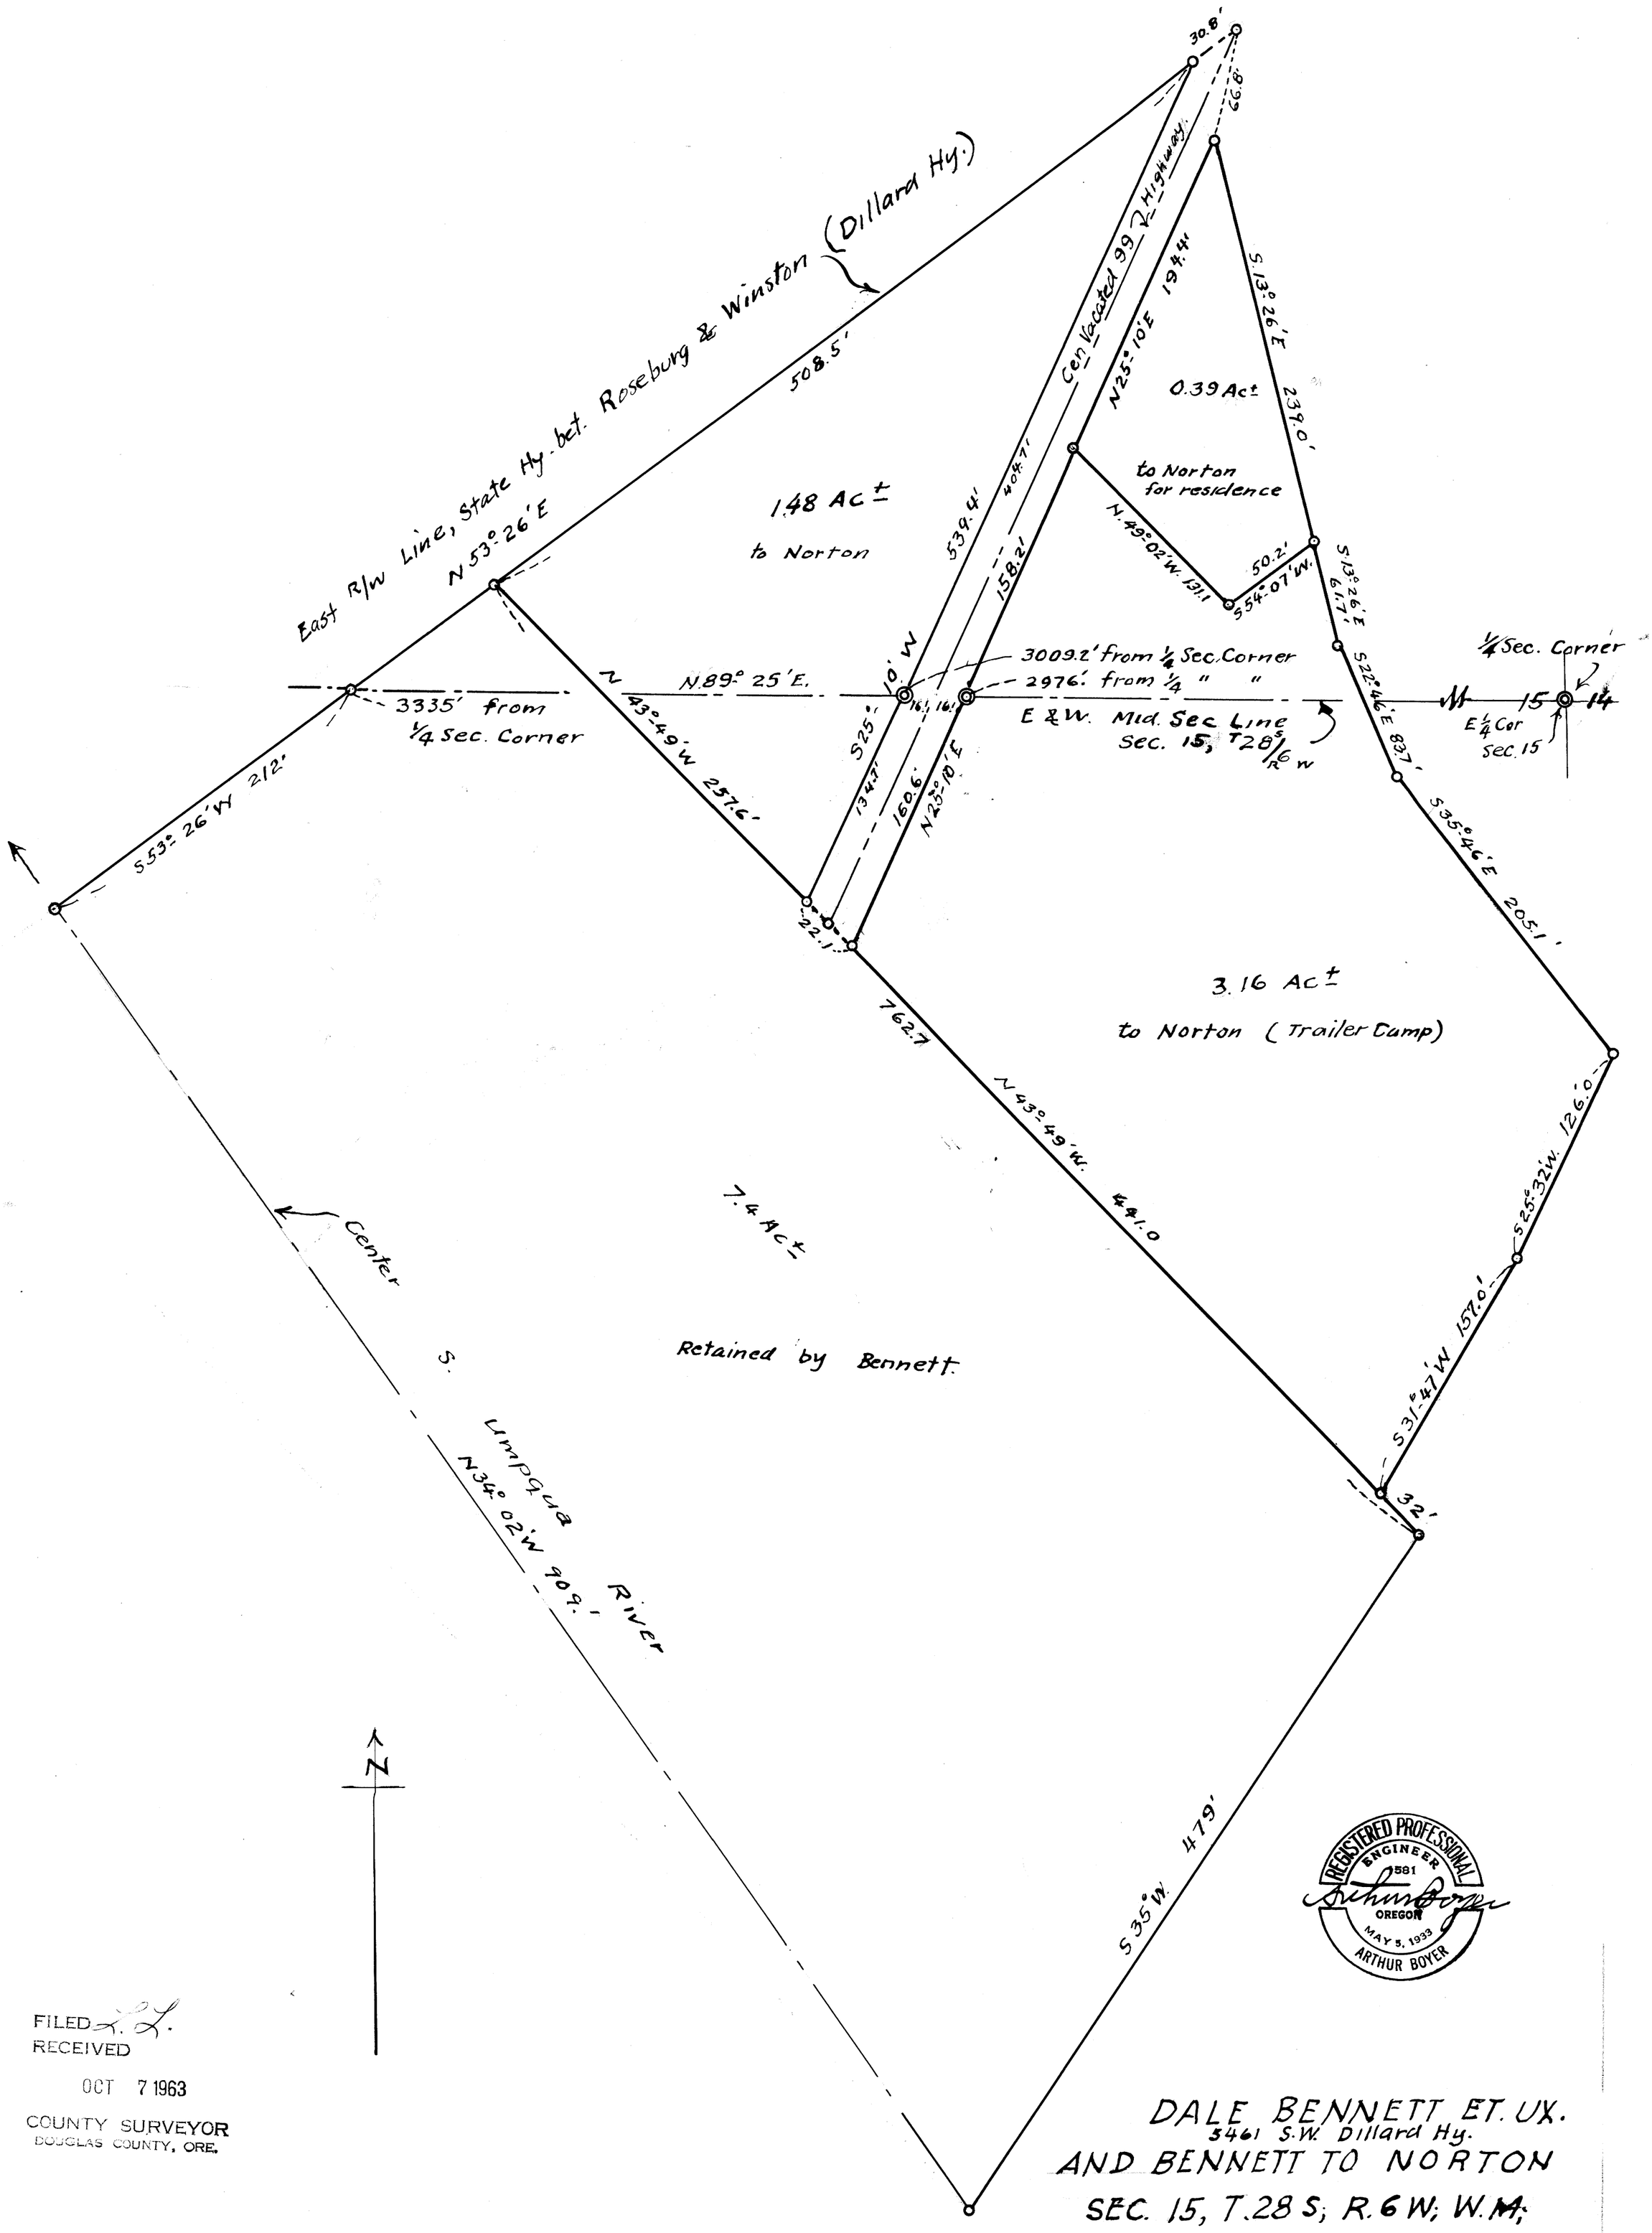


FILED
RECEIVED
OCT 7 1963
COUNTY SURVEYOR
DOUGLAS COUNTY, ORE.

REGISTERED PROFESSIONAL ENGINEER 581 OREGON MAY 5, 1933 ARTHUR BOYER

DALE BENNETT ET. UX.
3461 S.W. Dillard Hy.
AND BENNETT TO NORTON
SEC. 15, T.28 S; R.6 W; W.M.;
DOUGLAS COUNTY, ORE
OCT 7, 1963 1"=60'

COUNTY SURVEYOR
DO NOT REMOVE FROM

FILE M26-64