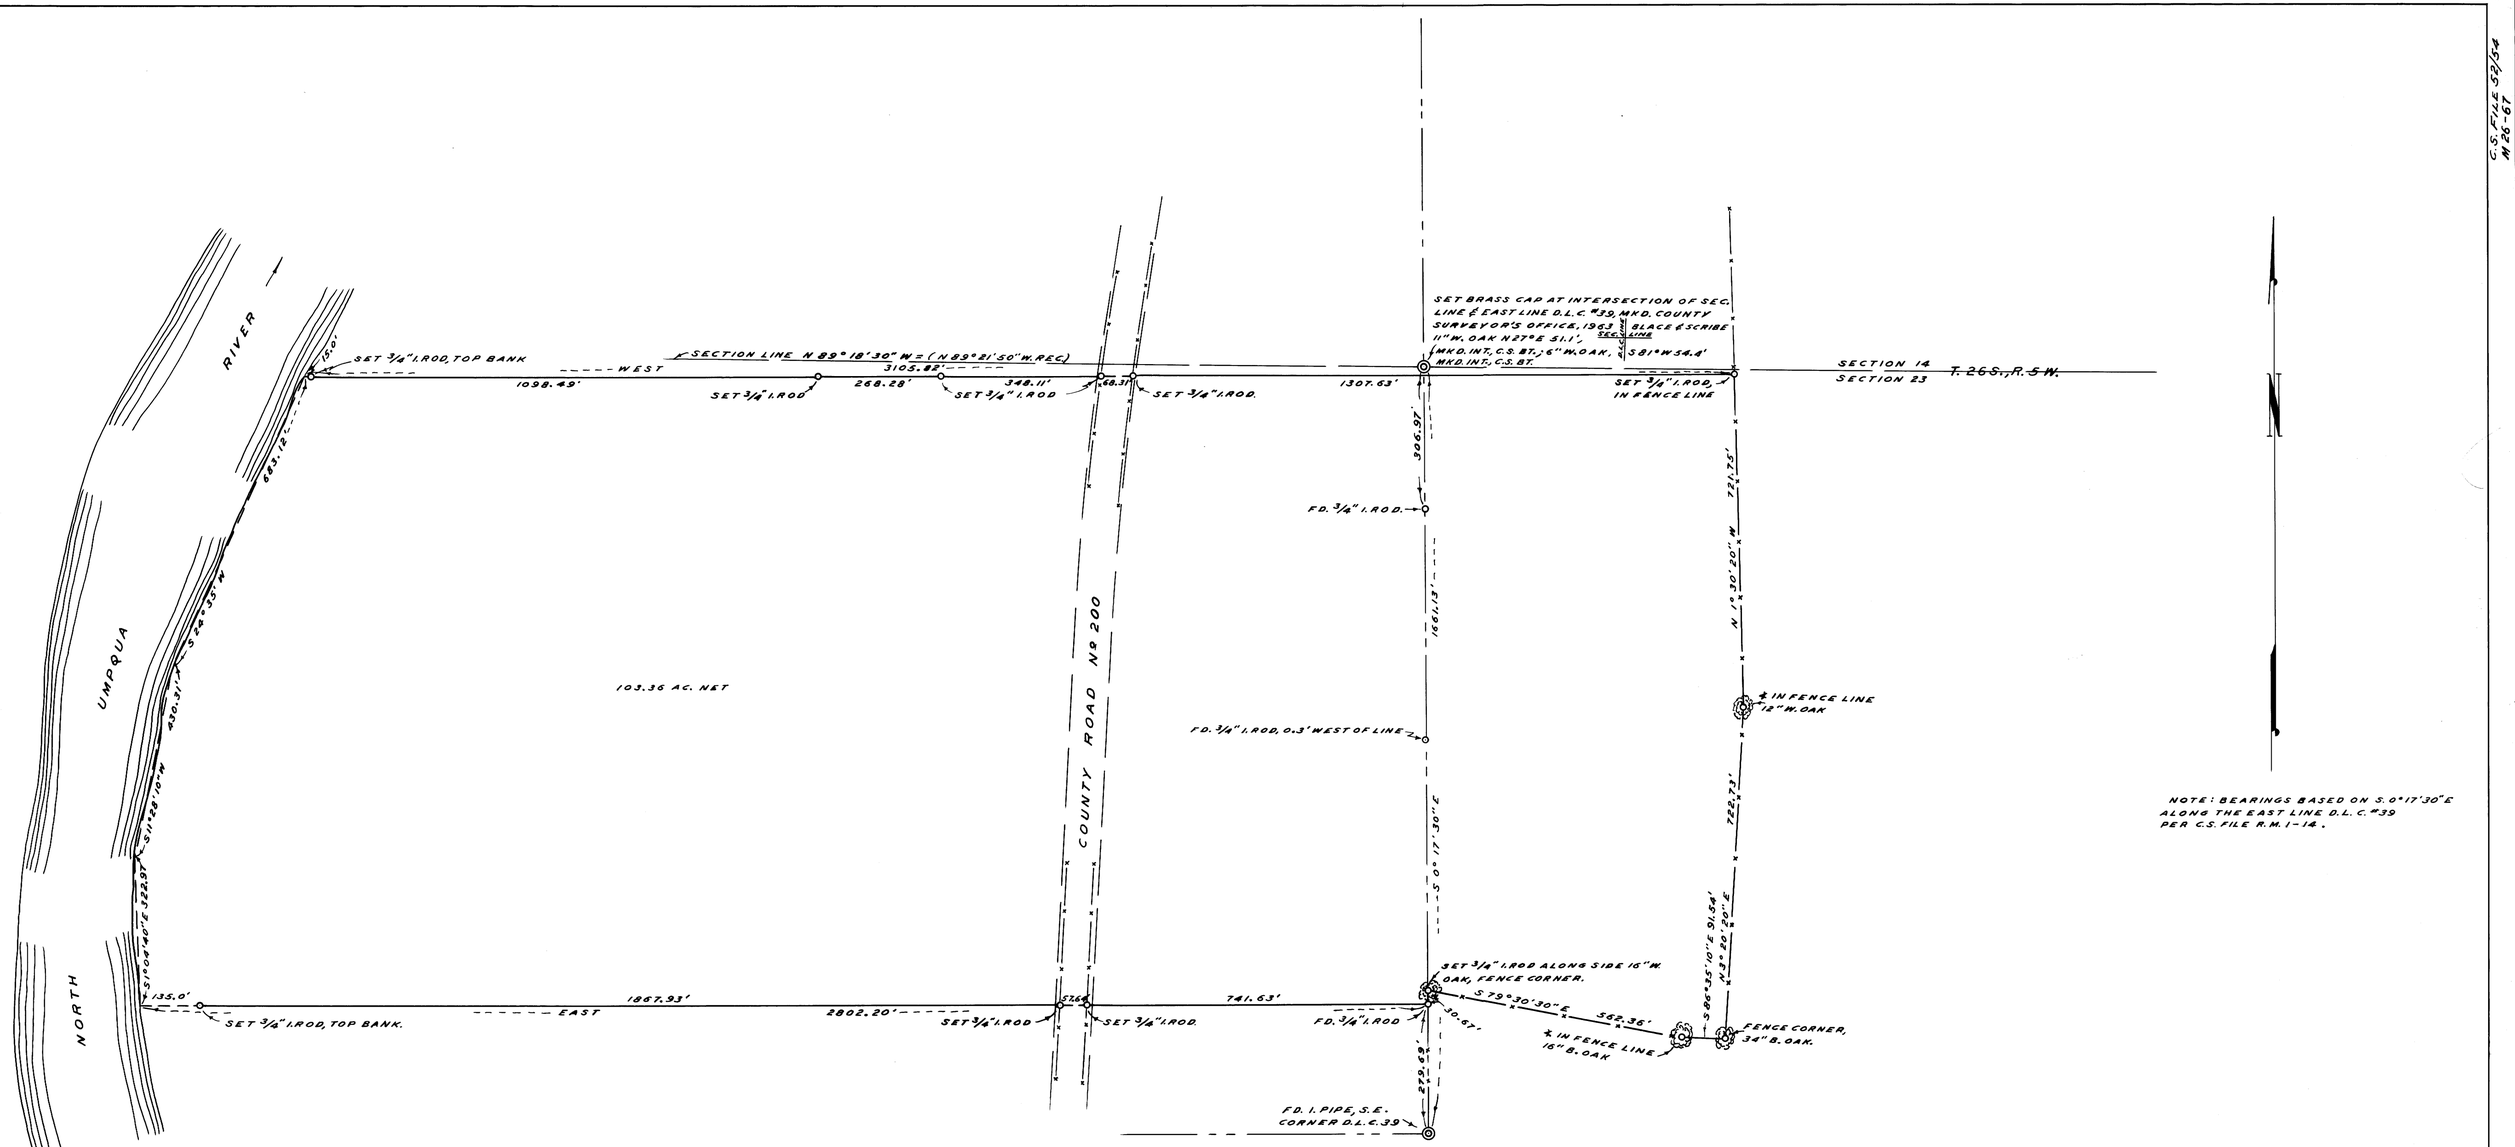

NOTE: BEARINGS BASED ON S. 0° 17' 30" E ALONG THE EAST LINE D.L.C. #39 PER C.S. FILE R.M. 1-14.

C.S. FILE 52/54
M 26-67

COUNTY SURVEYOR'S OFFICE
DOUGLAS COUNTY, OREGON

SURVEY FOR DEED DESCRIPTION,
SECTION 23, T26S., R5W, W.M.

FRED M. DARBY — COUNTY SURVEYOR
SURVEYED SEPT. 27, 1963 — BY
MILO E. GODFREY - DEPUTY — SCALE 1" = 200'
SURVEYED FOR BOB FRANKS

REGISTERED
OREGON
LAND SURVEYOR
Milo E. Godfrey
MAY 13, 1971
MILO E. GODFREY
493

COUNTY SURVEYORS FILE D
DO NOT REMOVE FROM OFF

C.S. 52/54
M 26-67