C.S. FILE 39/74
MAP FILE M27/14

COUNTY SURVEYORS FILE DATA
DO NOT REMOVE FROM OFFICE

Geo. J. Wendeutt
LICENSE STAMP

SECTION 30
T. 31 S., R. 3 W. W.M.

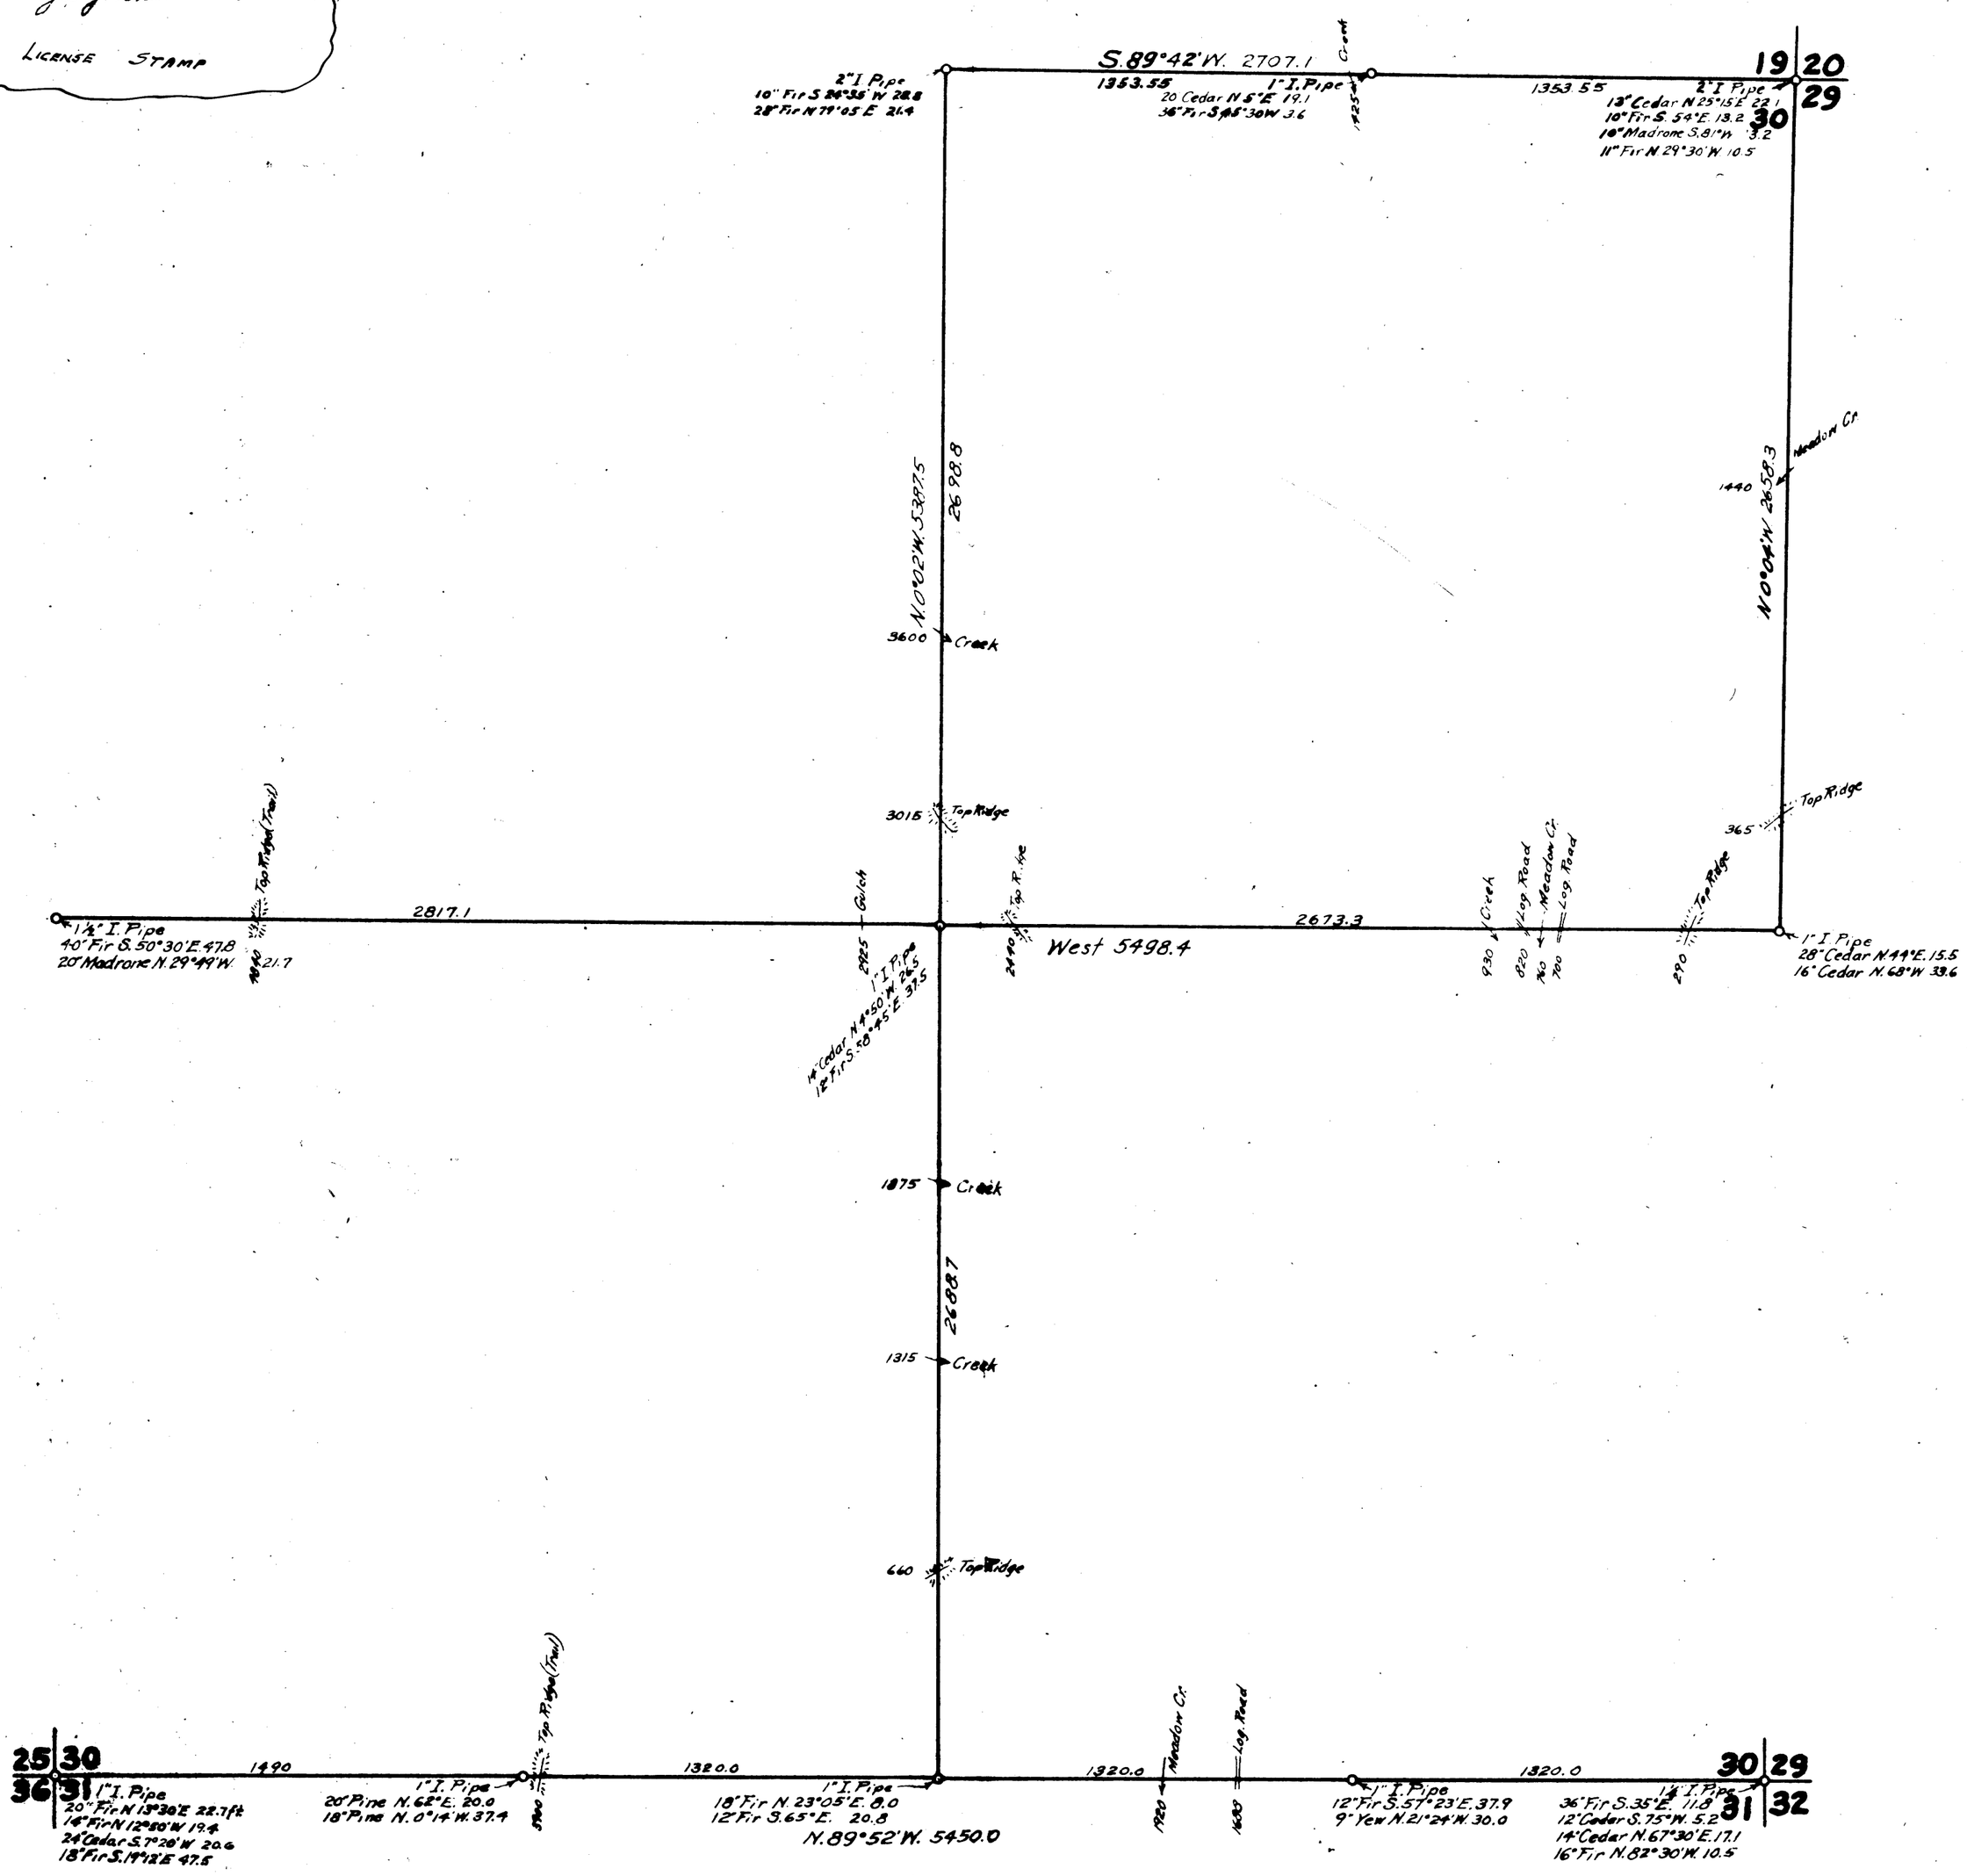

C.S. FILE 39/74
MAP FILE M27/14

SECTION 30
T. 31 S., R. 3 W. W.M.

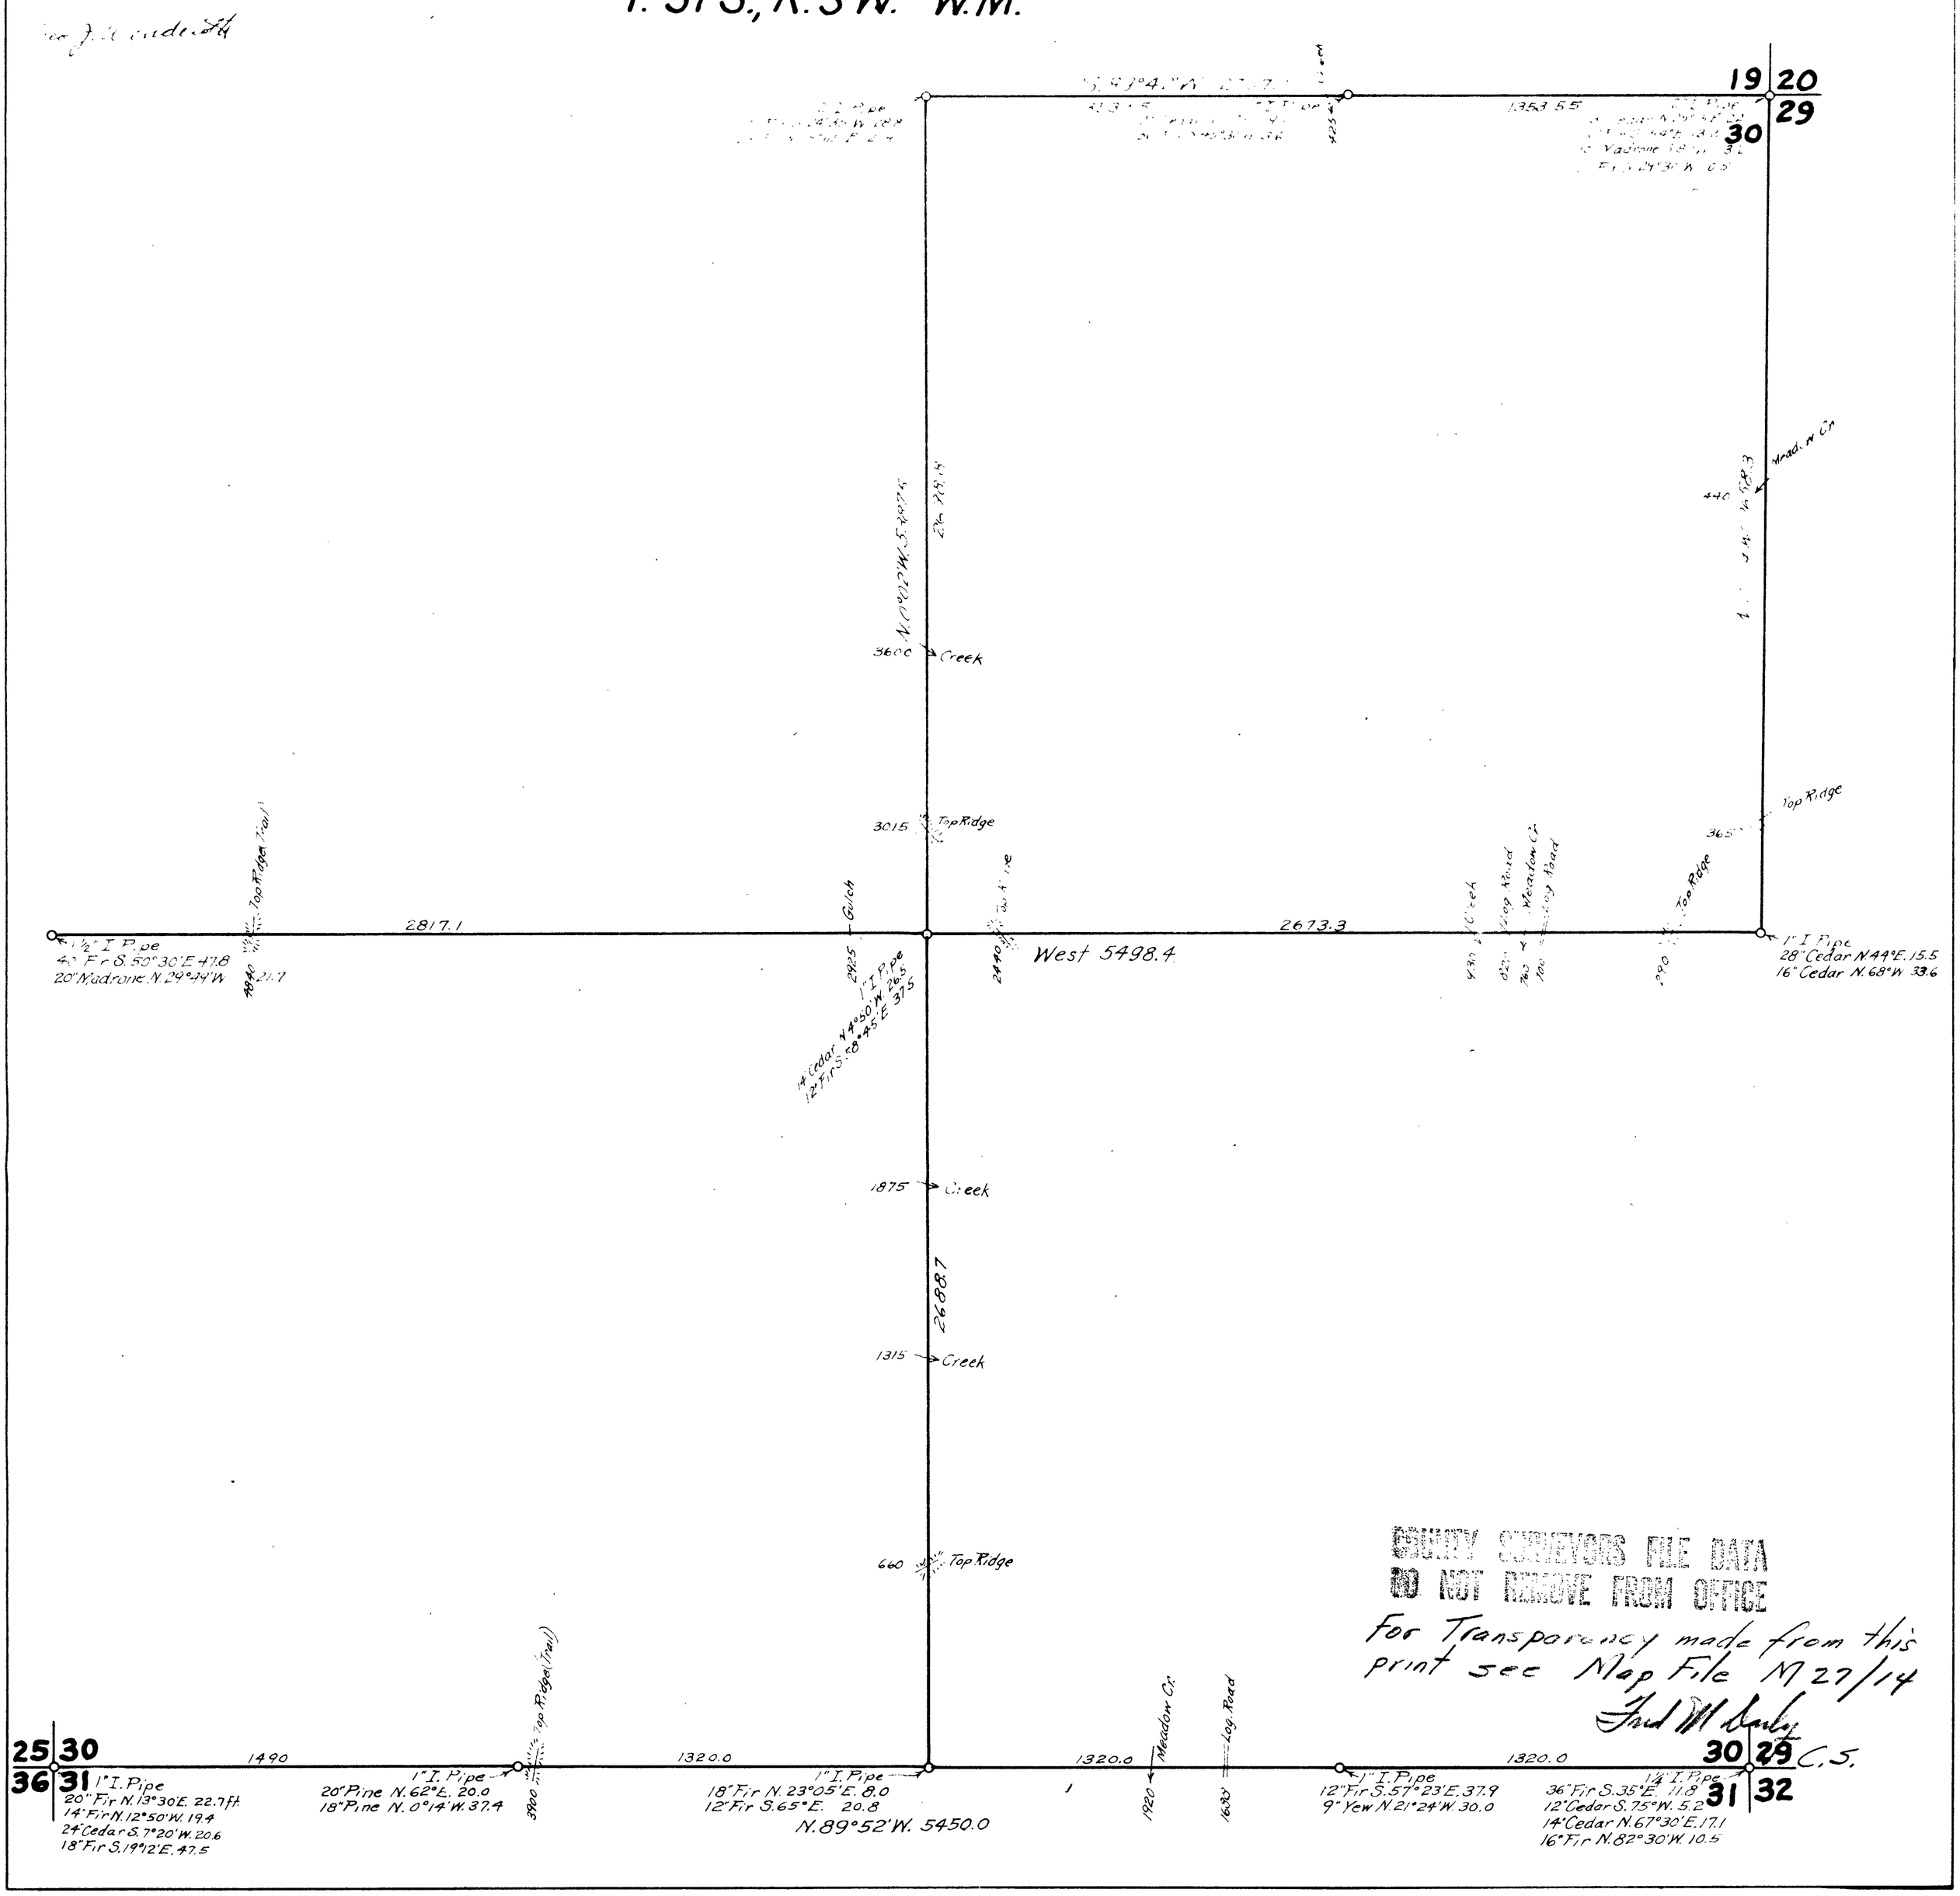

COUNTY SURVEYORS FILE DATA
DO NOT REMOVE FROM OFFICE

For Transparency made from this print see Map File M 27/14
Fred M Darby

FILE 74 DRAWER 39