COUNTY SURVEYORS FILE DATA
DO NOT REMOVE FROM OFFICE

SECTS. 4+8, T22S., R.7W. W.M.

Scale, 1" = 1000' Dec. 1963

For

Woolley Logging Co. Drain, Oregon

REGISTERED
OREGON
LAND SURVEYOR
Wilford N. Haines
MAY 7, 1948
WILFORD N. HAINES
239

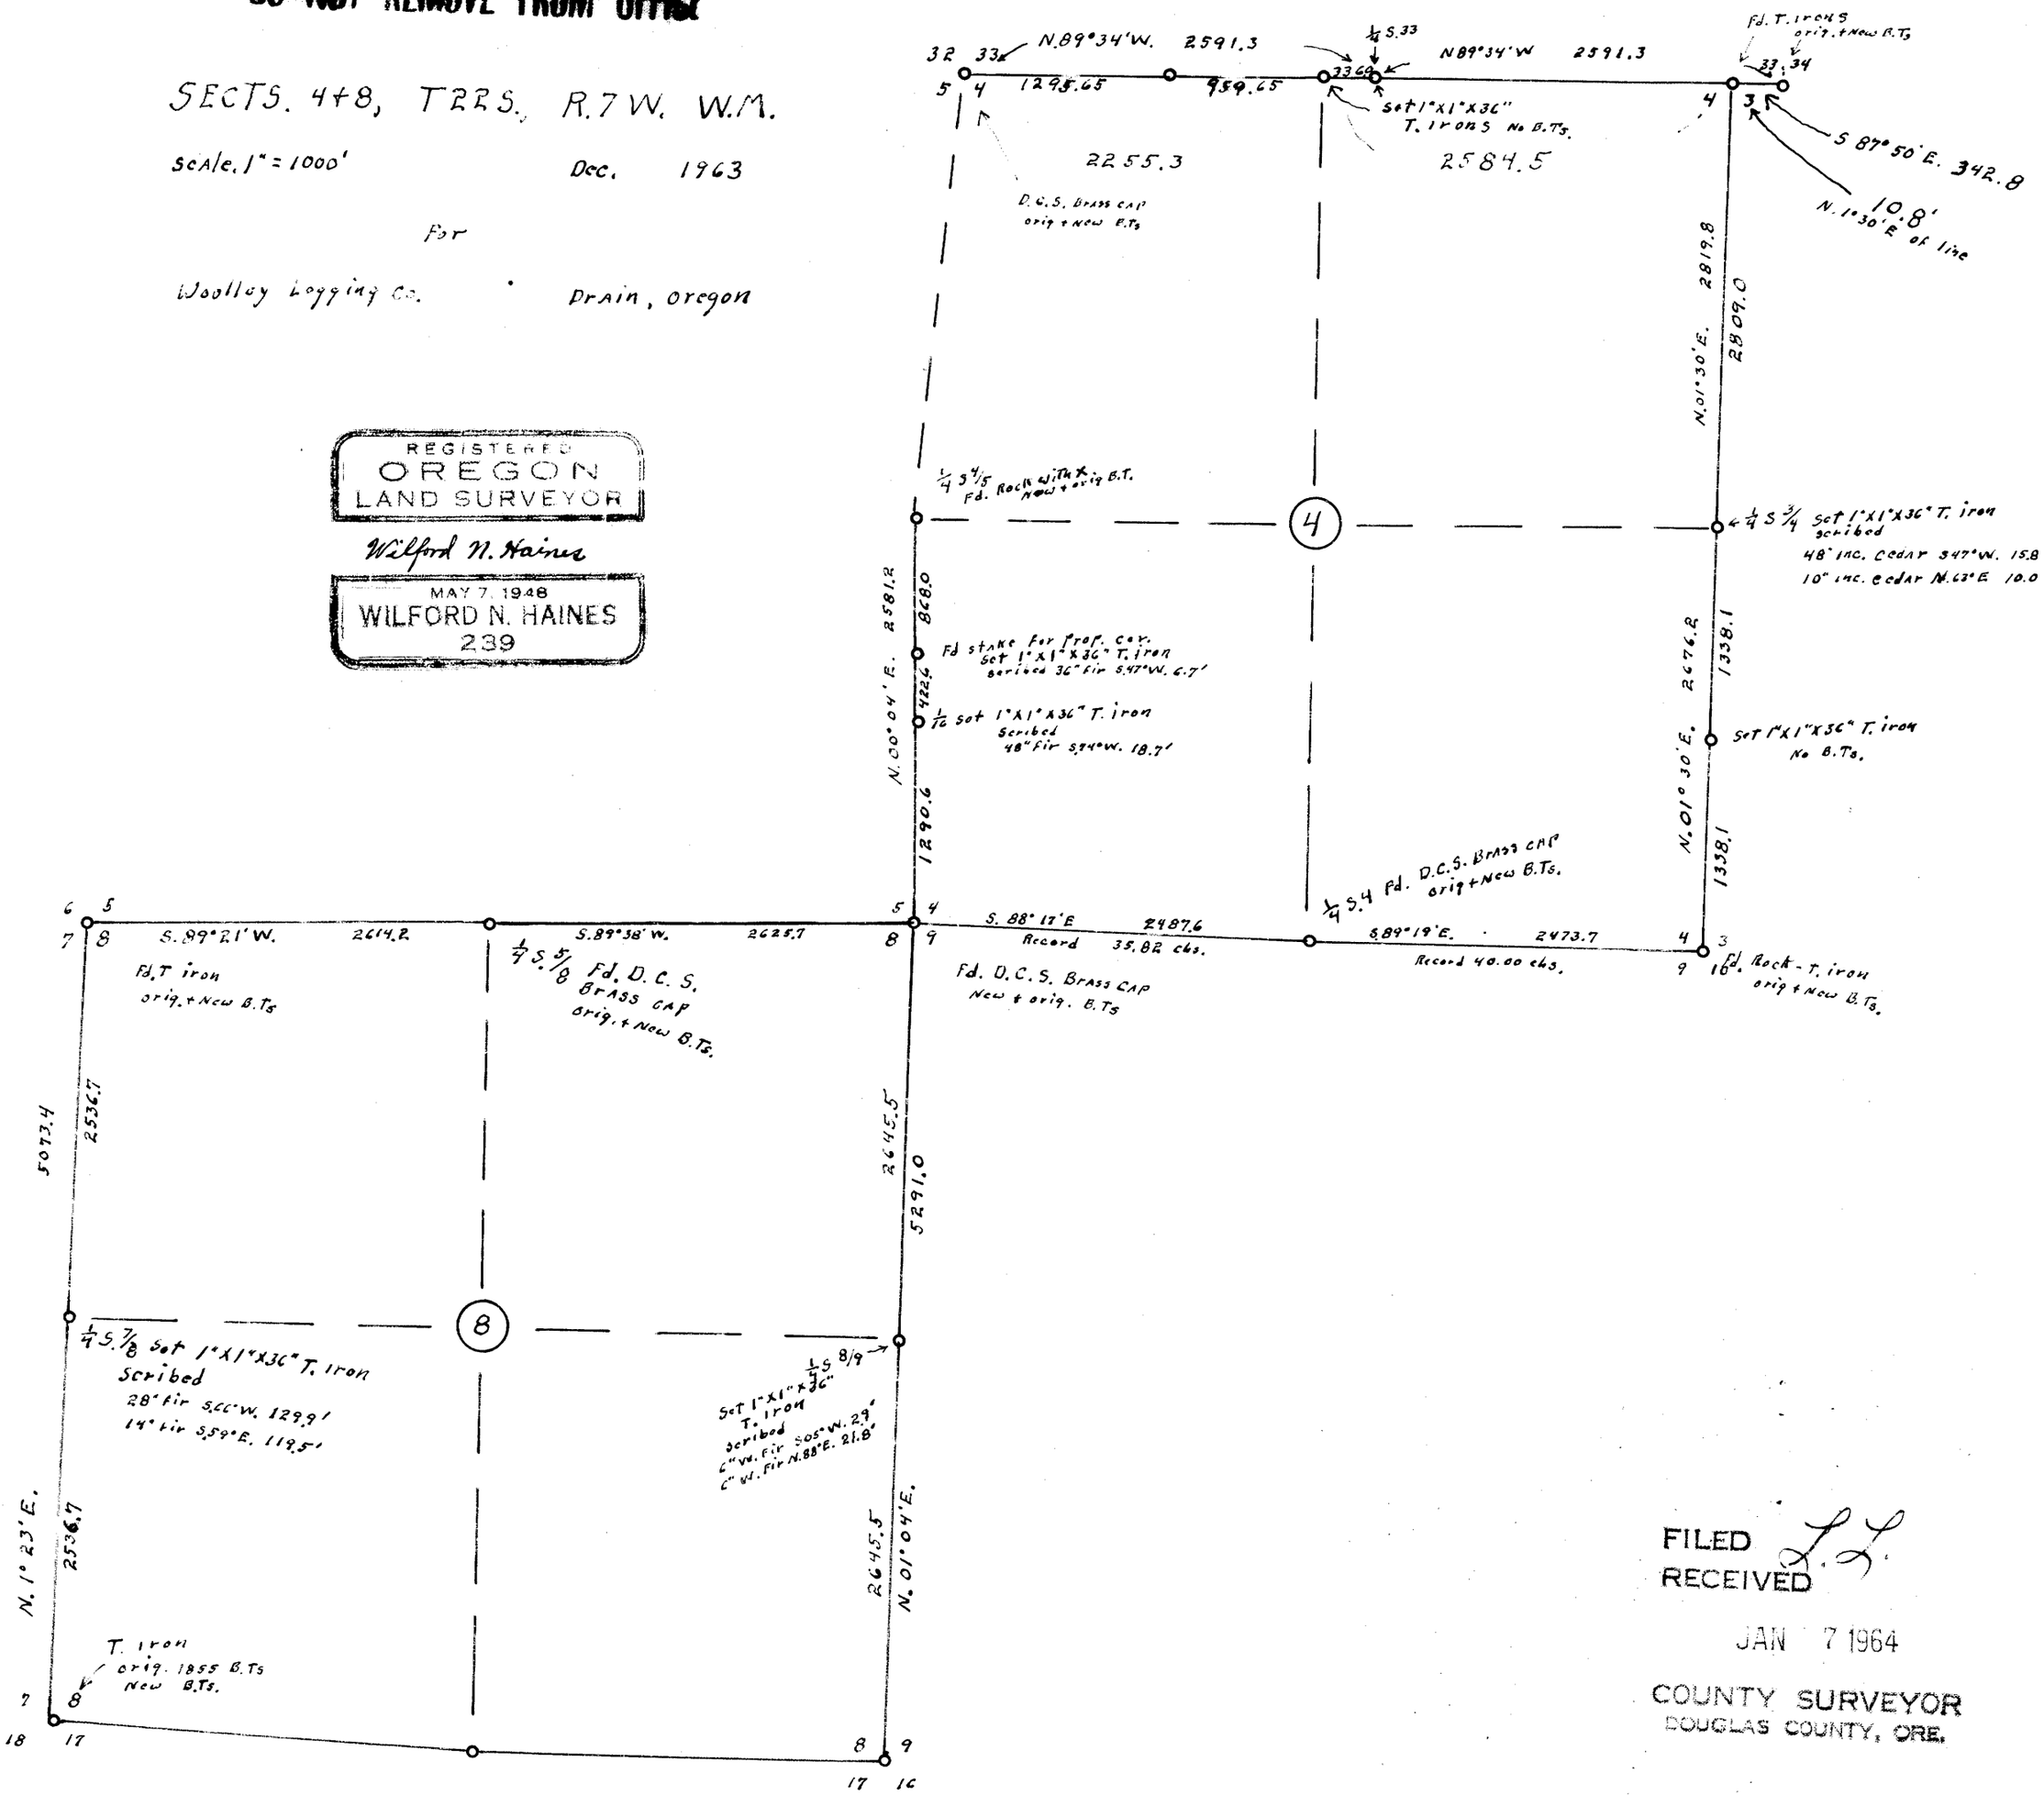

FILED
RECEIVED
JAN 7 1964
COUNTY SURVEYOR
DOUGLAS COUNTY, ORE.

F.B. H-104, H-131

F.B. H-104, H-131