M 27-18

COUNTY SURVEYORS FILE DATA
DO NOT REMOVE FROM OFFICE

MAP OF SURVEY TO ESTABLISH PROPERTY CORNERS IN SEC. 28, T. 26 S., R. 6 W. W. M.

SURVEYED FOR – P. B. SERAFIN
SURVEYED BY – W. S. BARNES

DEC. 1963
SCALE 1" = 100'

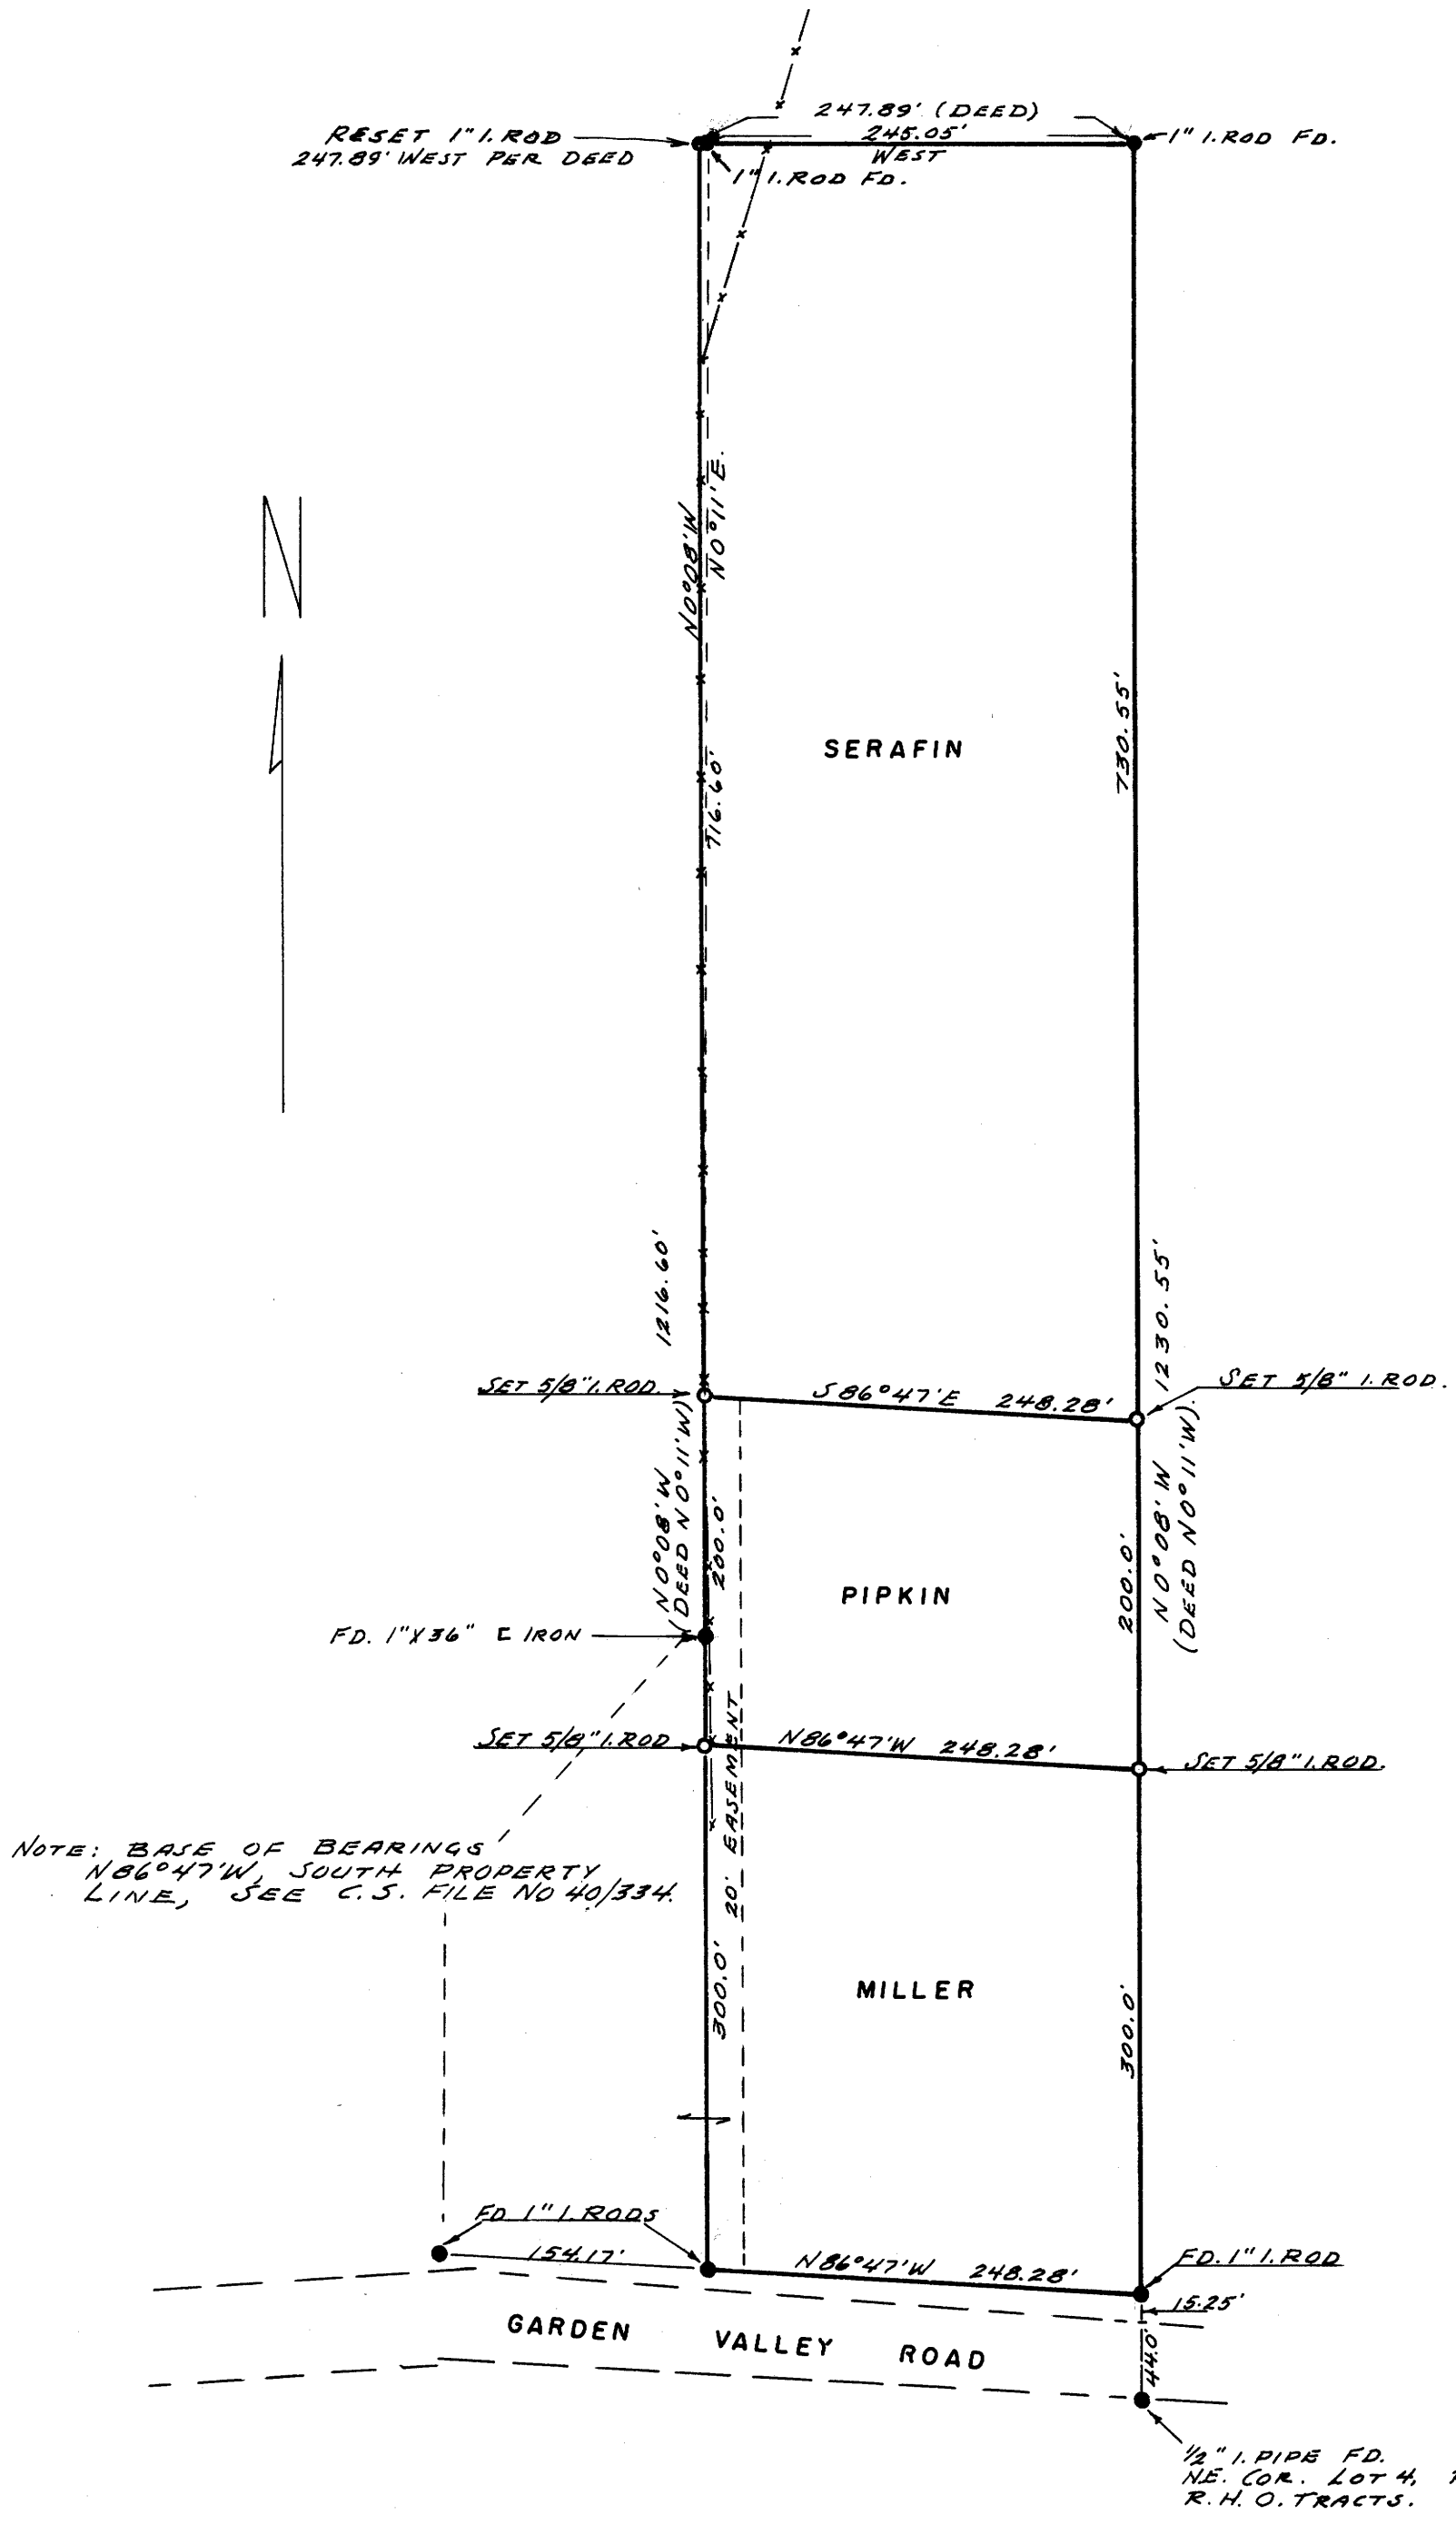

FILED L. L.
RECEIVED
JAN 7 1964
COUNTY SURVEYOR
DOUGLAS COUNTY, ORE.

REGISTERED PROFESSIONAL ENGINEER 2128 OREGON SEPT. 5, 1941 William S. Barnes

W. S. Barnes

MAP FILE M 27-18