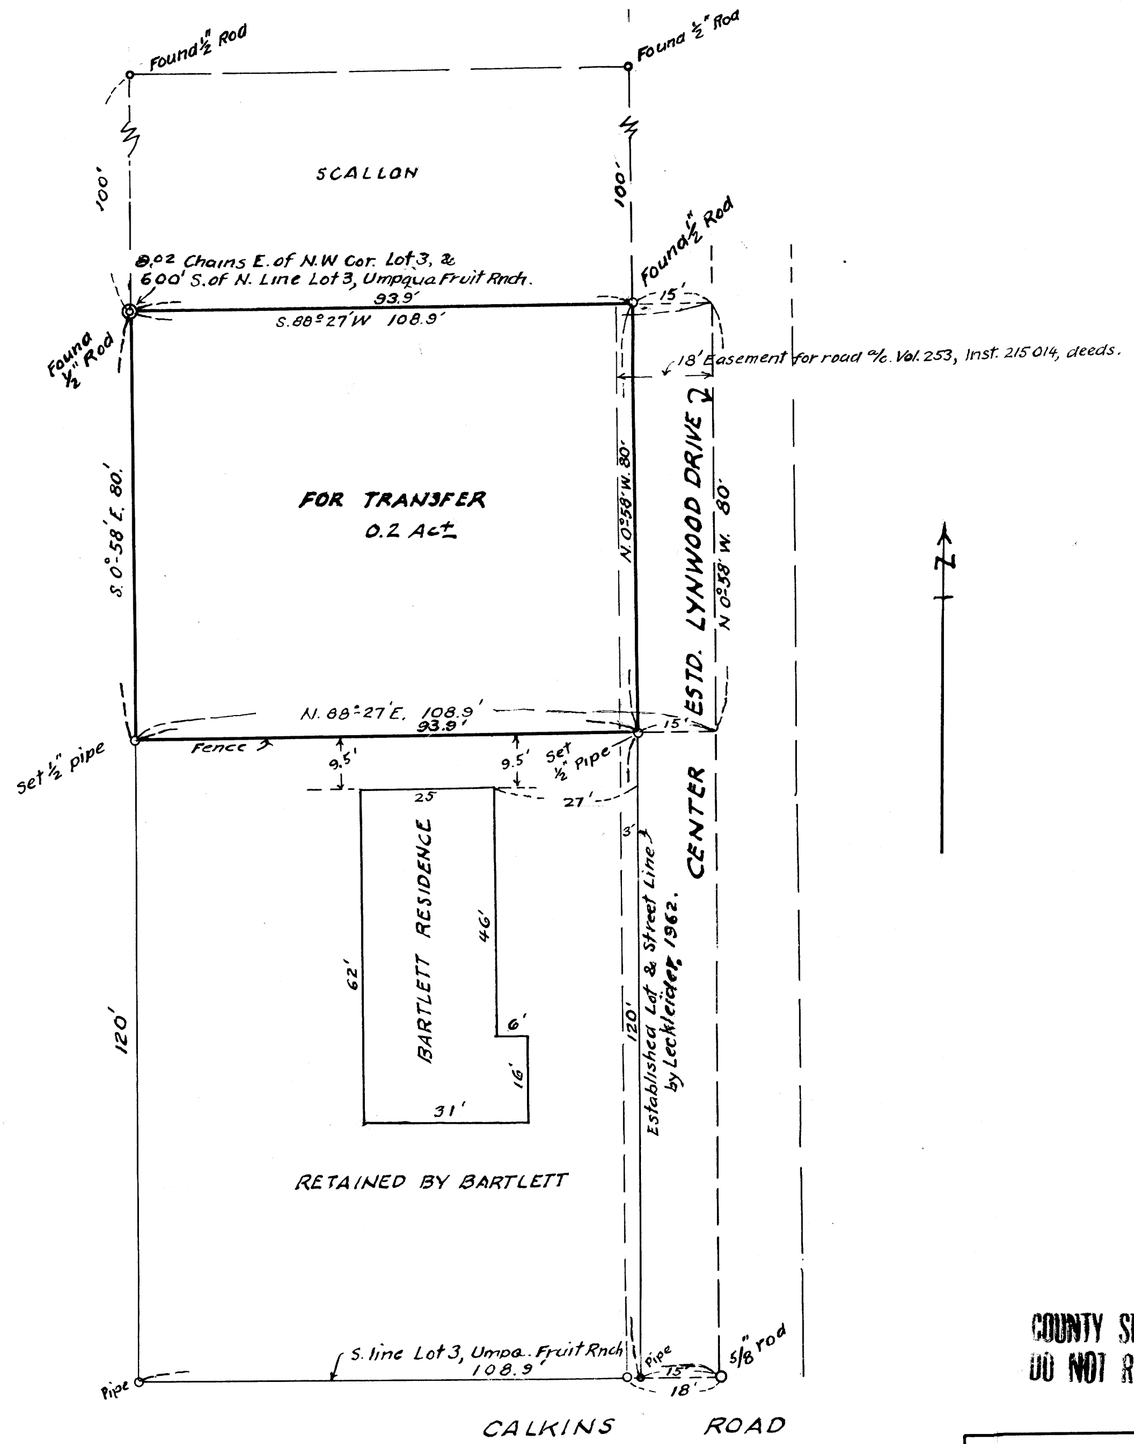

MAP FILE M 27-29

FILED
RECEIVED
FEB 5 1964
COUNTY SURVEYOR
DOUGLAS COUNTY, ORE.

COUNTY SURVEYORS FILE DATA
DO NOT REMOVE FROM OFFICE

RICHARD J. & JOAN M. BARTLETT PROPERTY
IN LOT 3, UMPQUA FRUIT RANCH
SEC. 14, T. 27S; R. 6W, W.M;
DOUGLAS COUNTY, ORE.
JAN. 1964 1"=20 ft.

Arthur Boyer

REGISTERED PROFESSIONAL ENGINEER 1961 OREGON ARTHUR BOYER

M 27-29