COUNTY SURVEYOR'S FILE
DO NOT REMOVE FROM FILE

M 27-39

SEC 21 T 25 S R 6 W
W.M.

20' Road Easement Survey For Conrad Jones
Surveyed By Don Garrett
Feb. 12, 1964
Scale 1" = 200'
Bearings are Based on a Solar Observation

o — Set 5/8" X 30" I. Rod

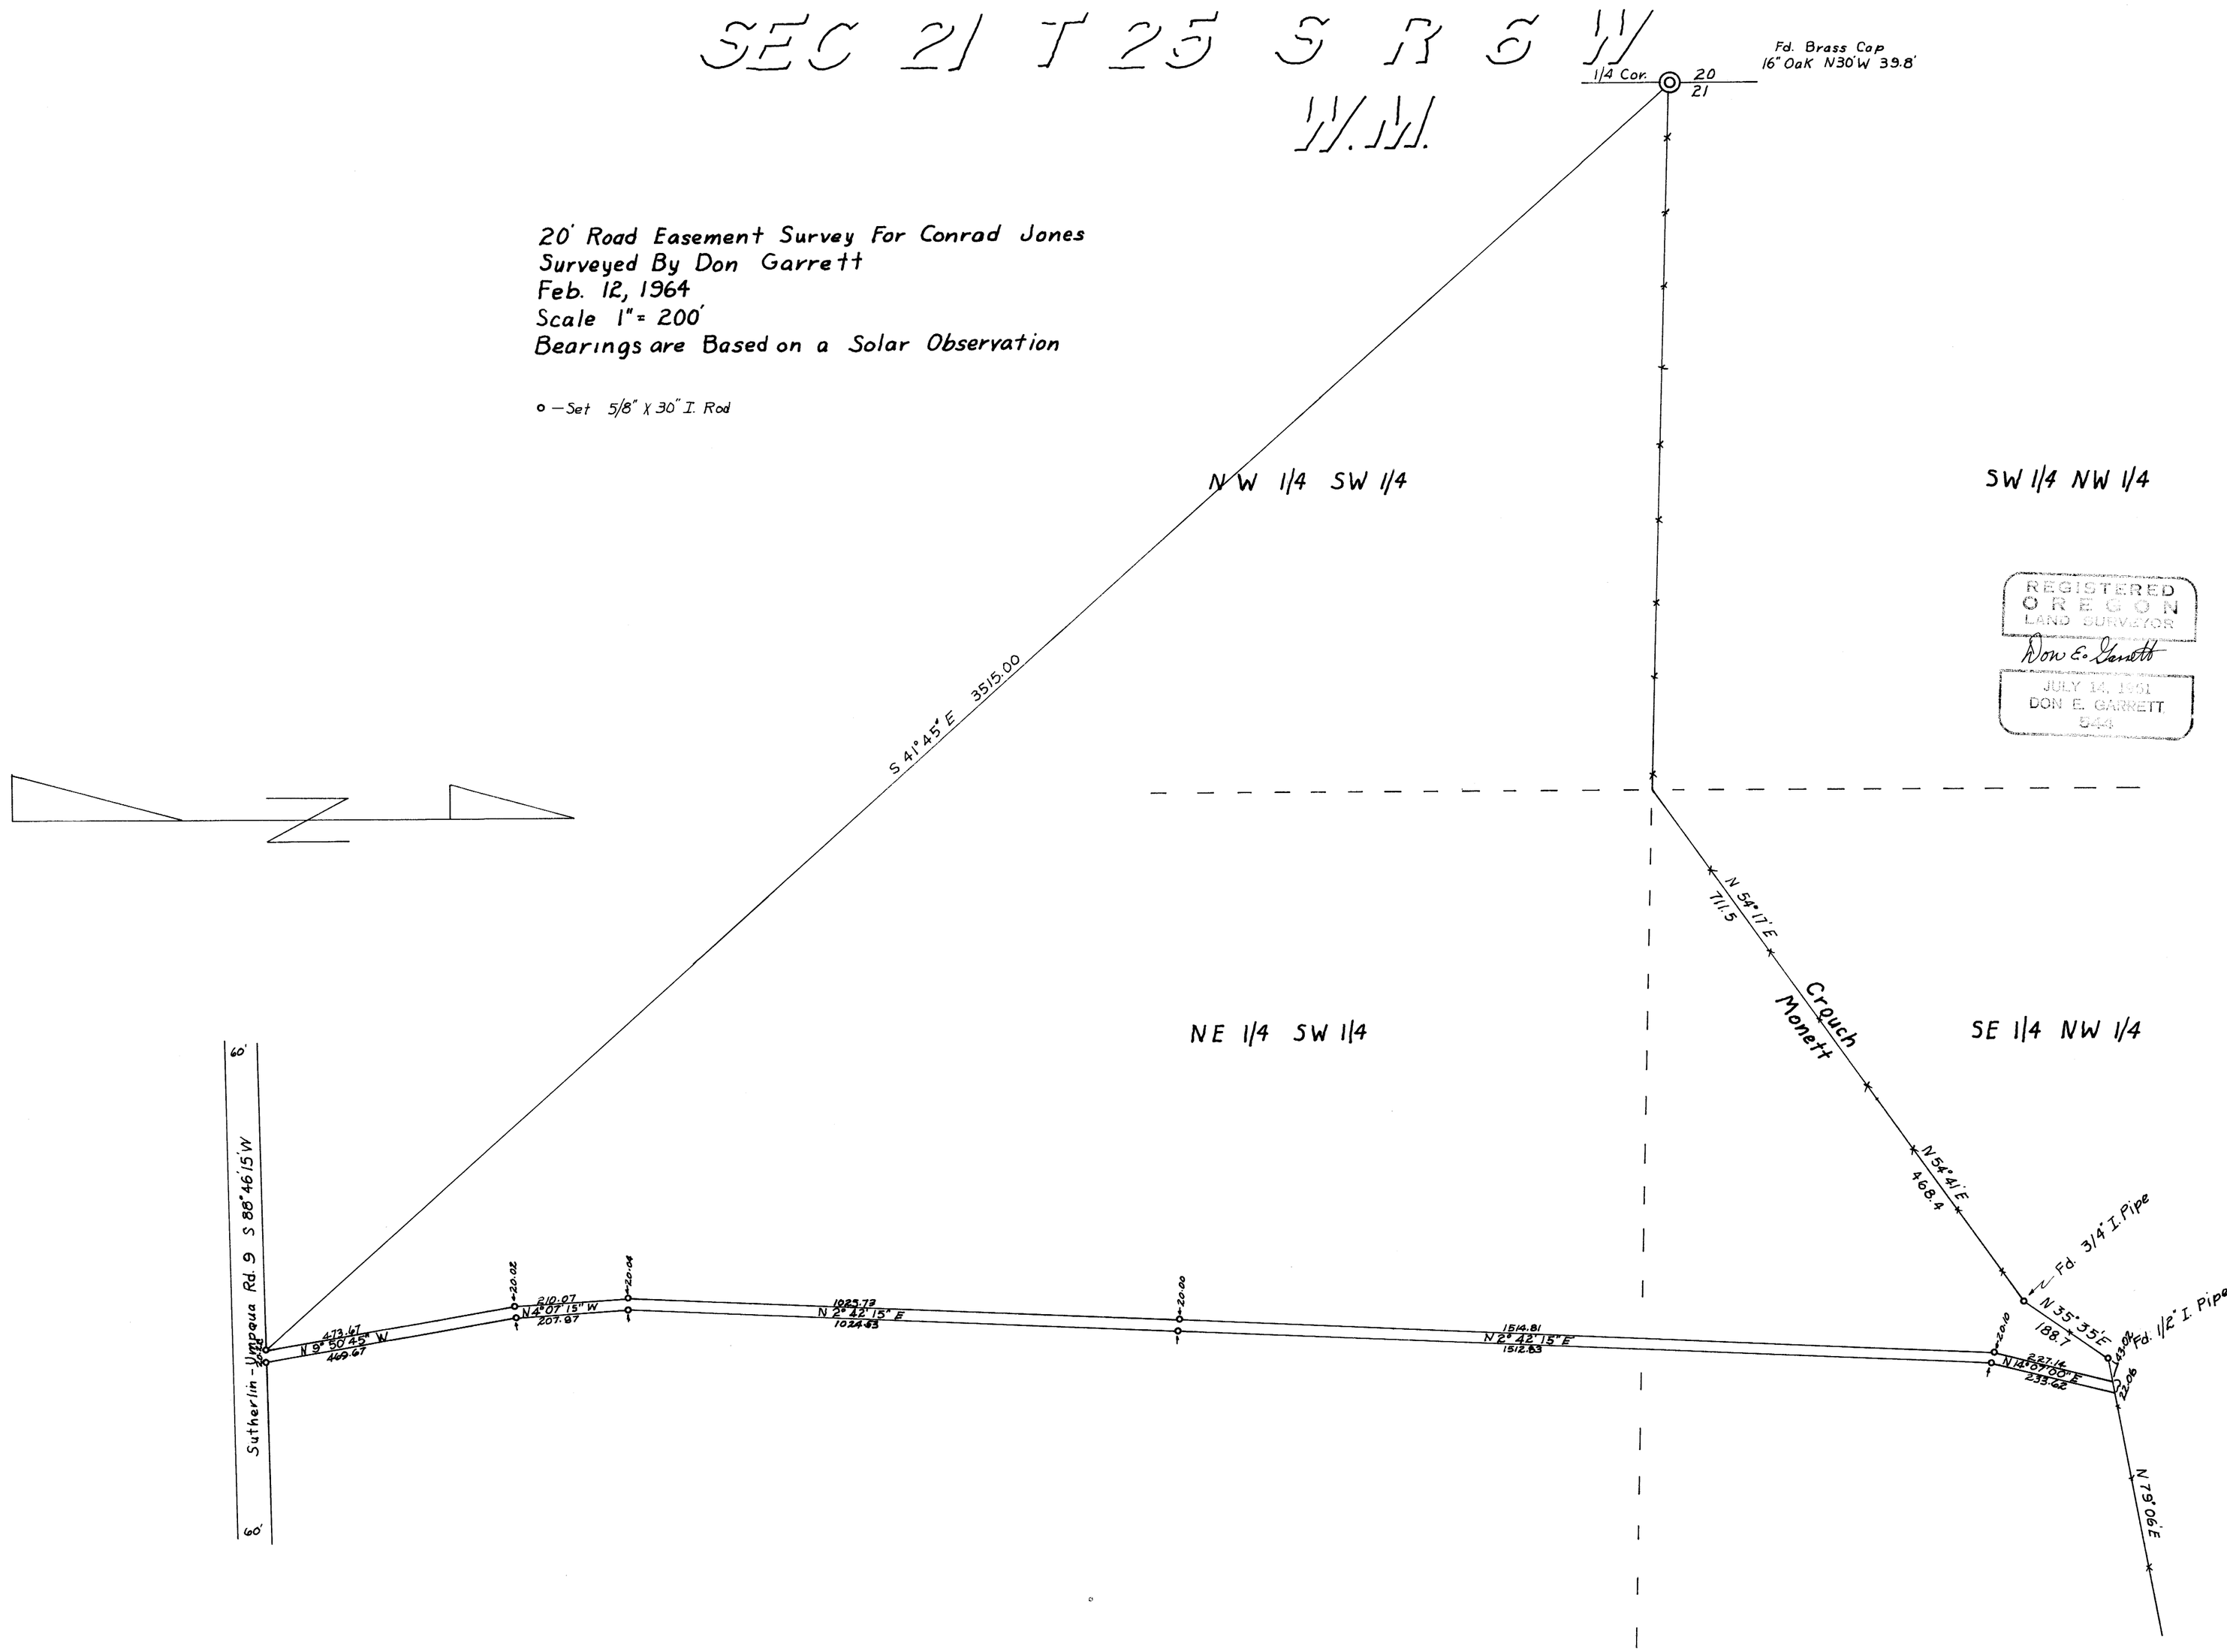

REGISTERED
OREGON
LAND SURVEYOR
Don E. Garrett
JULY 14, 1961
DON E. GARRETT
5449

FILED L.L.
RECEIVED
FEB 14 1964
COUNTY SURVEYOR
DOUGLAS COUNTY, ORE.

MAP FILE 27 T 39