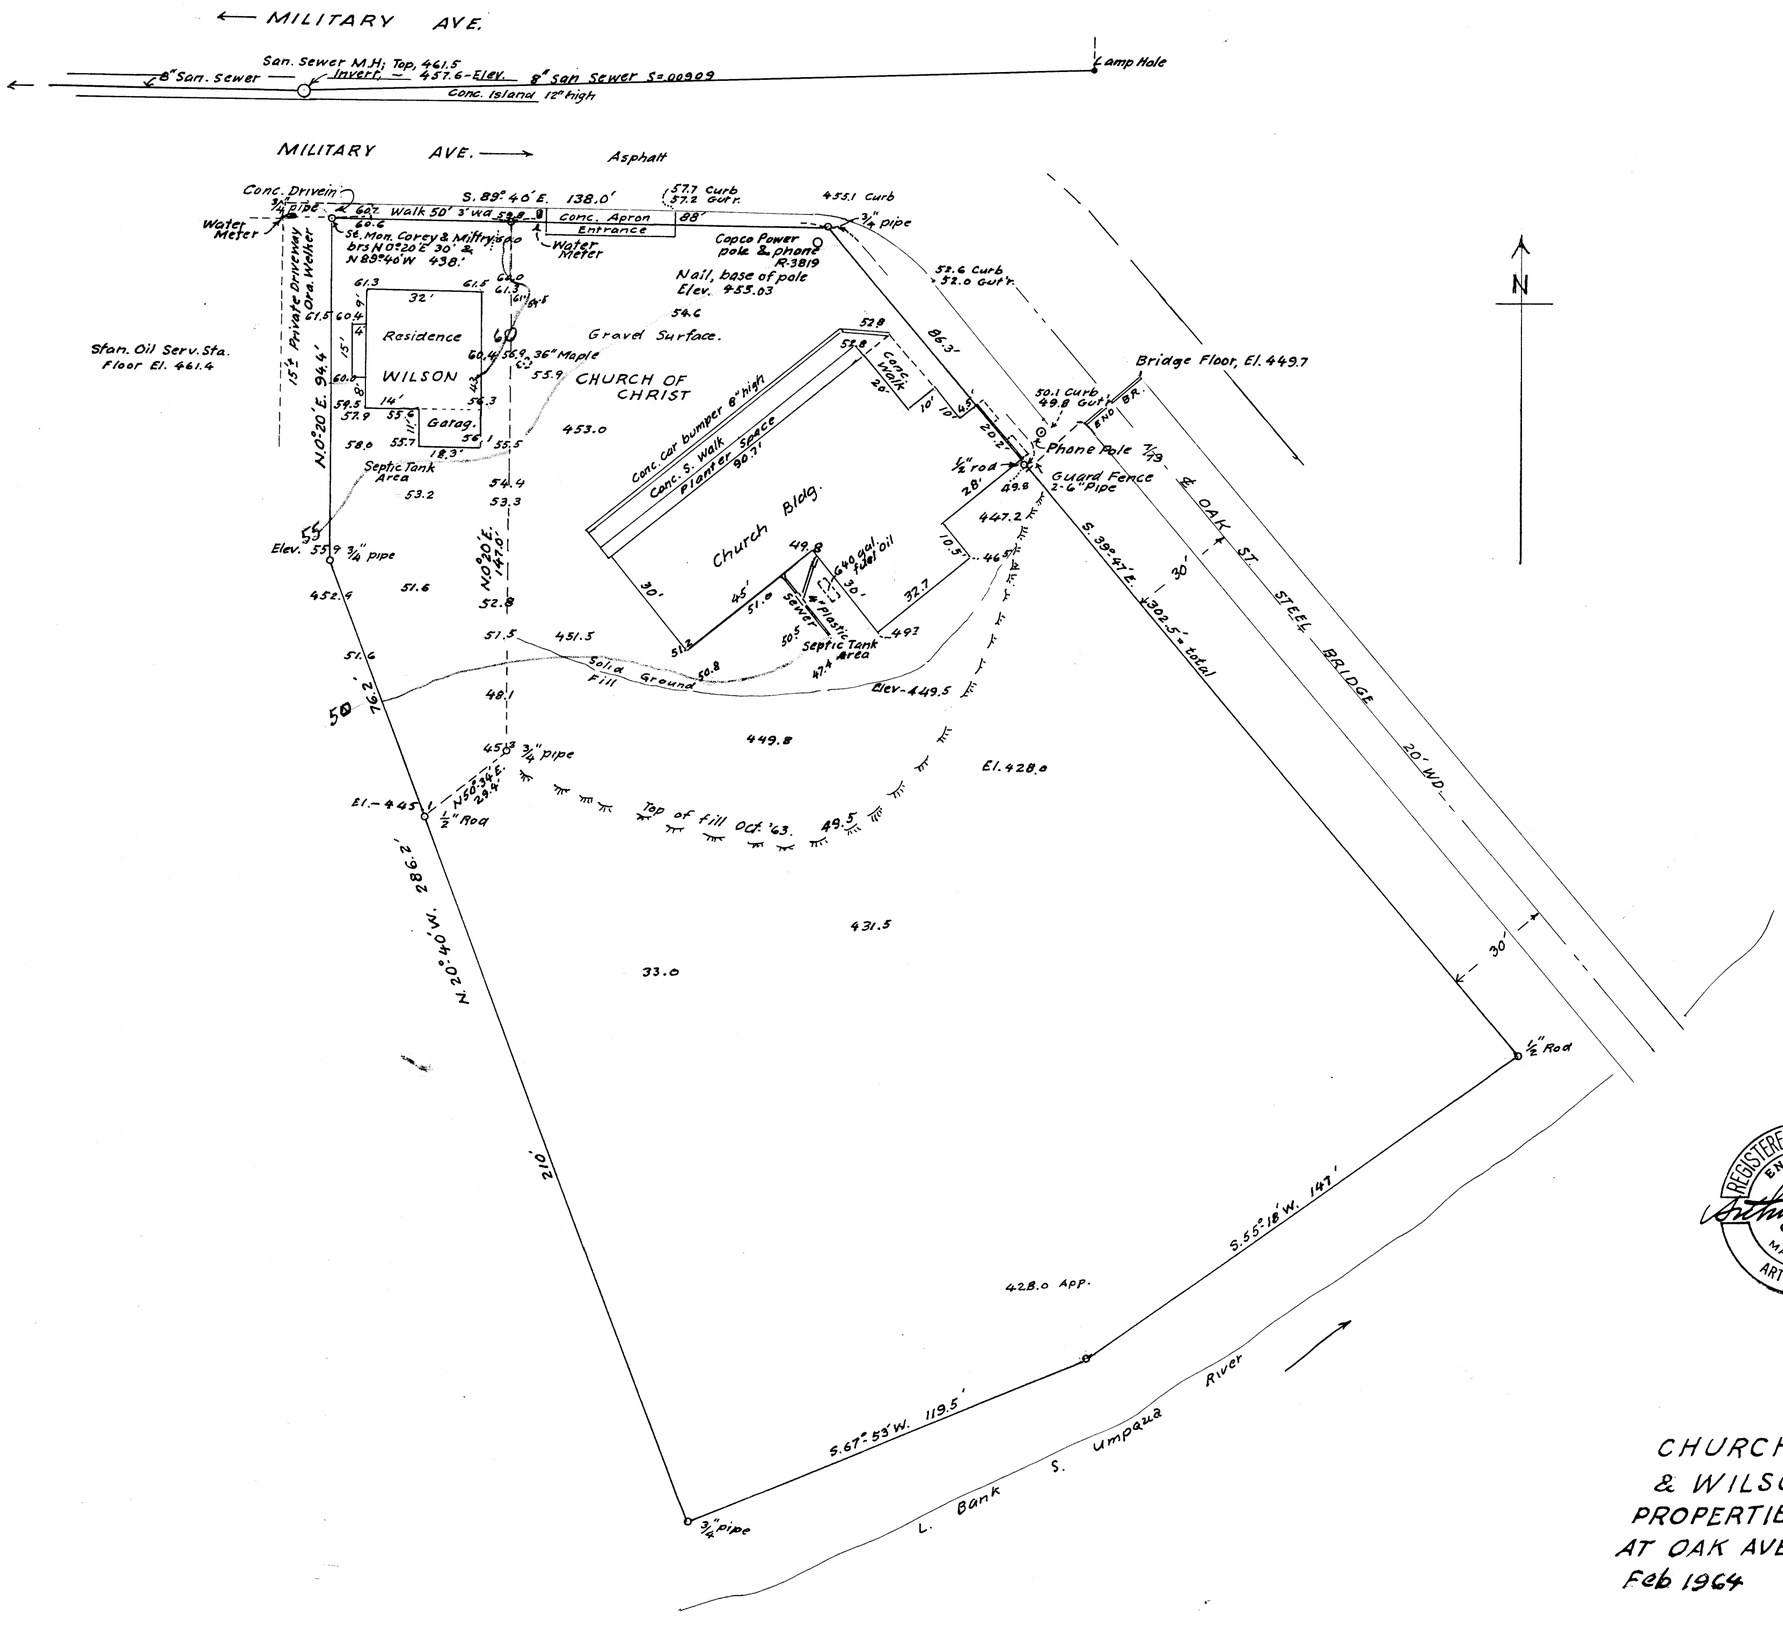

REGISTERED PROFESSIONAL ENGINEER 1581 OREGON MAY 5, 1933 ARTHUR BOYER

FILED
RECEIVED
FEB 8 1964
COUNTY SURVEYOR
DOUGLAS COUNTY, ORE.

CHURCH OF CHRIST
& WILSON METES & BDS.
PROPERTIES, ROSEBURG, ORE;
AT OAK AVE & MILITARY AVE.
Feb 1964 1" = 30 Ft.

COUNTY SURVEYORS FILE DATE
DO NOT REMOVE FROM OFFICE

FILE M.27 T. 50

M 27-50