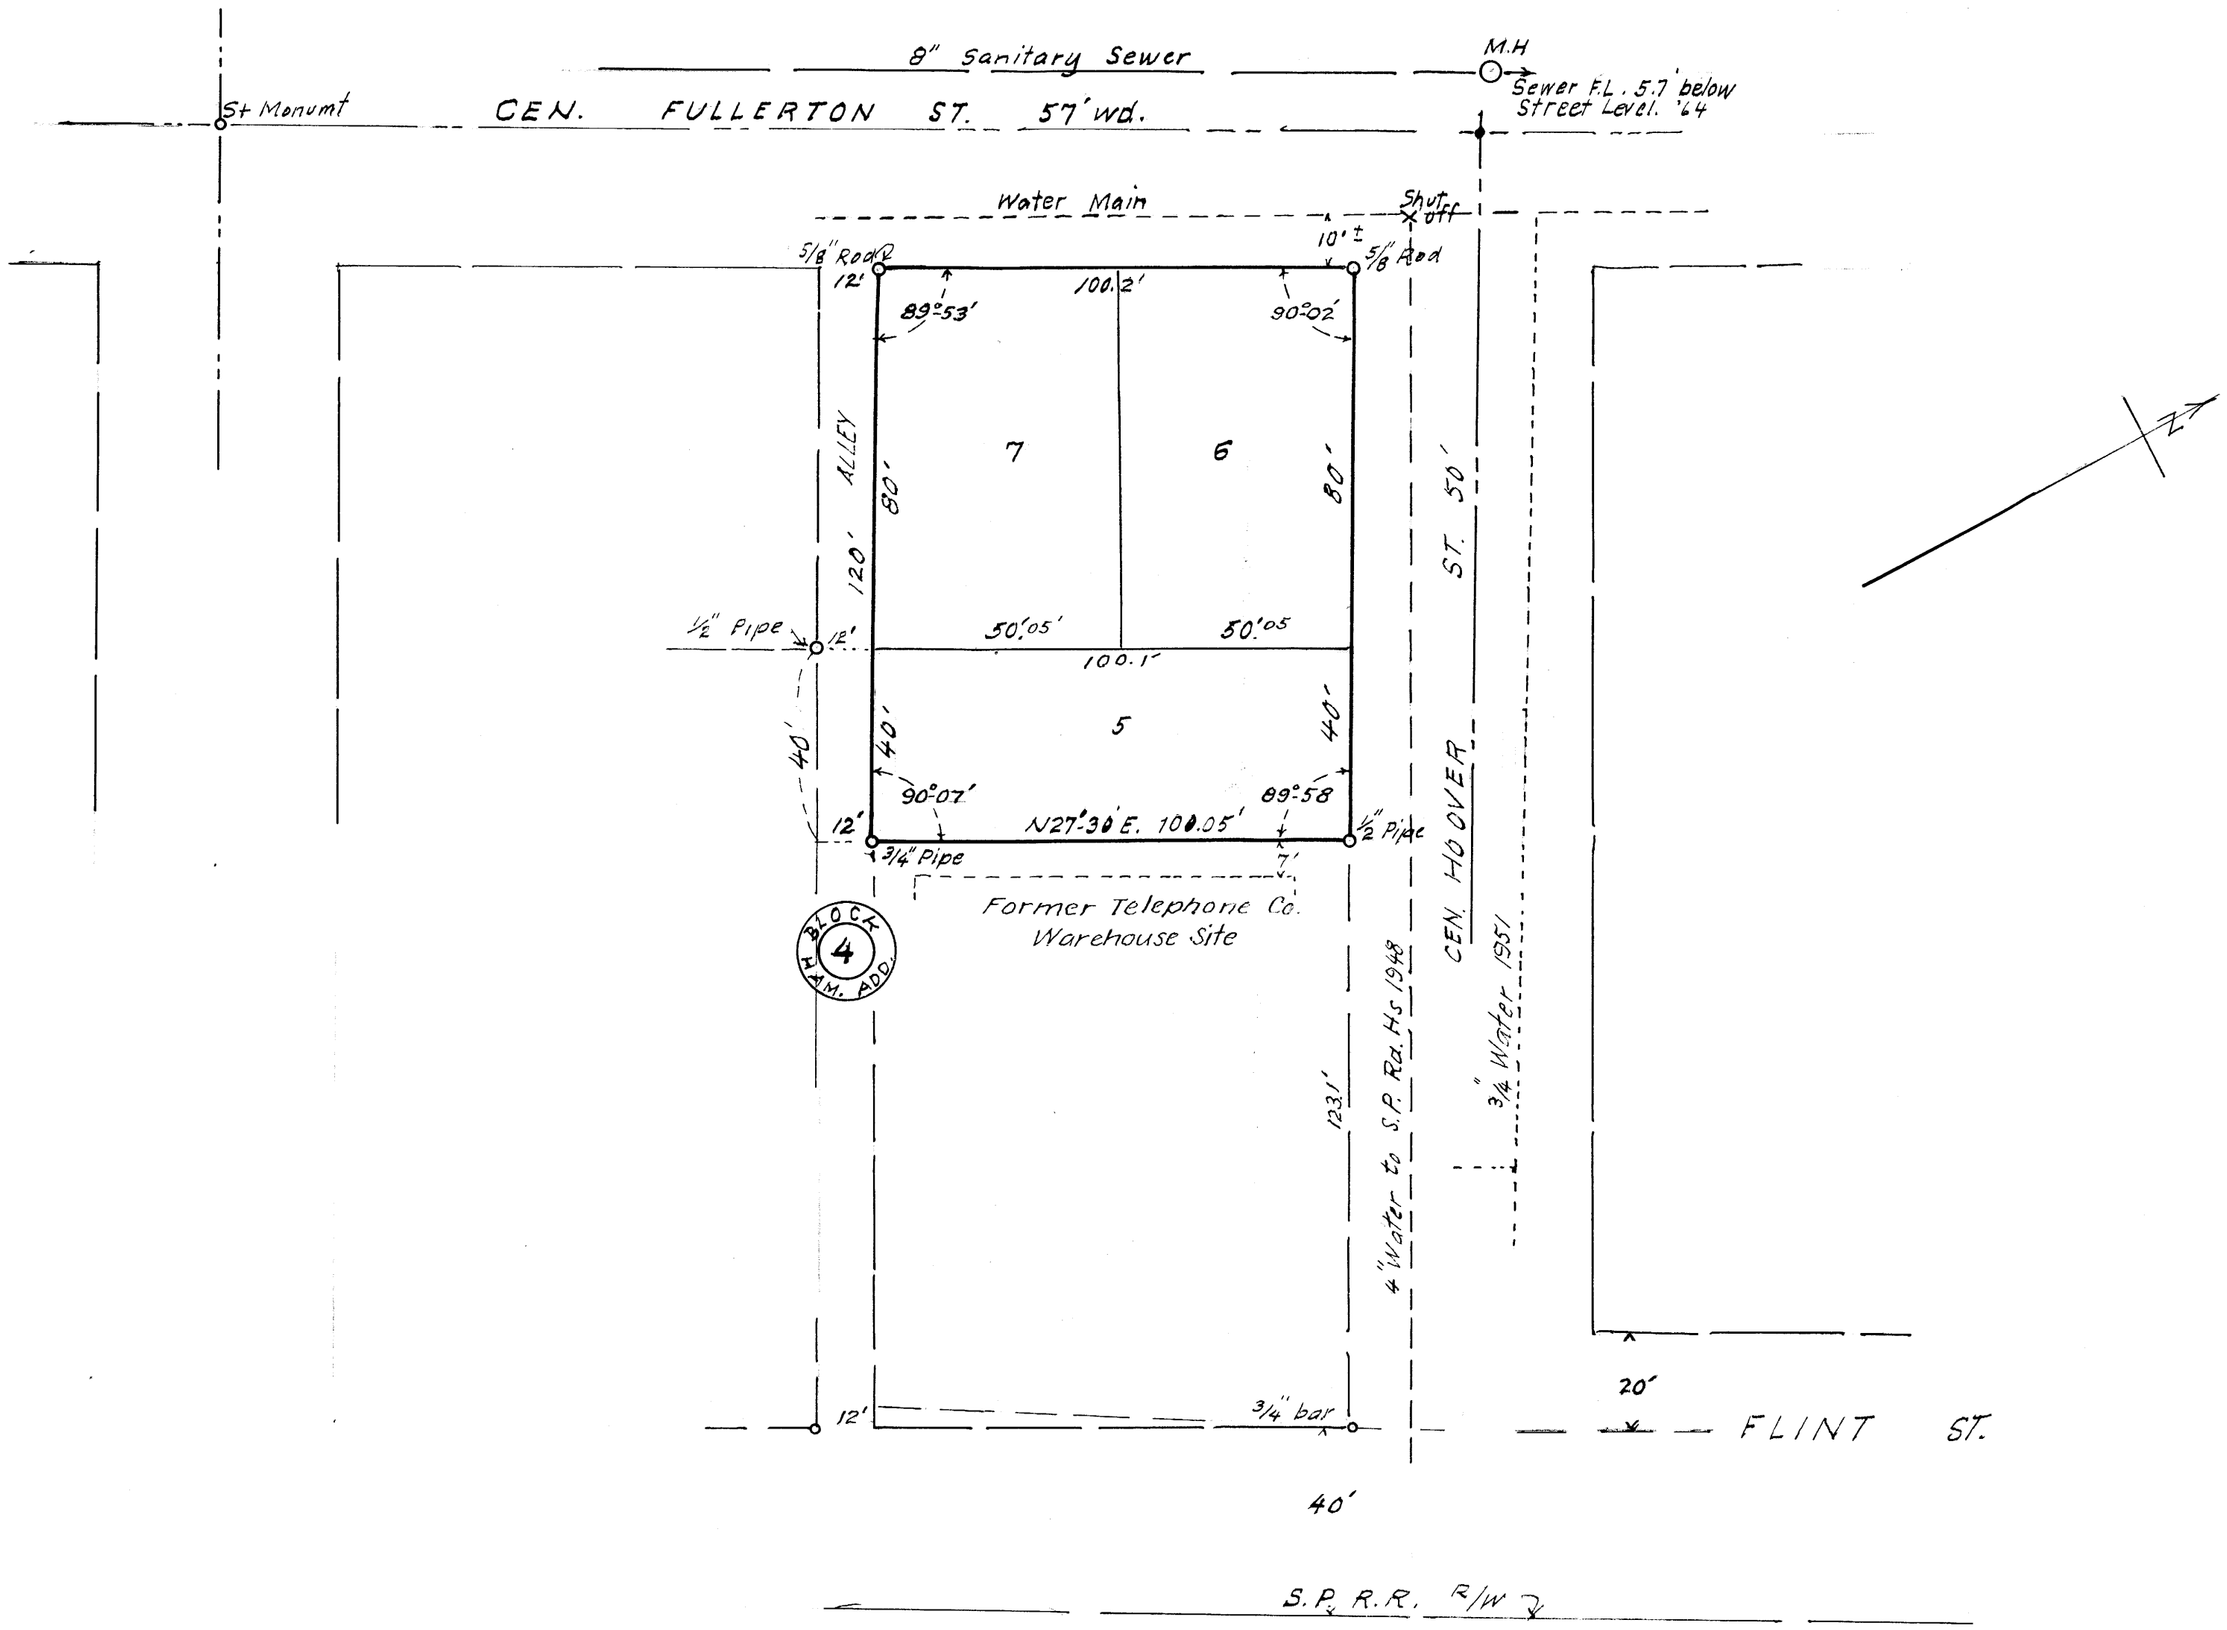

FILED
RECEIVED LL.
MAR 2 1964
COUNTY SURVEYOR
DOUGLAS COUNTY, ORE.

REGISTERED PROFESSIONAL ENGINEER 1581 OREGON MAY 5, 1933 ARTHUR BOYER

MILLER & DIMMICK
LOTS 5, 6 & 7, HAMILTONS ADD; BL. 4,
ROSEBURG, ORE.
FEB. 1964 1"=30'

COUNTY SURVEYORS FILE MAP
DO NOT REMOVE FROM OFFICE

MAP FILE M 27-51

M 27-51