LOT 2 SEC 7 T 27S R 2W W.M.

LOT 8 SEC 12 T 27 S R 3W W.M.

FILED
RECEIVED
APR 15 1964
COUNTY SURVEYOR
DOUGLAS COUNTY, ORE.

M 27-66

DO NOT REMOVE FROM OFF

Surveyed For Opal Lynch
Surveyor Don Garrett
April 14, 1964
Scale 1" = 50'
• — Set 5/8" I. Rod

Bearings are Based on the East Line of Sec. 12 N 0°30'00" W

REGISTERED
OREGON
LAND SURVEYOR
Don E. Garrett
JULY 14, 1961
DON E. GARRETT
544

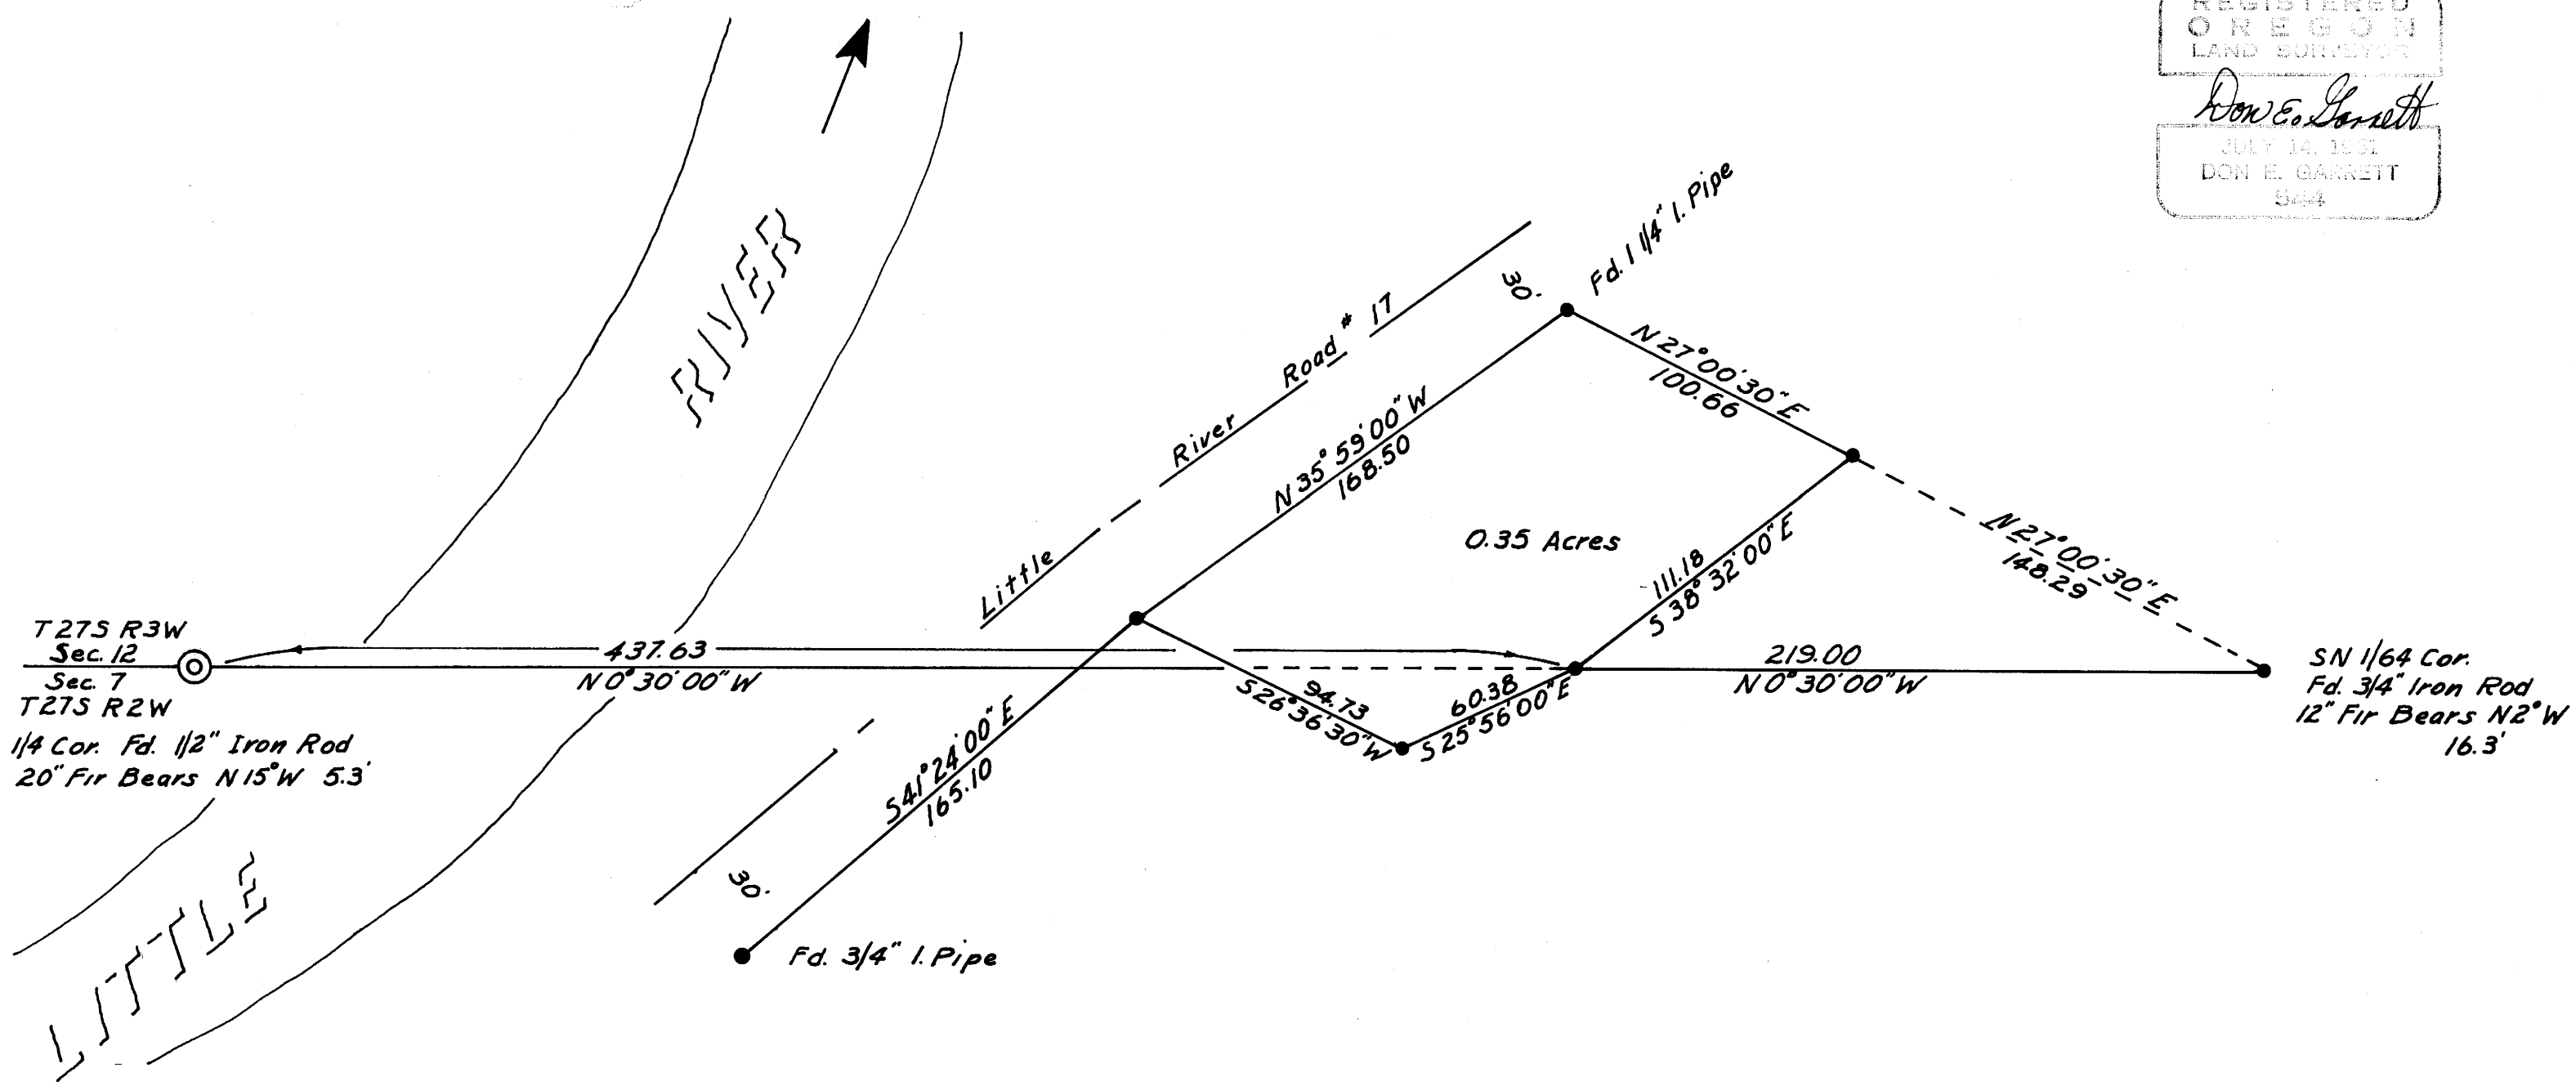

FILE M 27-66