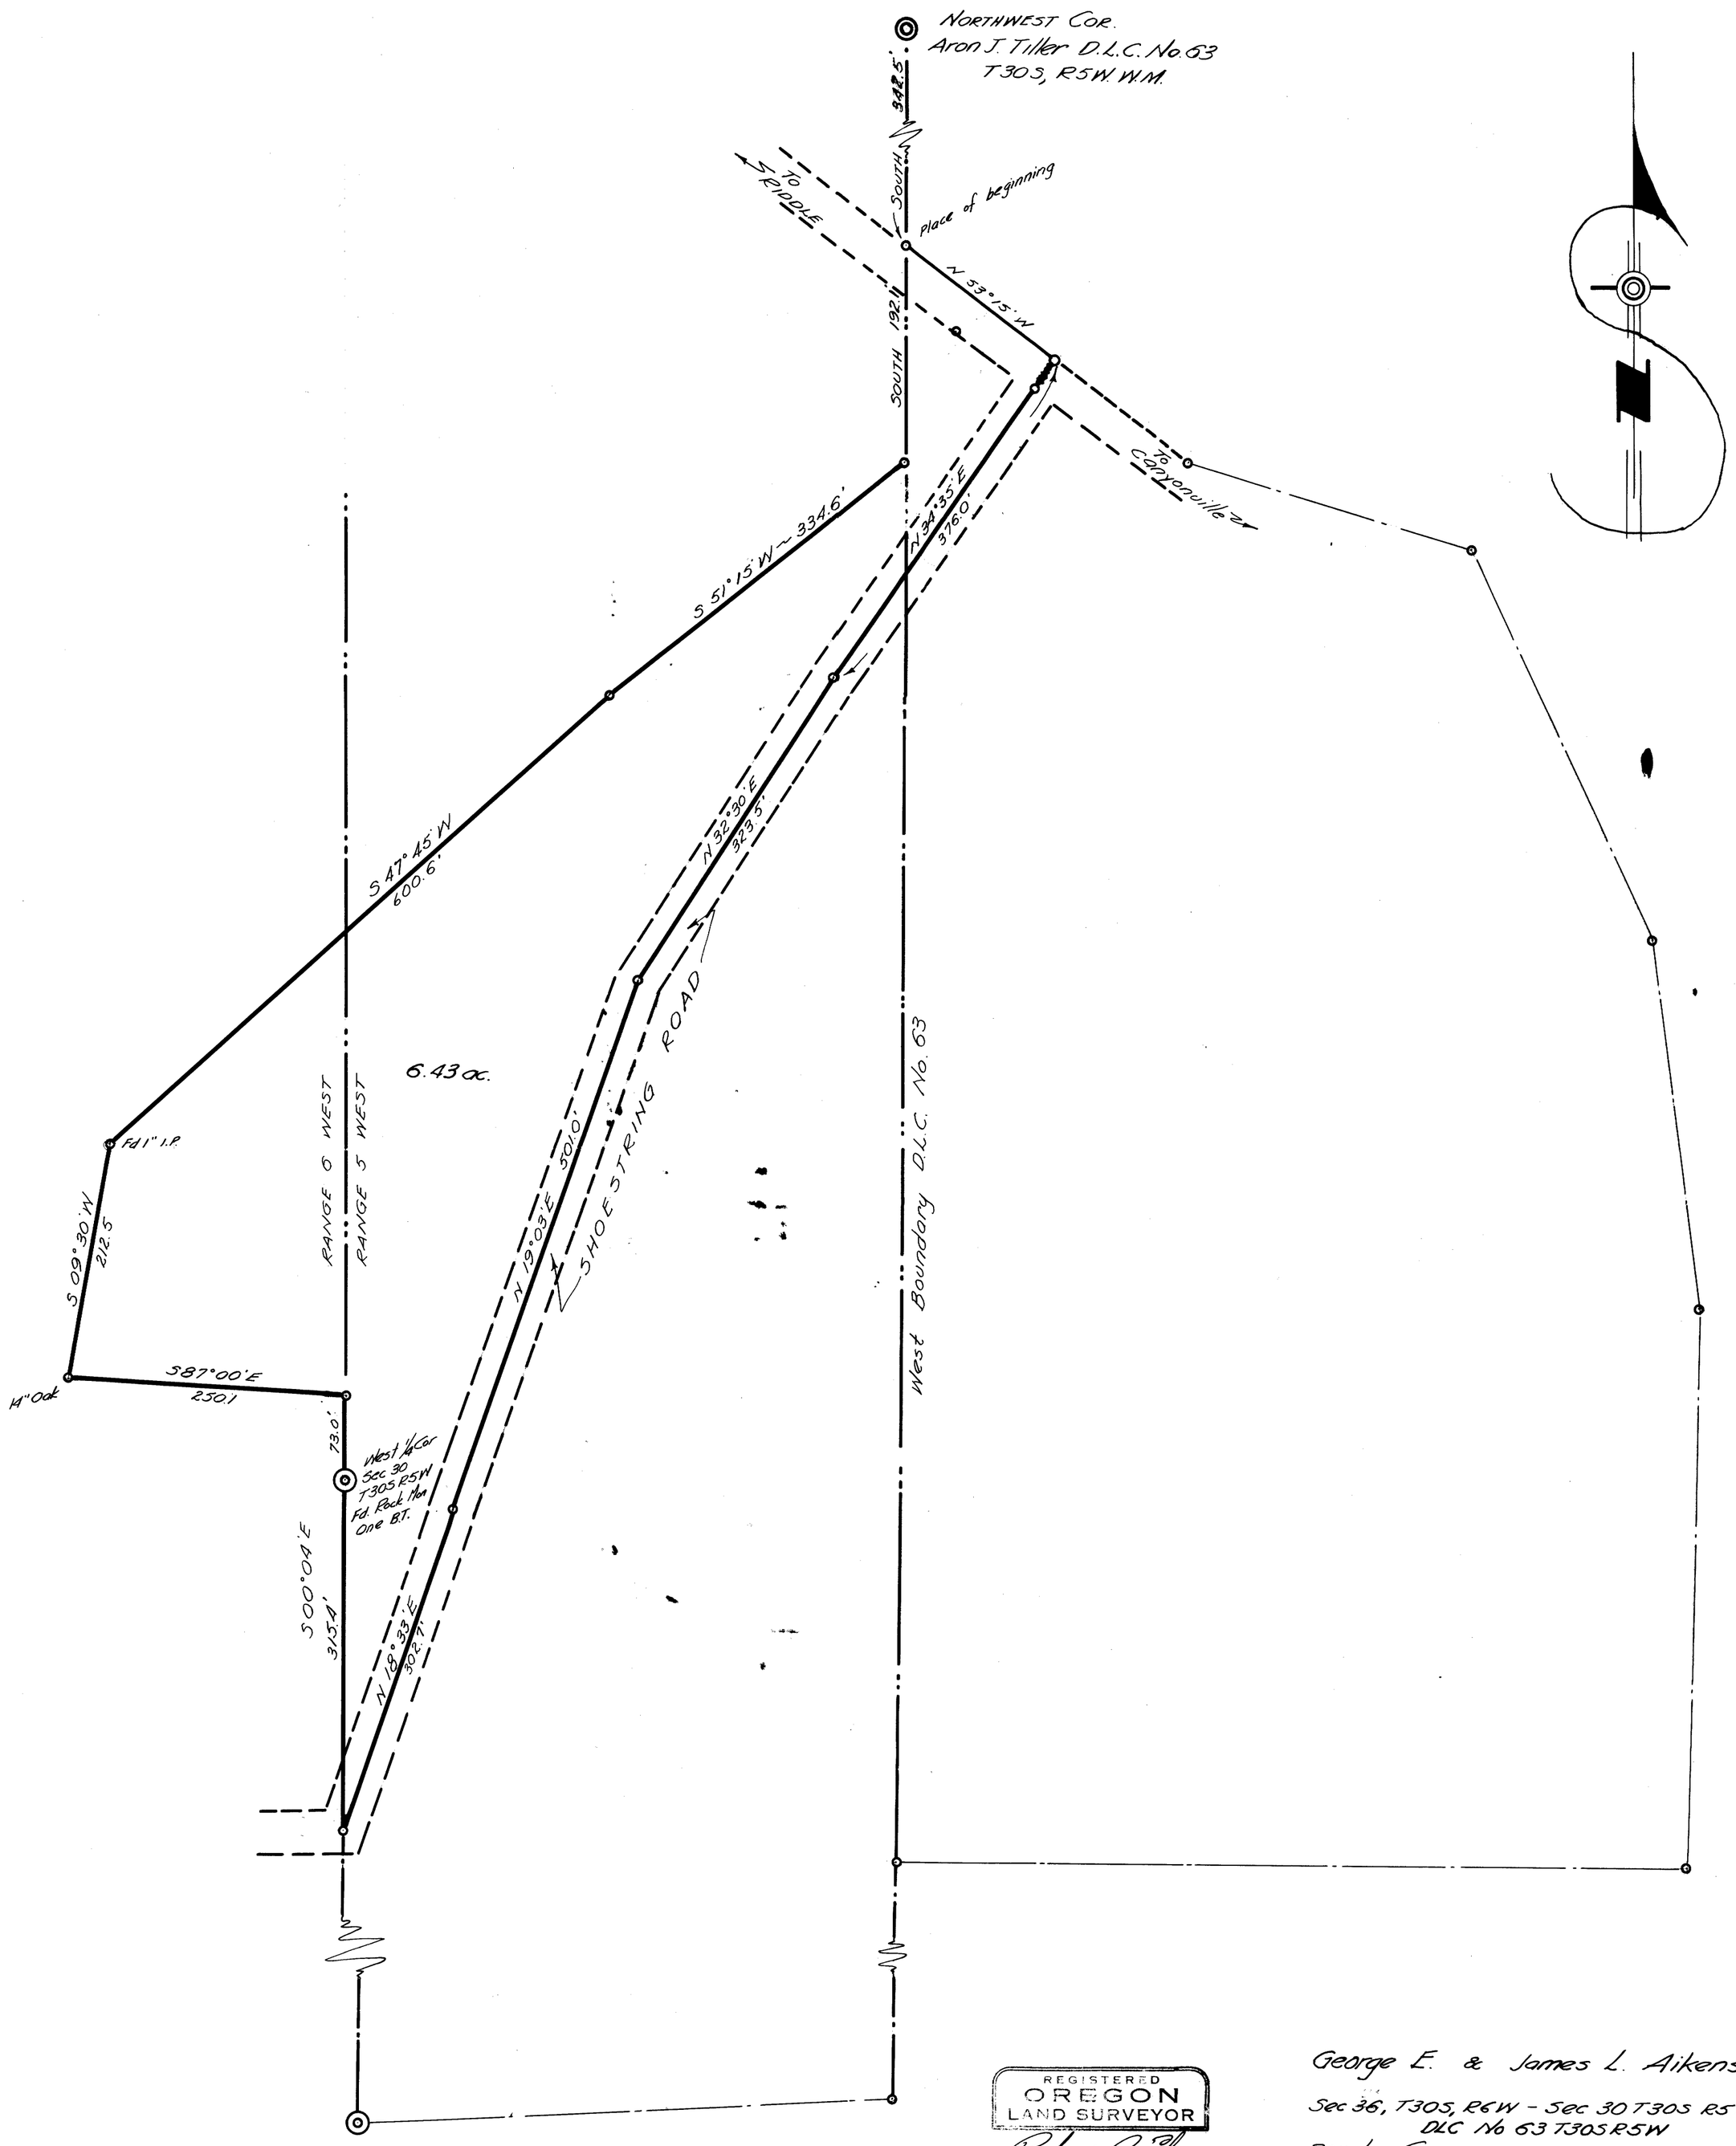

REGISTERED
OREGON
LAND SURVEYOR
Richard R. Ecker
NOVEMBER 9, 1945
RICHARD R. ECKER
158

George E. & James L. Aikens

Sec 36, T30S, R6W - Sec 30 T30S R5W
DLC No 63 T30S R5W

Douglas Co. Oregon

Nov 1946 Scale: 1" = 100'

COUNTY SURVEYORS FILE DATA
DO NOT REMOVE FROM OFFICE