MAP FILE M.28 P.15

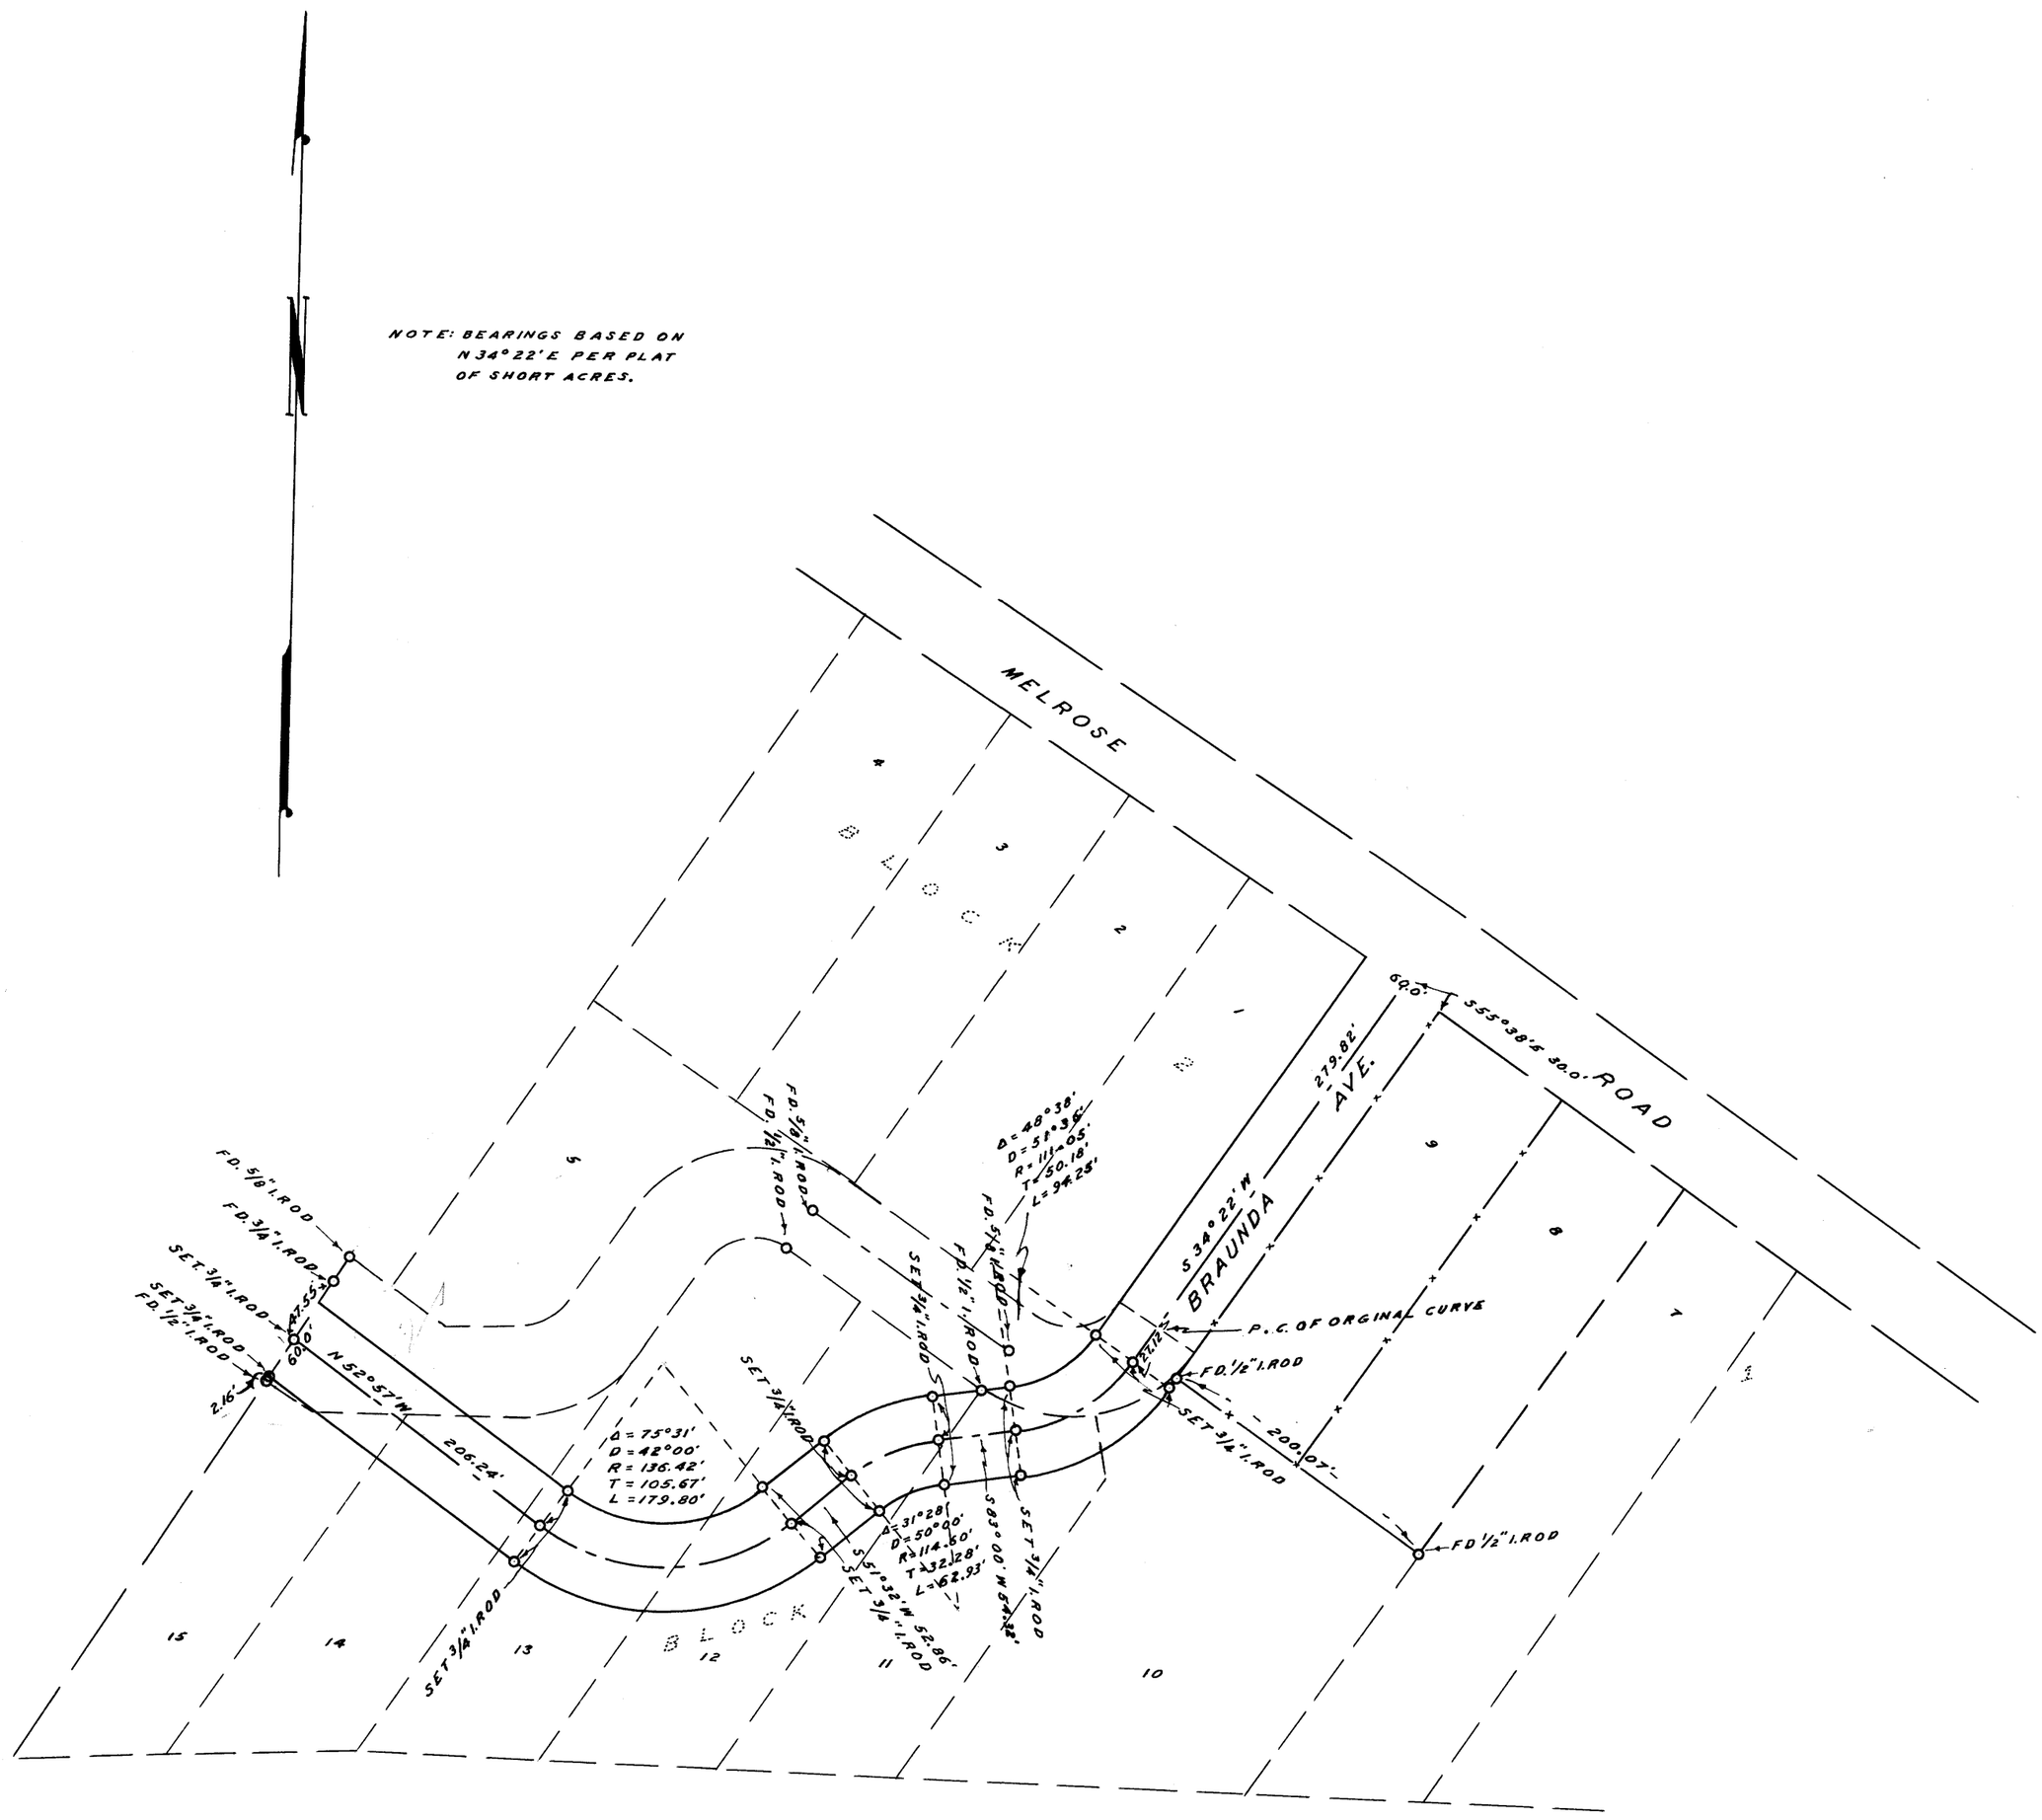

SURVEY TO RE-ALINE BRAUNDA AVE.
IN SHORT ACRES, SEC. 16 T. 27 S., R. 6 W.

SURVEYED JUNE 8, 1964 BY
JAMES W. BYRON SCALE: 1" = 100'
SURVEYED FOR WM. GARRISON

COUNTY SURVEYOR'S FILE
DO NOT REMOVE FROM

REGISTERED
OREGON
LAND SURVEYOR

James W. Byron

NOV. 6, 1953
JAMES W. BYRON
303

FILED
RECEIVED
JUN 16 1964
COUNTY SURVEYOR
DOUGLAS COUNTY, ORE.

MAP FILE M.28 P.15