COUNTY SURVEYORS FILE DA
DO NOT REMOVE FROM OFF

SURVEY TO ESTABLISH PROPERTY LINES IN LOT 1, BLOCK 18 AMENDED PLAT 'O', S.L.& W. CO., SEC. 17, T 25 S, R 5 W.

SURVEYED FOR - L. & H. LUMBER CO.
SURVEYED BY - W. S. BARNES

JULY 1964
SCALE 1" = 40'

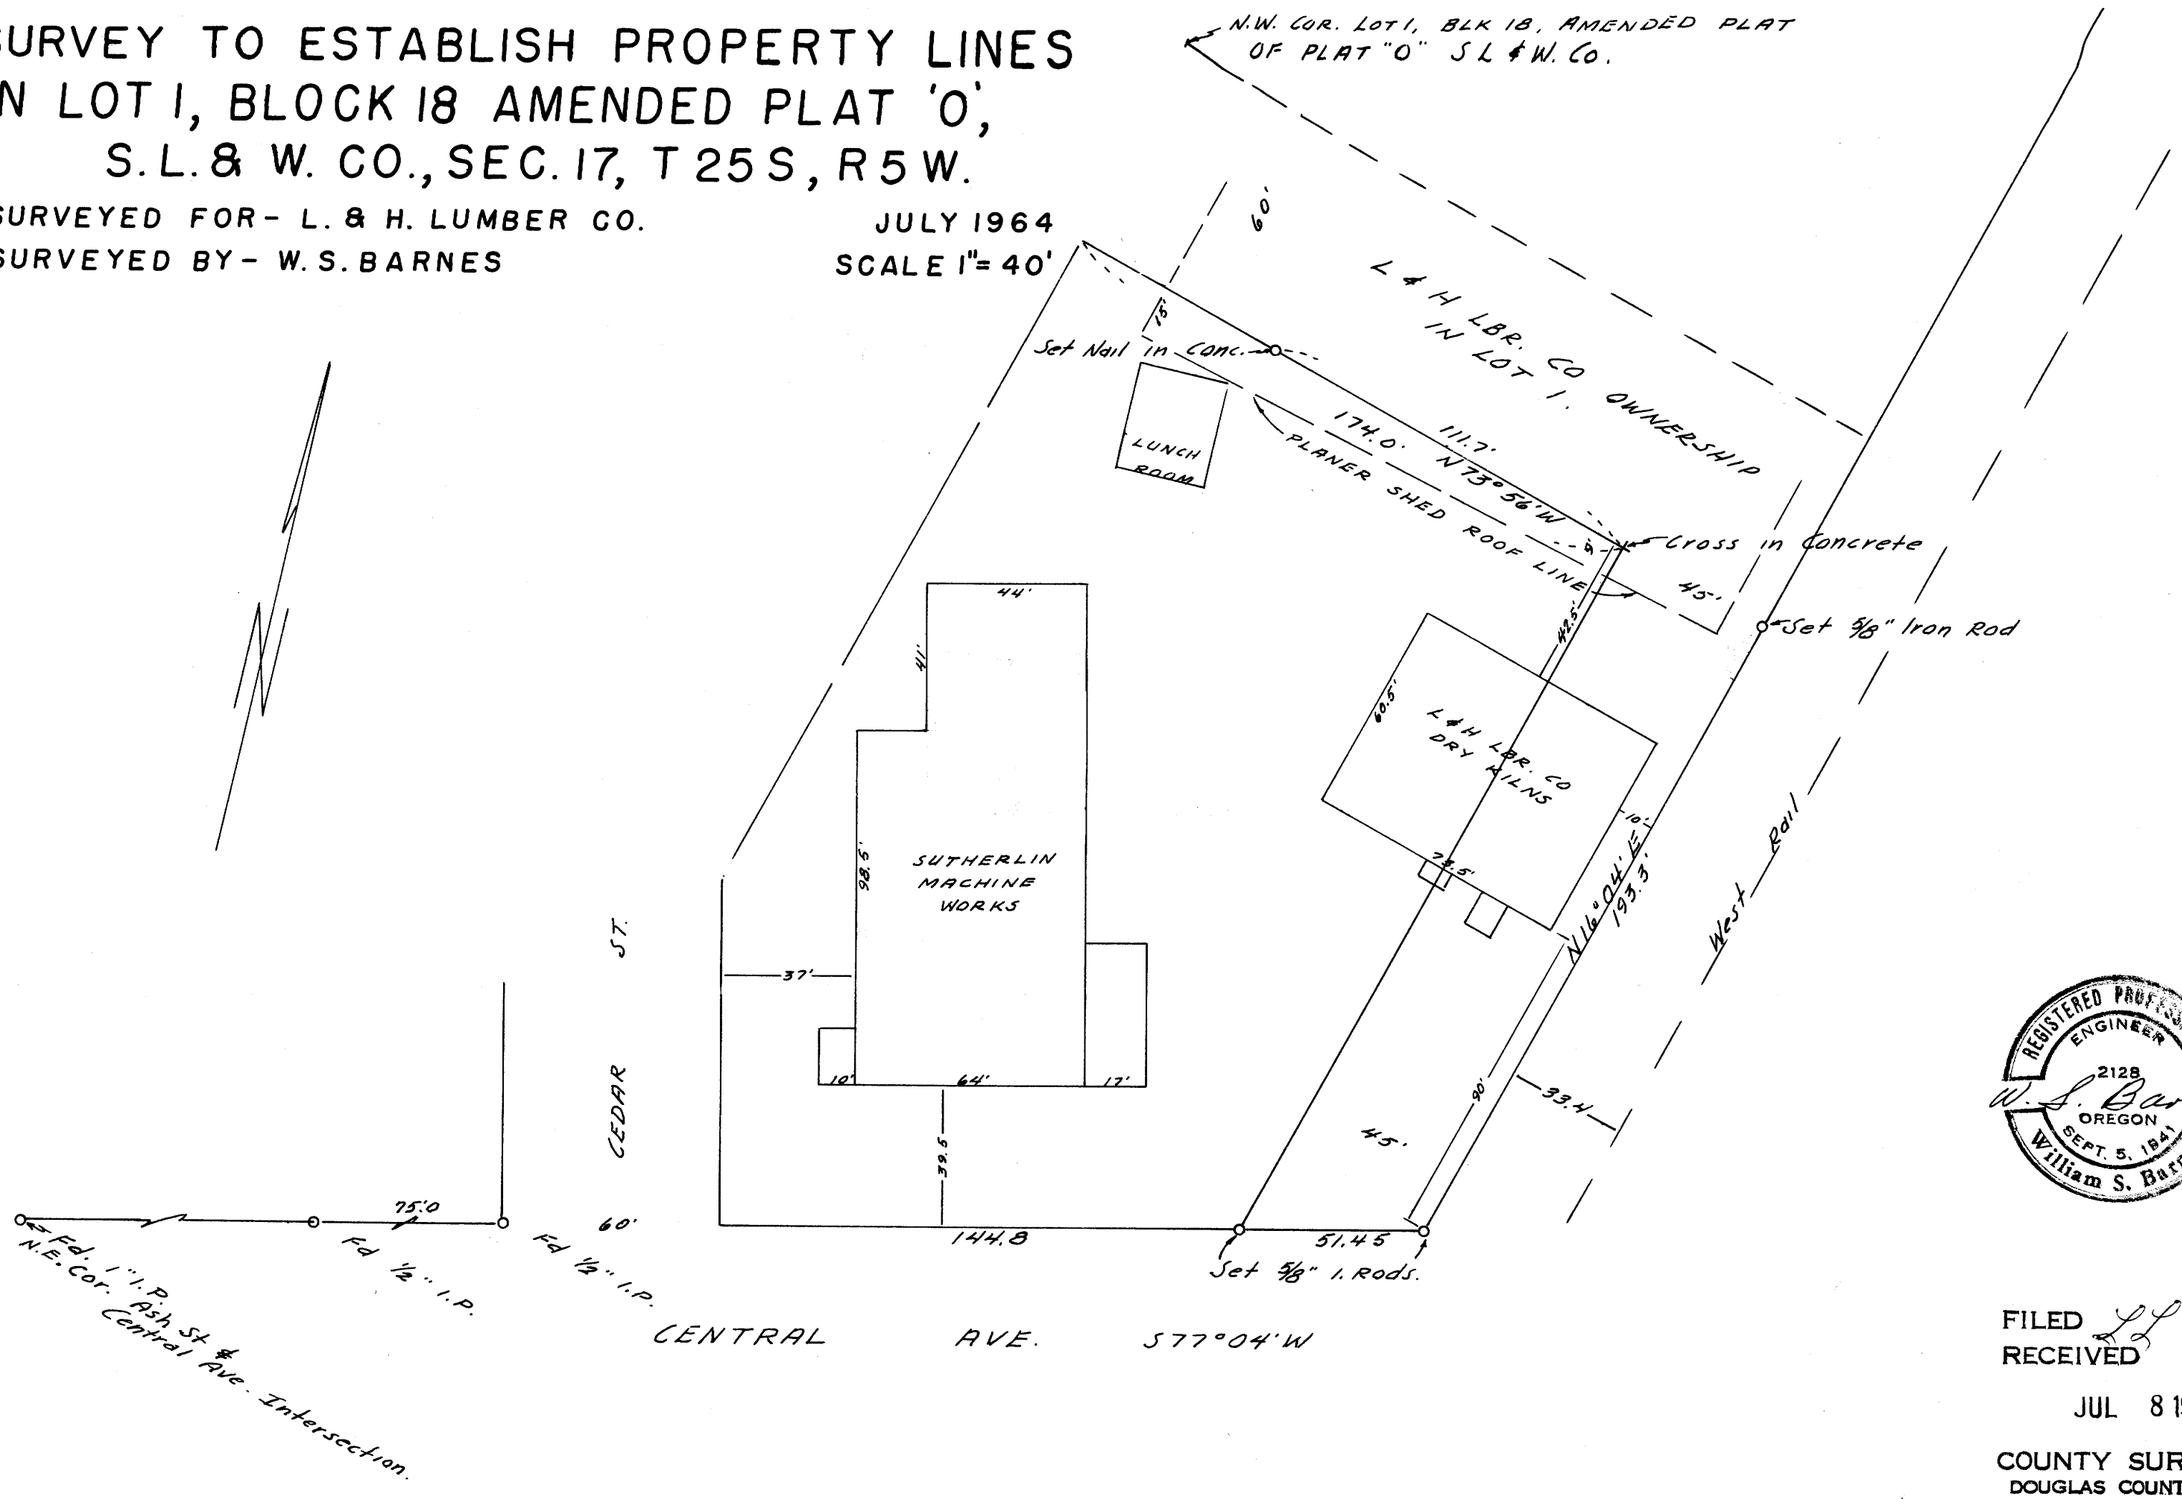

C.S. File 52-294
Map File M 28-27

REGISTERED PROFESSIONAL ENGINEER 2128 OREGON SEPT. 5, 1941 William S. Barnes
W. S. Barnes

FILED
RECEIVED
JUL 8 1964
COUNTY SURVEYOR
DOUGLAS COUNTY, ORE.

M 28-27