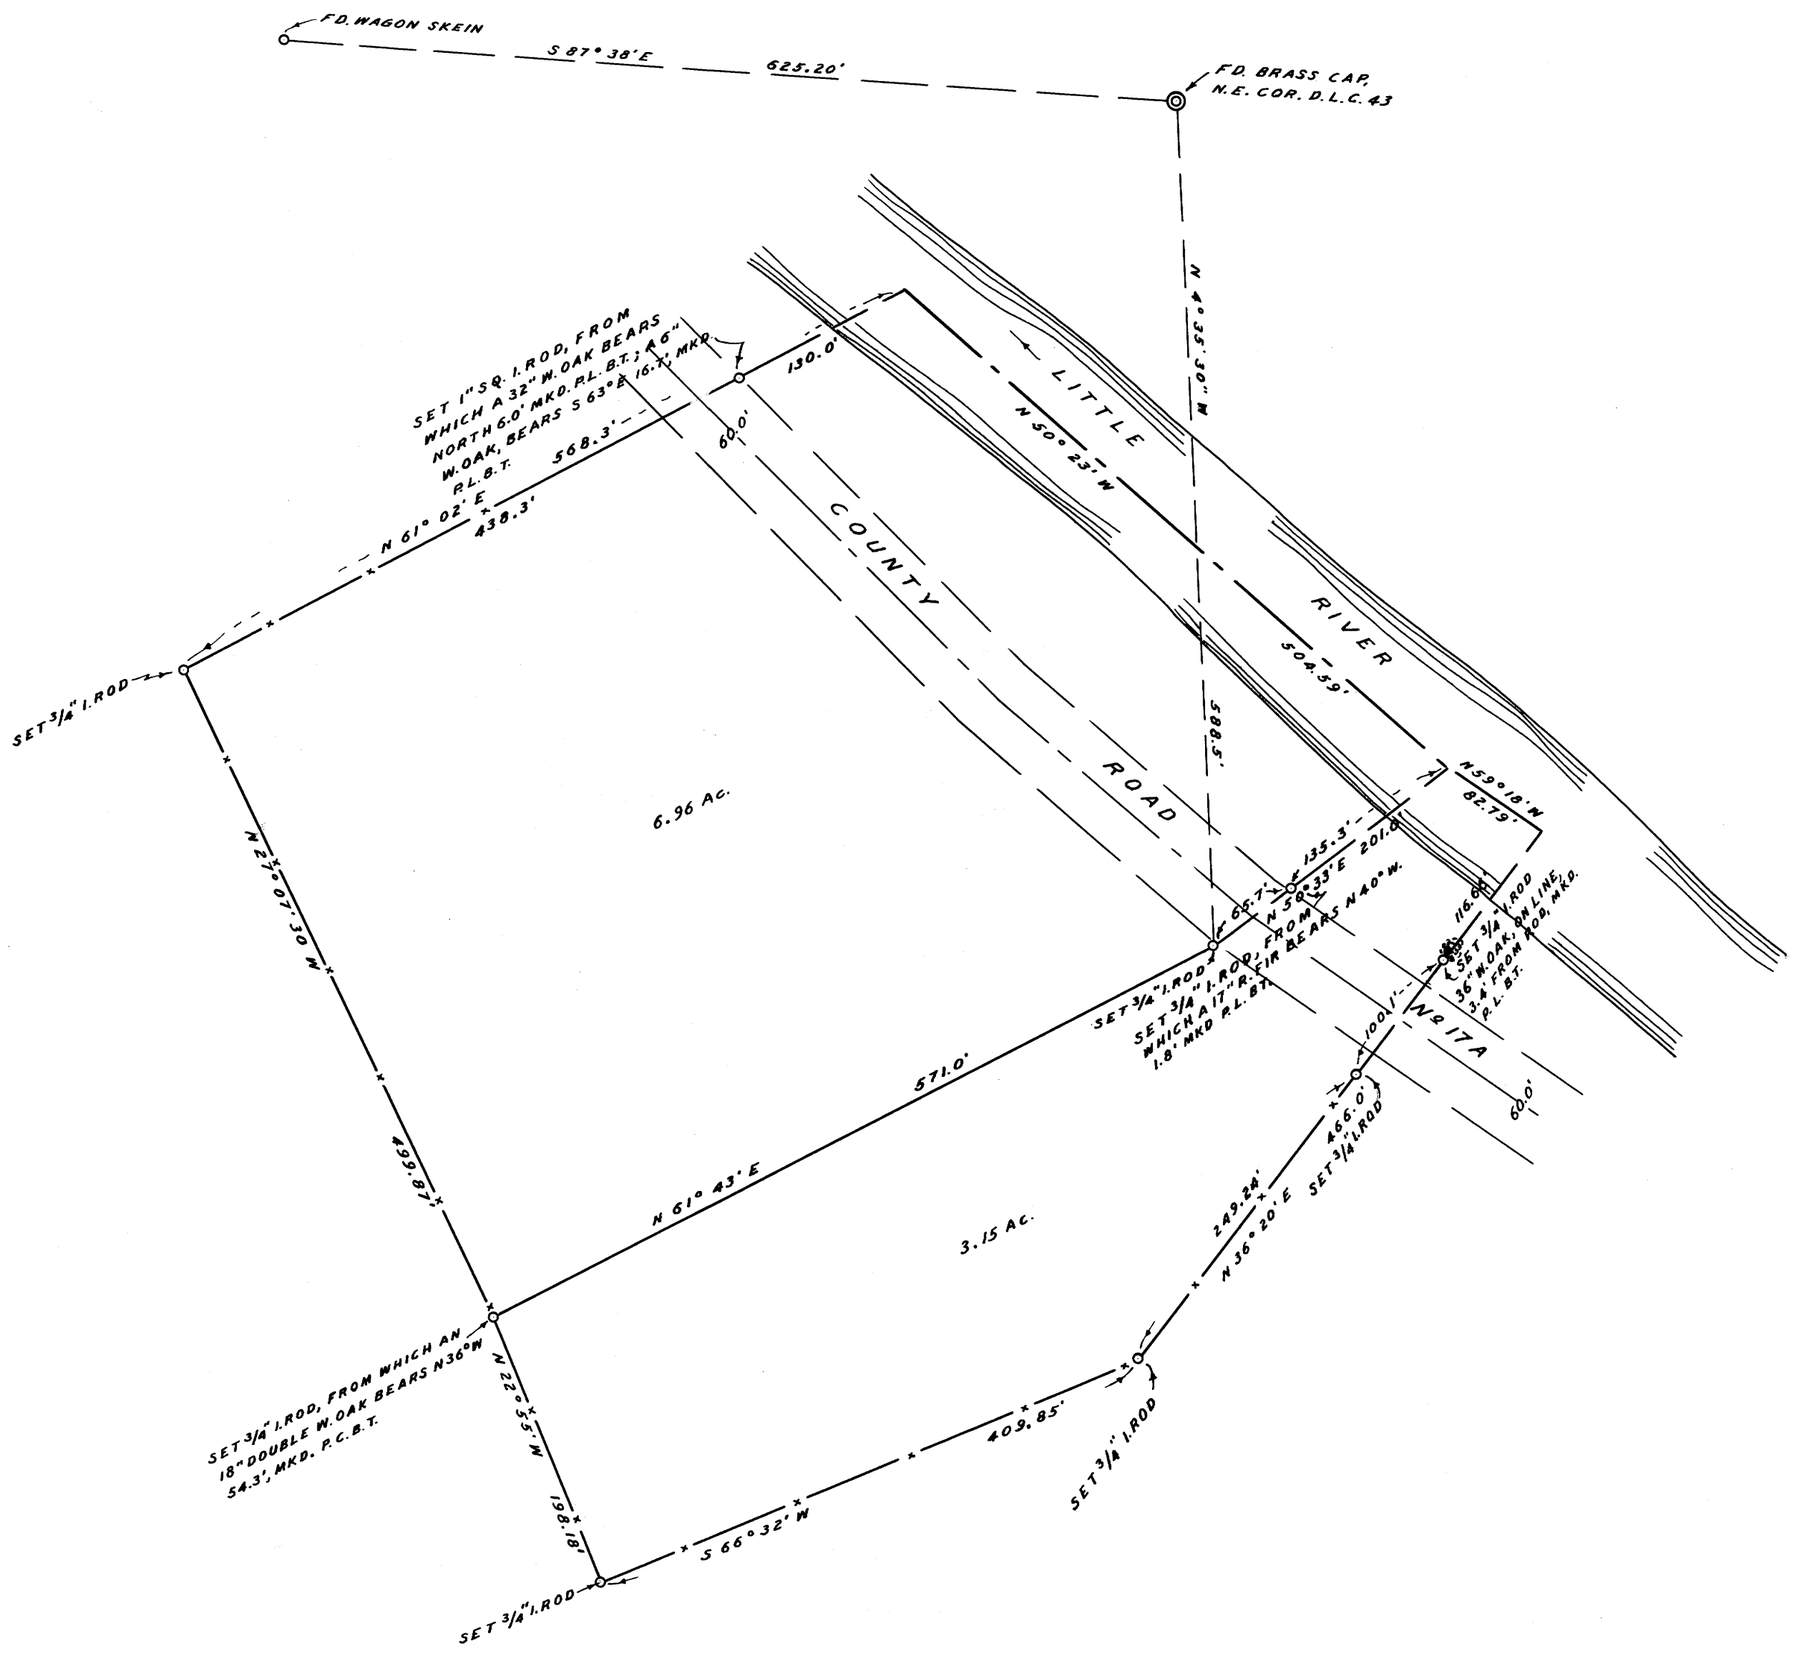

NOTE: BEARINGS ARE MAGNETIC.
VAR. 20° 00'

SURVEY FOR DEED DESCRIPTION
SECTION 30, T. 26 S., R. 3 W. W. M.

SURVEYED MAY 16, 1964 BY
JAMES W. BYRON SCALE: 1" = 100'
SURVEYED FOR W. BLANCK & LOUIS PUGH

REGISTERED
OREGON
LAND SURVEYOR

James W. Byron

NOV. 6, 1953
JAMES W. BYRON
303

FILED
RECEIVED
MAY 28 1964
COUNTY SURVEYOR
DOUGLAS COUNTY, ORE.

COUNTY SURVEYORS FILE DATA
DO NOT REMOVE FROM OFFICE

MAP FILE M28 T 7

MAP FILE M28 T 7