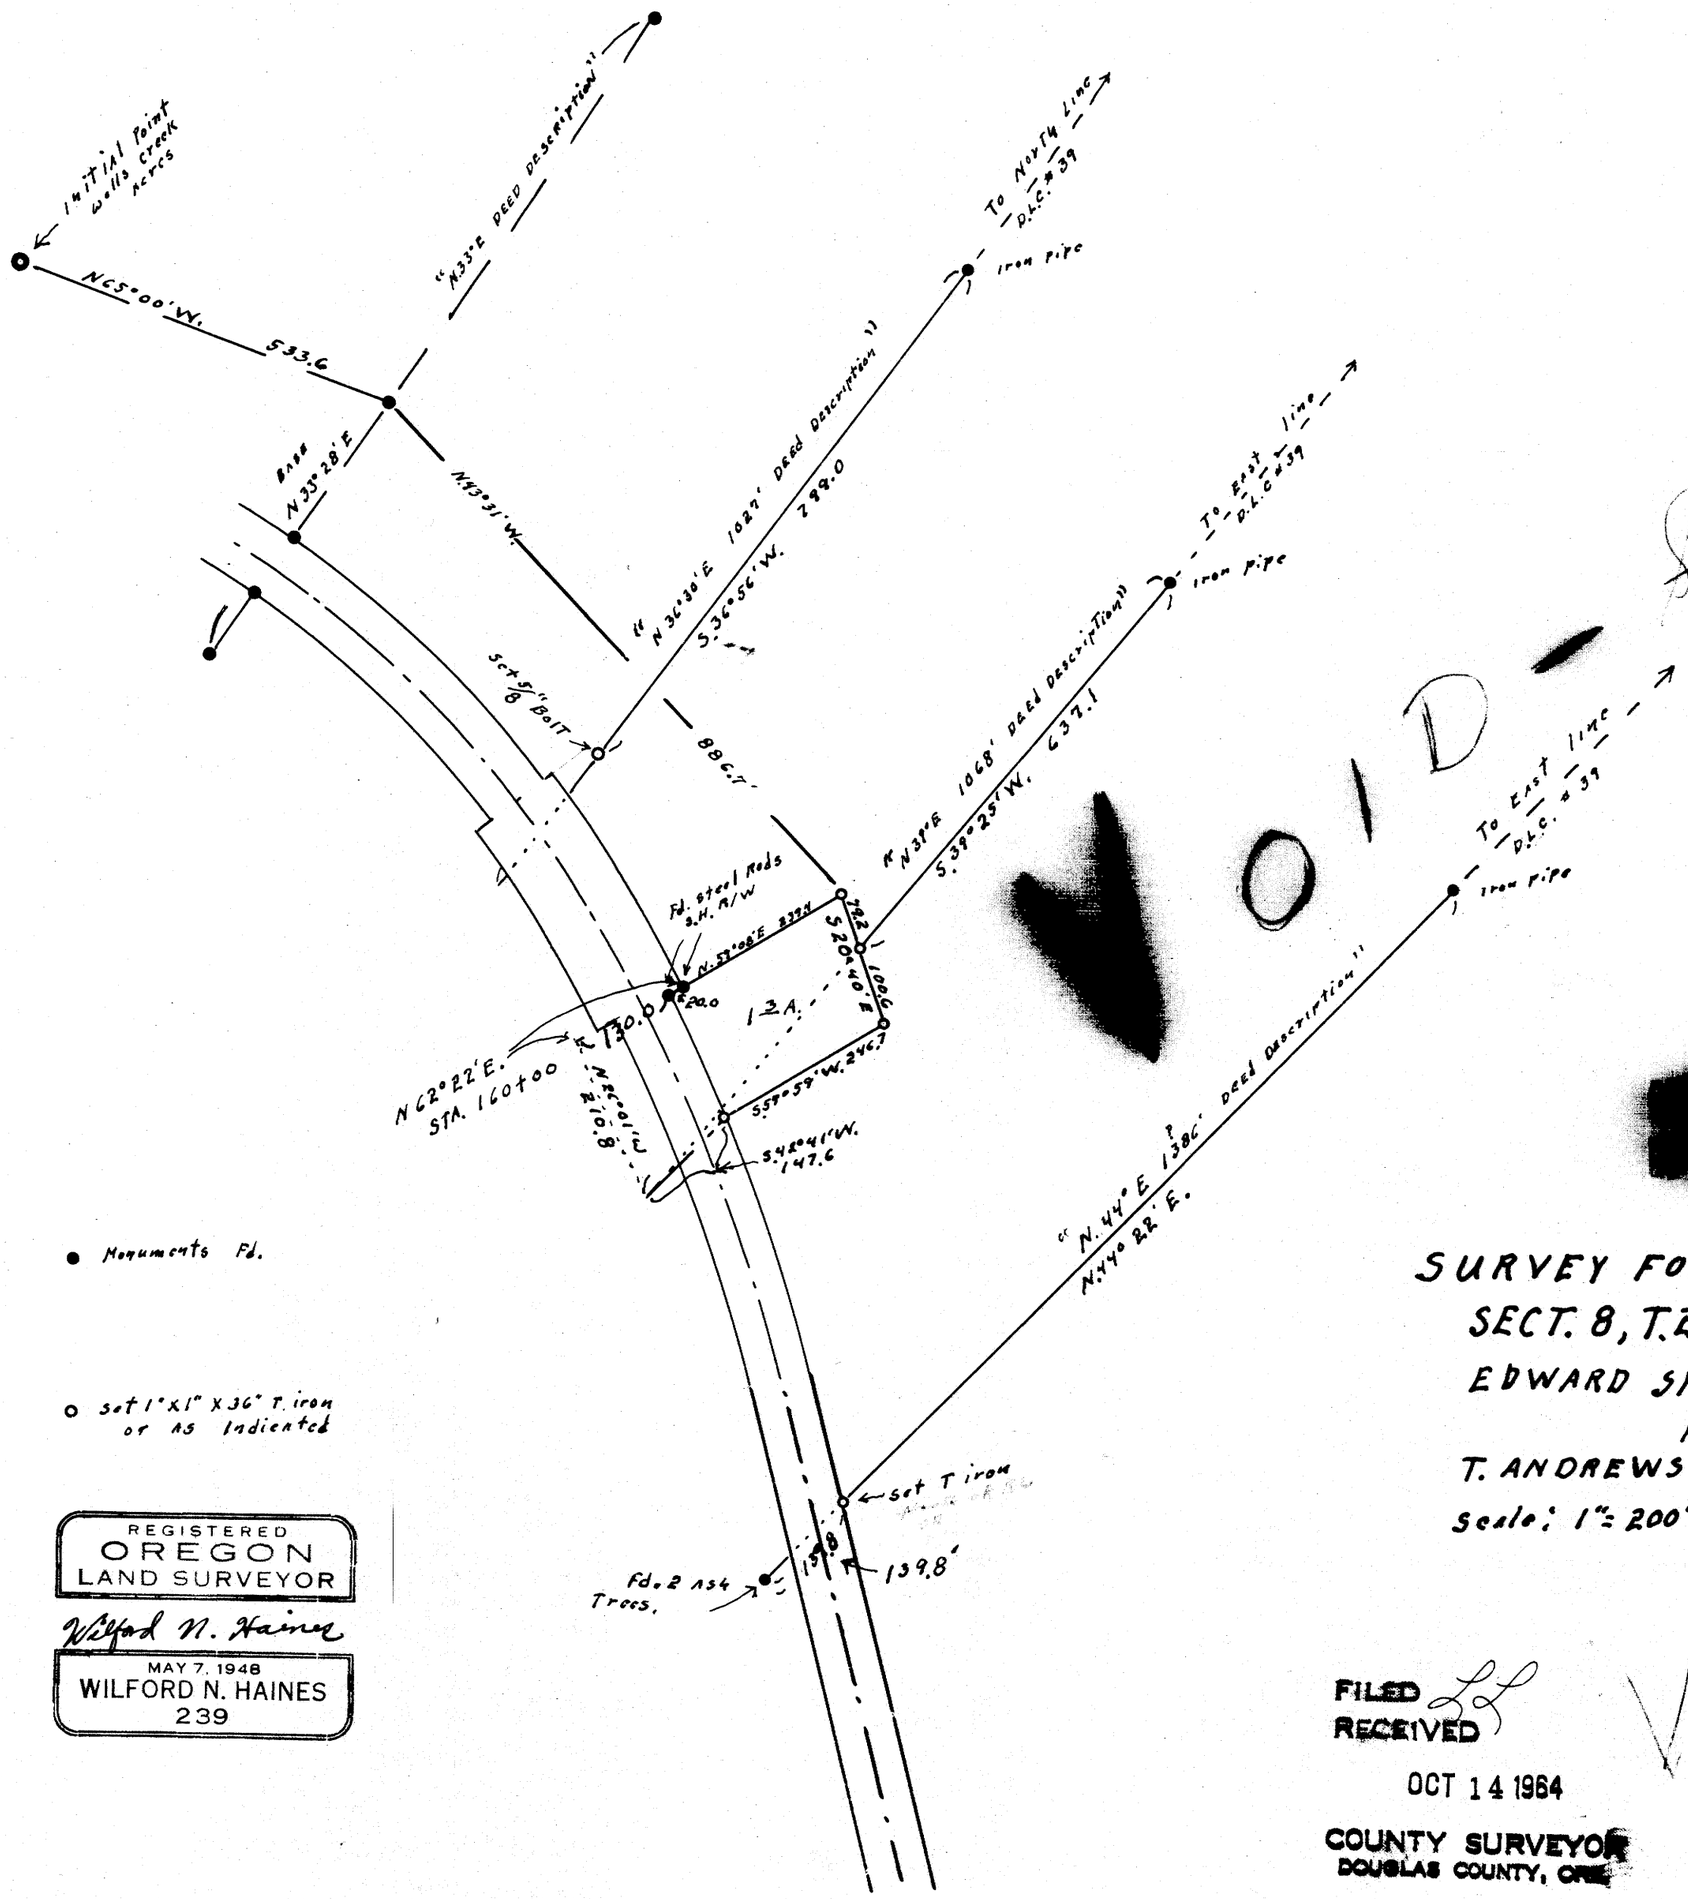

● Monuments Fd.

○ Set 1"x1"x36" T. iron or as Indicated

REGISTERED
OREGON
LAND SURVEYOR

Wilford N. Haines

MAY 7, 1948
WILFORD N. HAINES
239

VOID

[redacted]

SEE ~~M 29-70A~~ M28-70A

SURVEY FOR DEED DESCRIPTION
SECT. 8, T.22 S., R. 9 W. W.M.
EDWARD SPICER D.L.C. # 39
FOR
T. ANDREWS SCOTTSBURG
Scale: 1" = 200' Oct. 1964

M 28-70A 4/19/83

VOID - SEE ~~M 29-70A~~ M 28-70A DATED AUG. 1965

FILED
RECEIVED
OCT 14 1964
COUNTY SURVEYOR
DOUGLAS COUNTY, ORE.

MAP FILE M28 F 70

M28-70