M28 - 70A

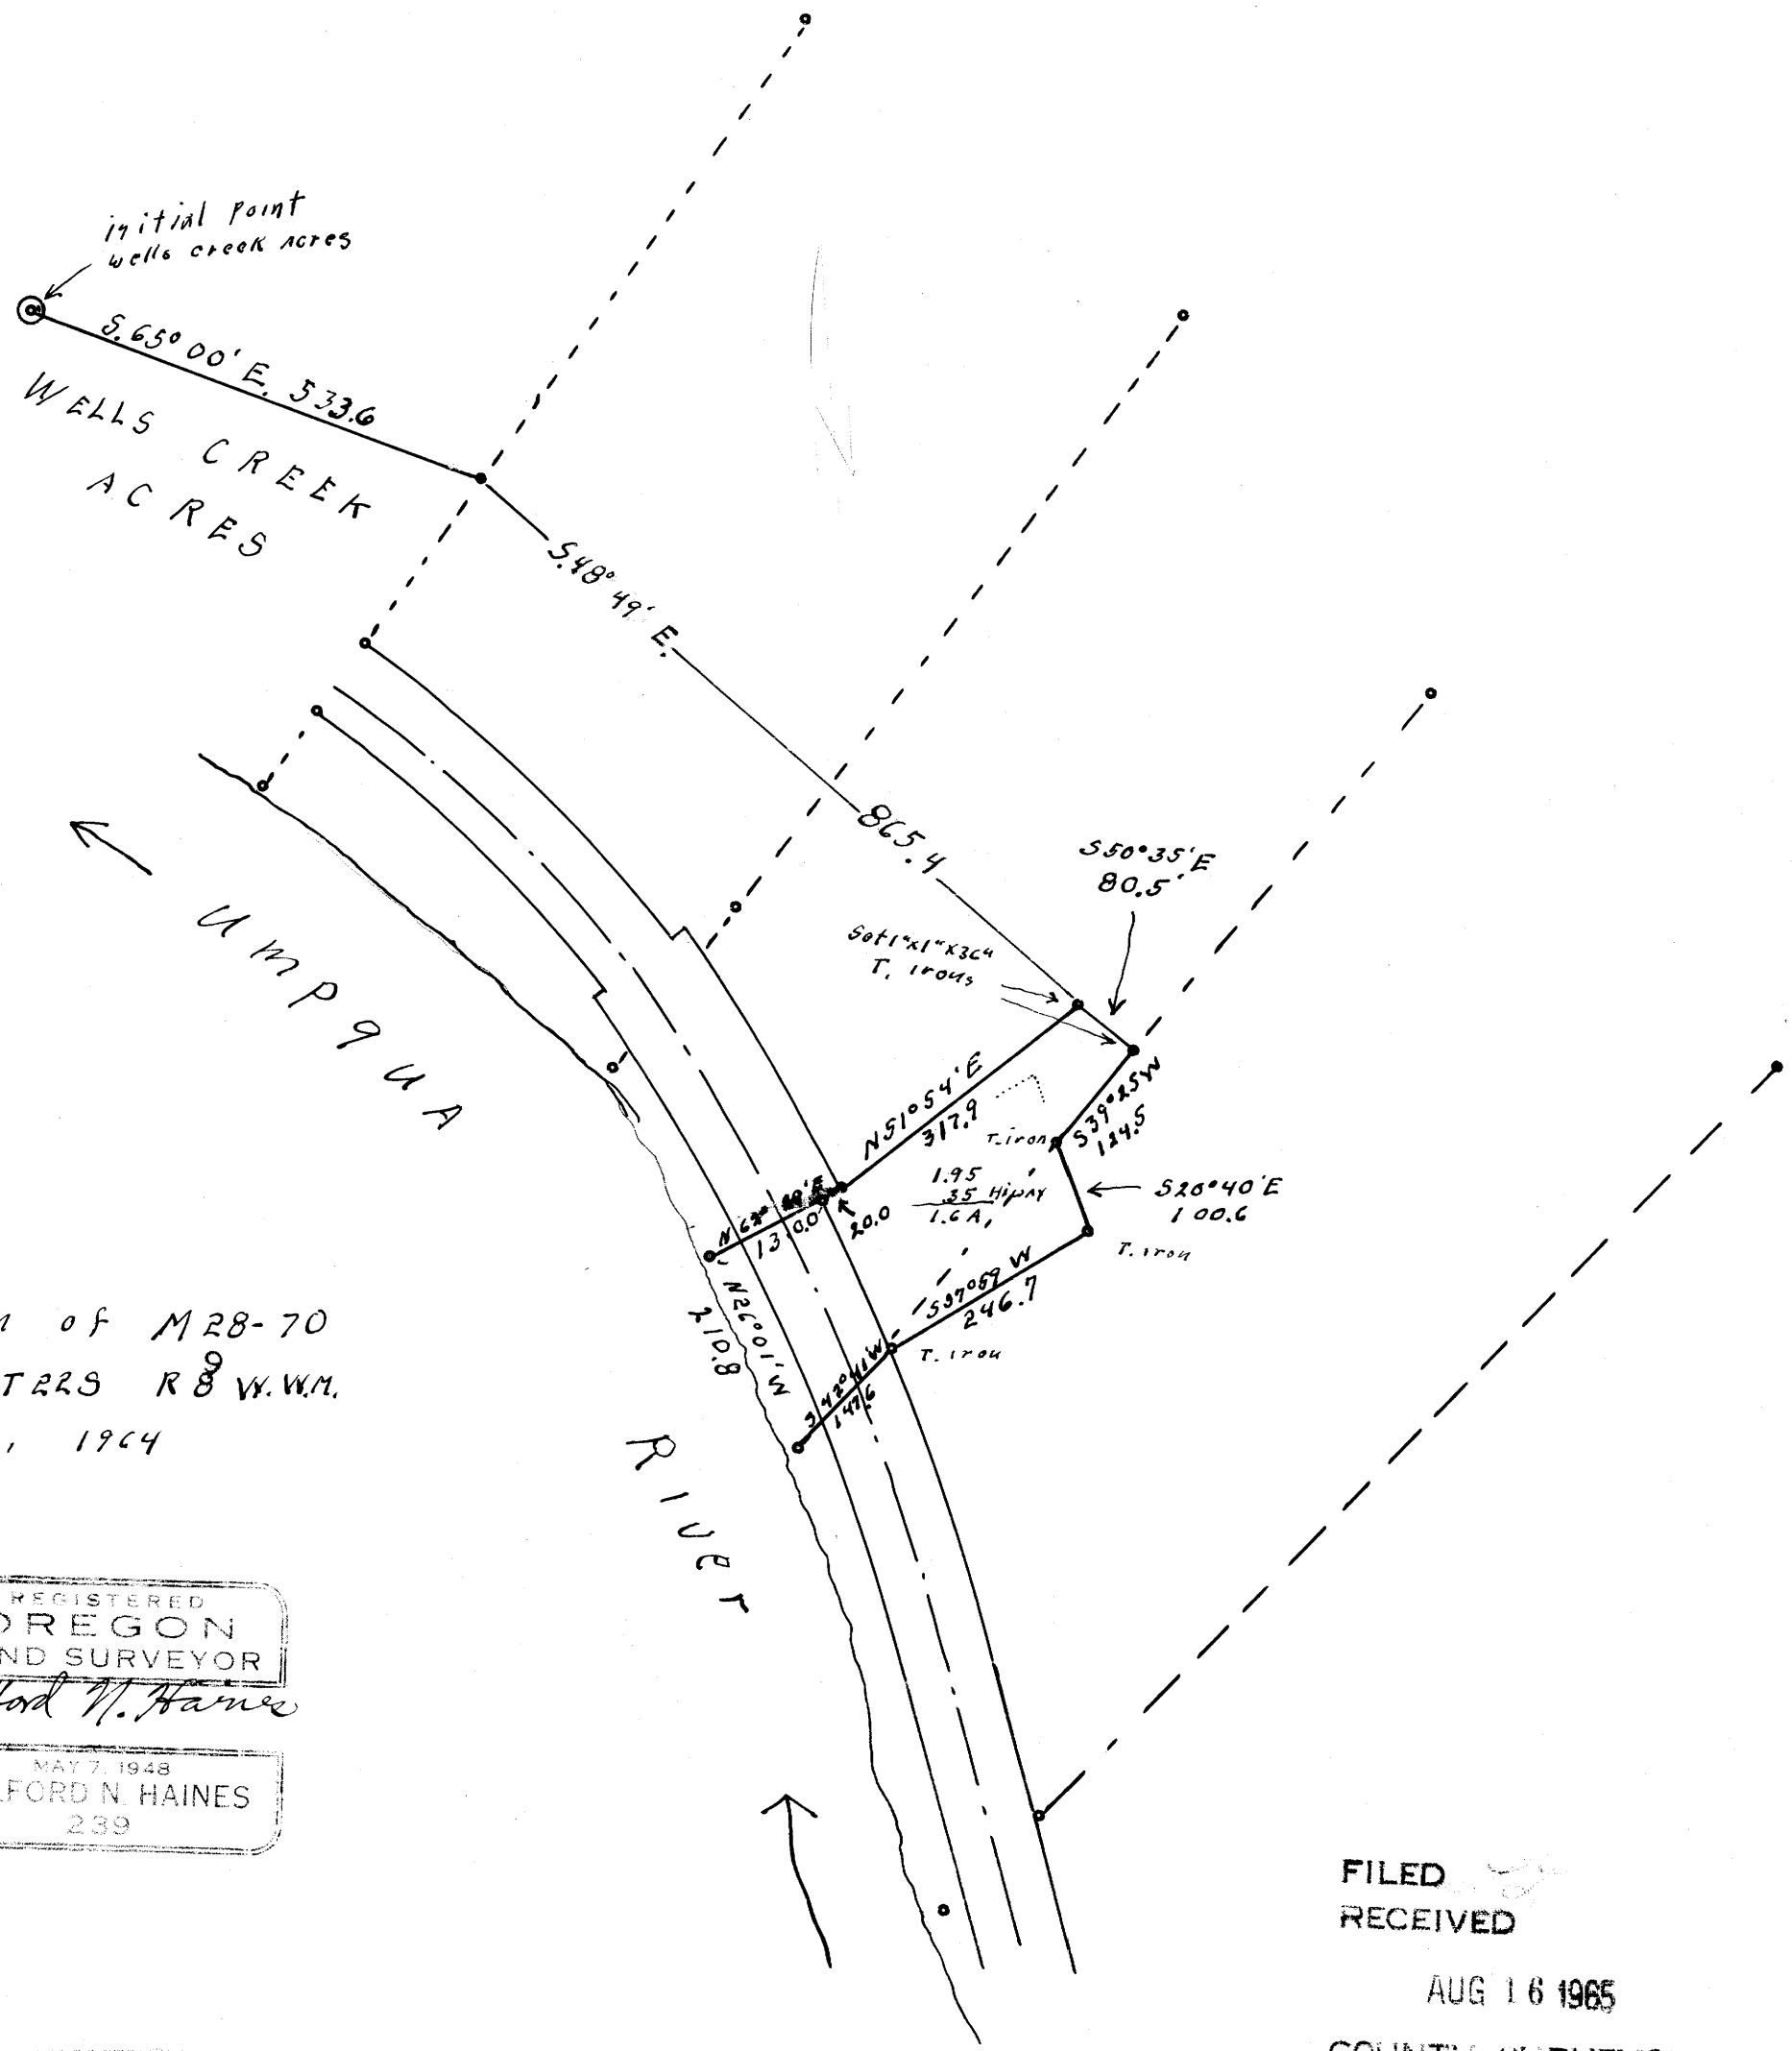

Replaces M28-70

REVISION of M28-70
SECT. 8 T22S R 8 W. W.M.
NOV 10, 1964

REGISTERED
OREGON
LAND SURVEYOR
Wilford N. Haines
MAY 7, 1948
WILFORD N. HAINES
239

FILED
RECEIVED
AUG 16 1965
COUNTY SURVEYOR
DOUGLAS COUNTY, ORE.

COUNTY SURVEYORS WILL
NOT REMOVE FROM OFFICE

M28 70A