M 28-74

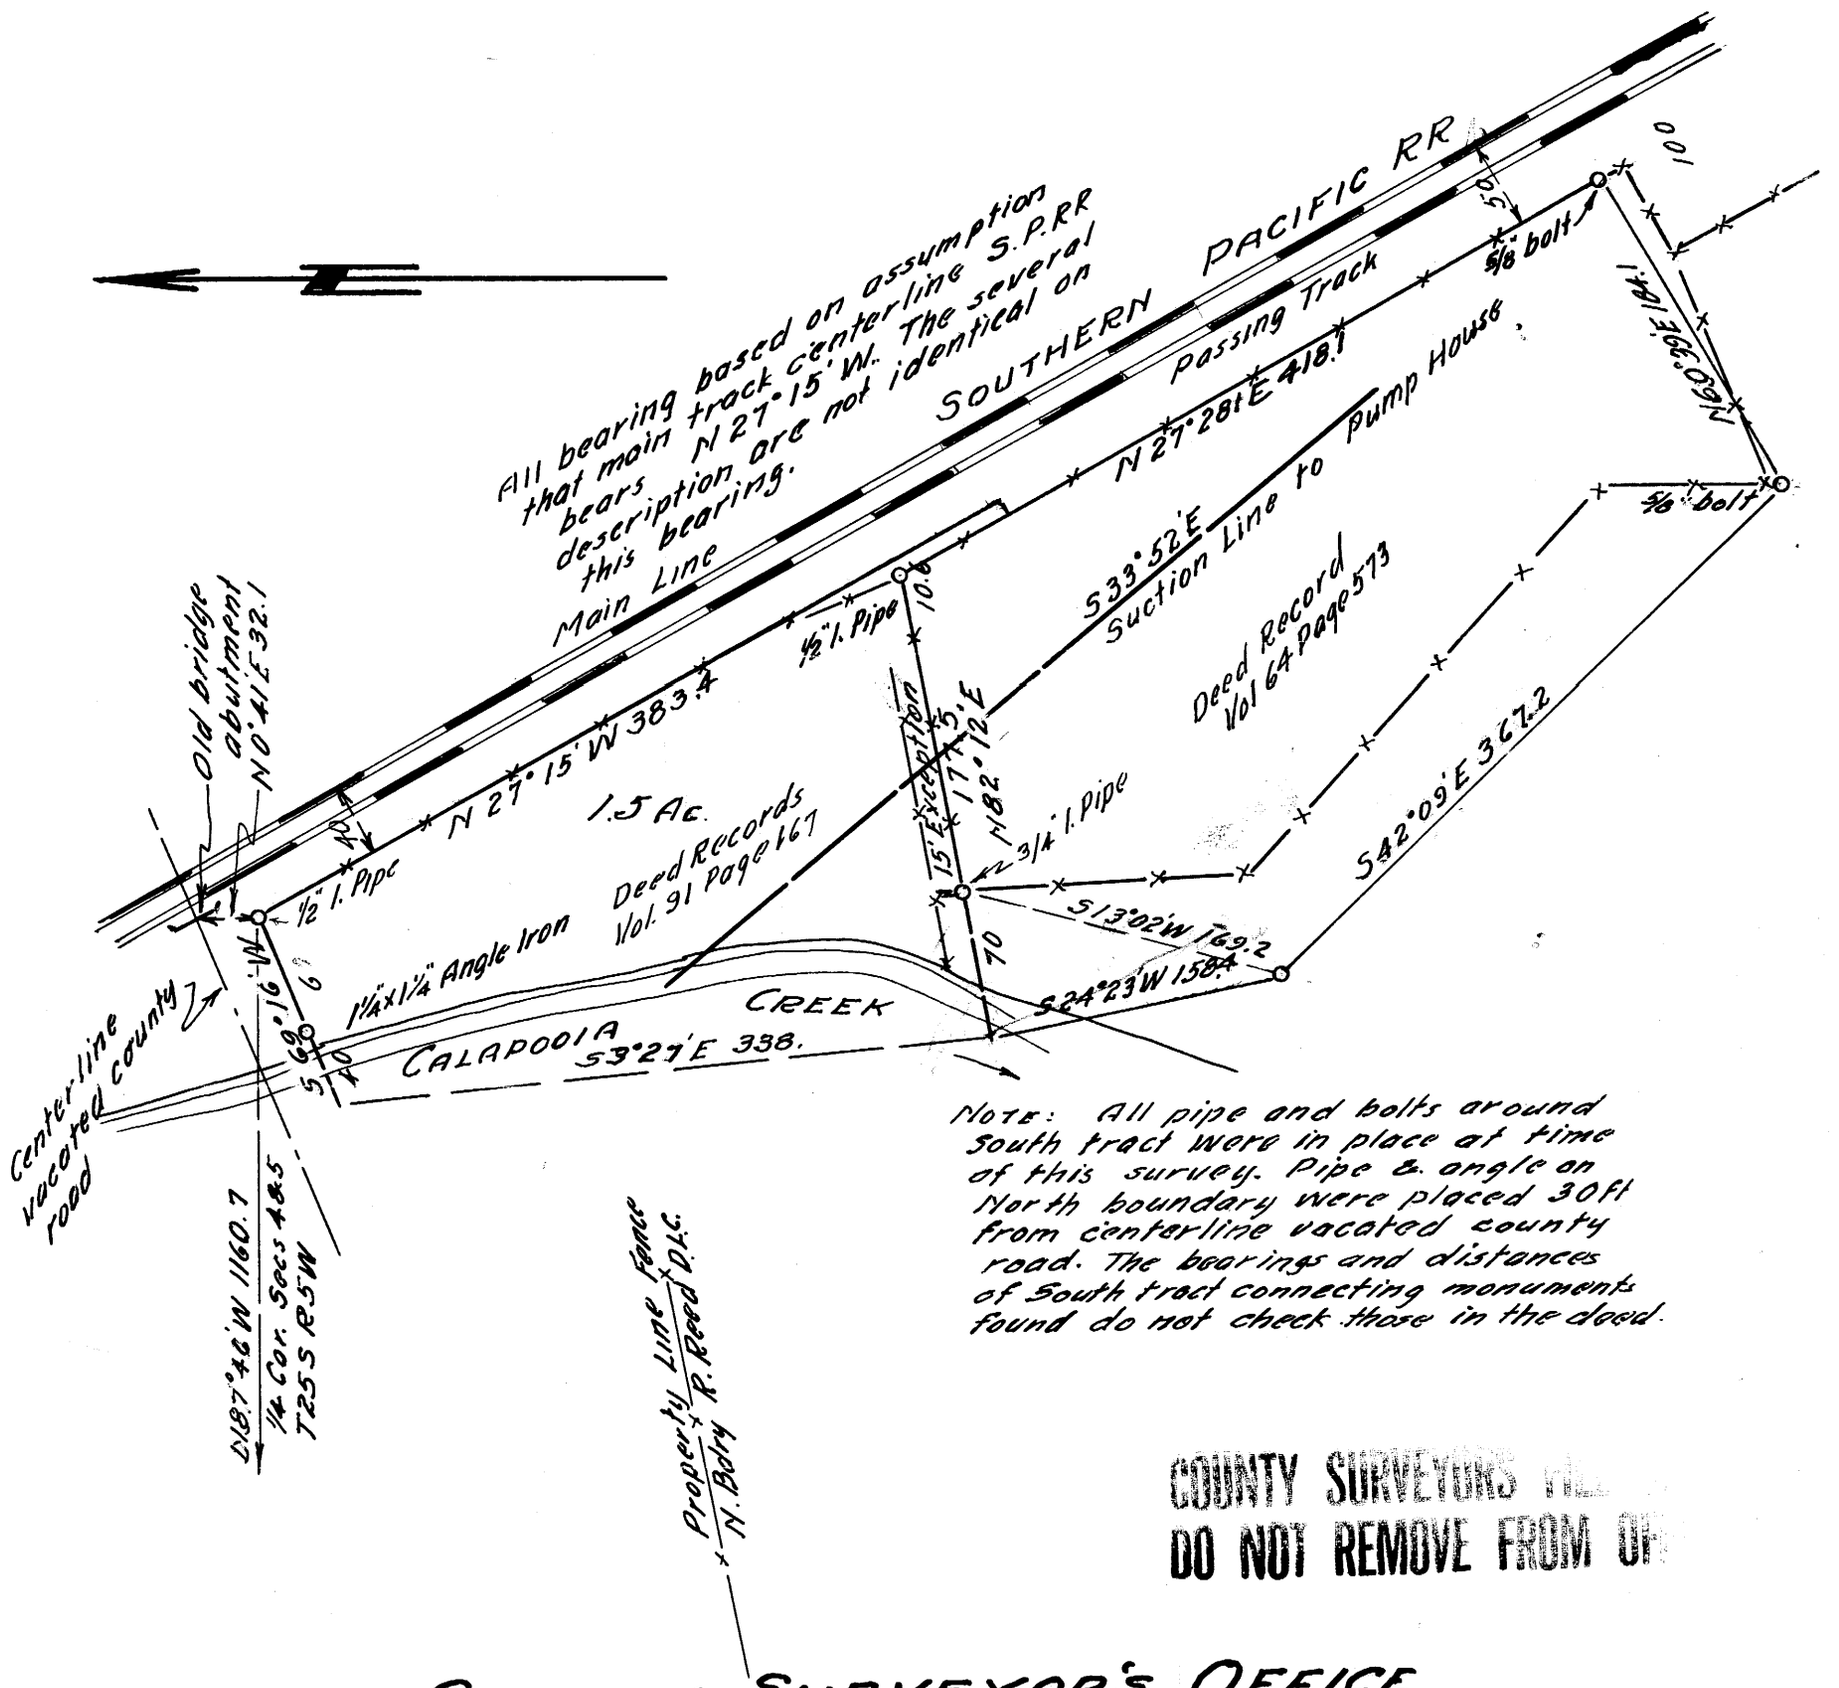

NOTE: All pipe and bolts around South tract were in place at time of this survey. Pipe & angle on North boundary were placed 30 ft from centerline vacated county road. The bearings and distances of South tract connecting monuments found do not check those in the deed.

COUNTY SURVEYORS FILE
DO NOT REMOVE FROM OFFICE

COUNTY SURVEYOR'S OFFICE
DOUGLAS COUNTY OREGON

KATE DEARDORFF TRACT below RAILROAD
SECTION 4. T.25S. R5W., W.M.

REGISTERED PROFESSIONAL ENGINEER 2140 OREGON NOV 8 1919 BEN B. IRVING

BEN. B. IRVING — COUNTY SURVEYOR
Surveyed Sept. 1946. — B.B.I

SCALE 1" = 100'

C.S. File 53/76

Map File M 28+74