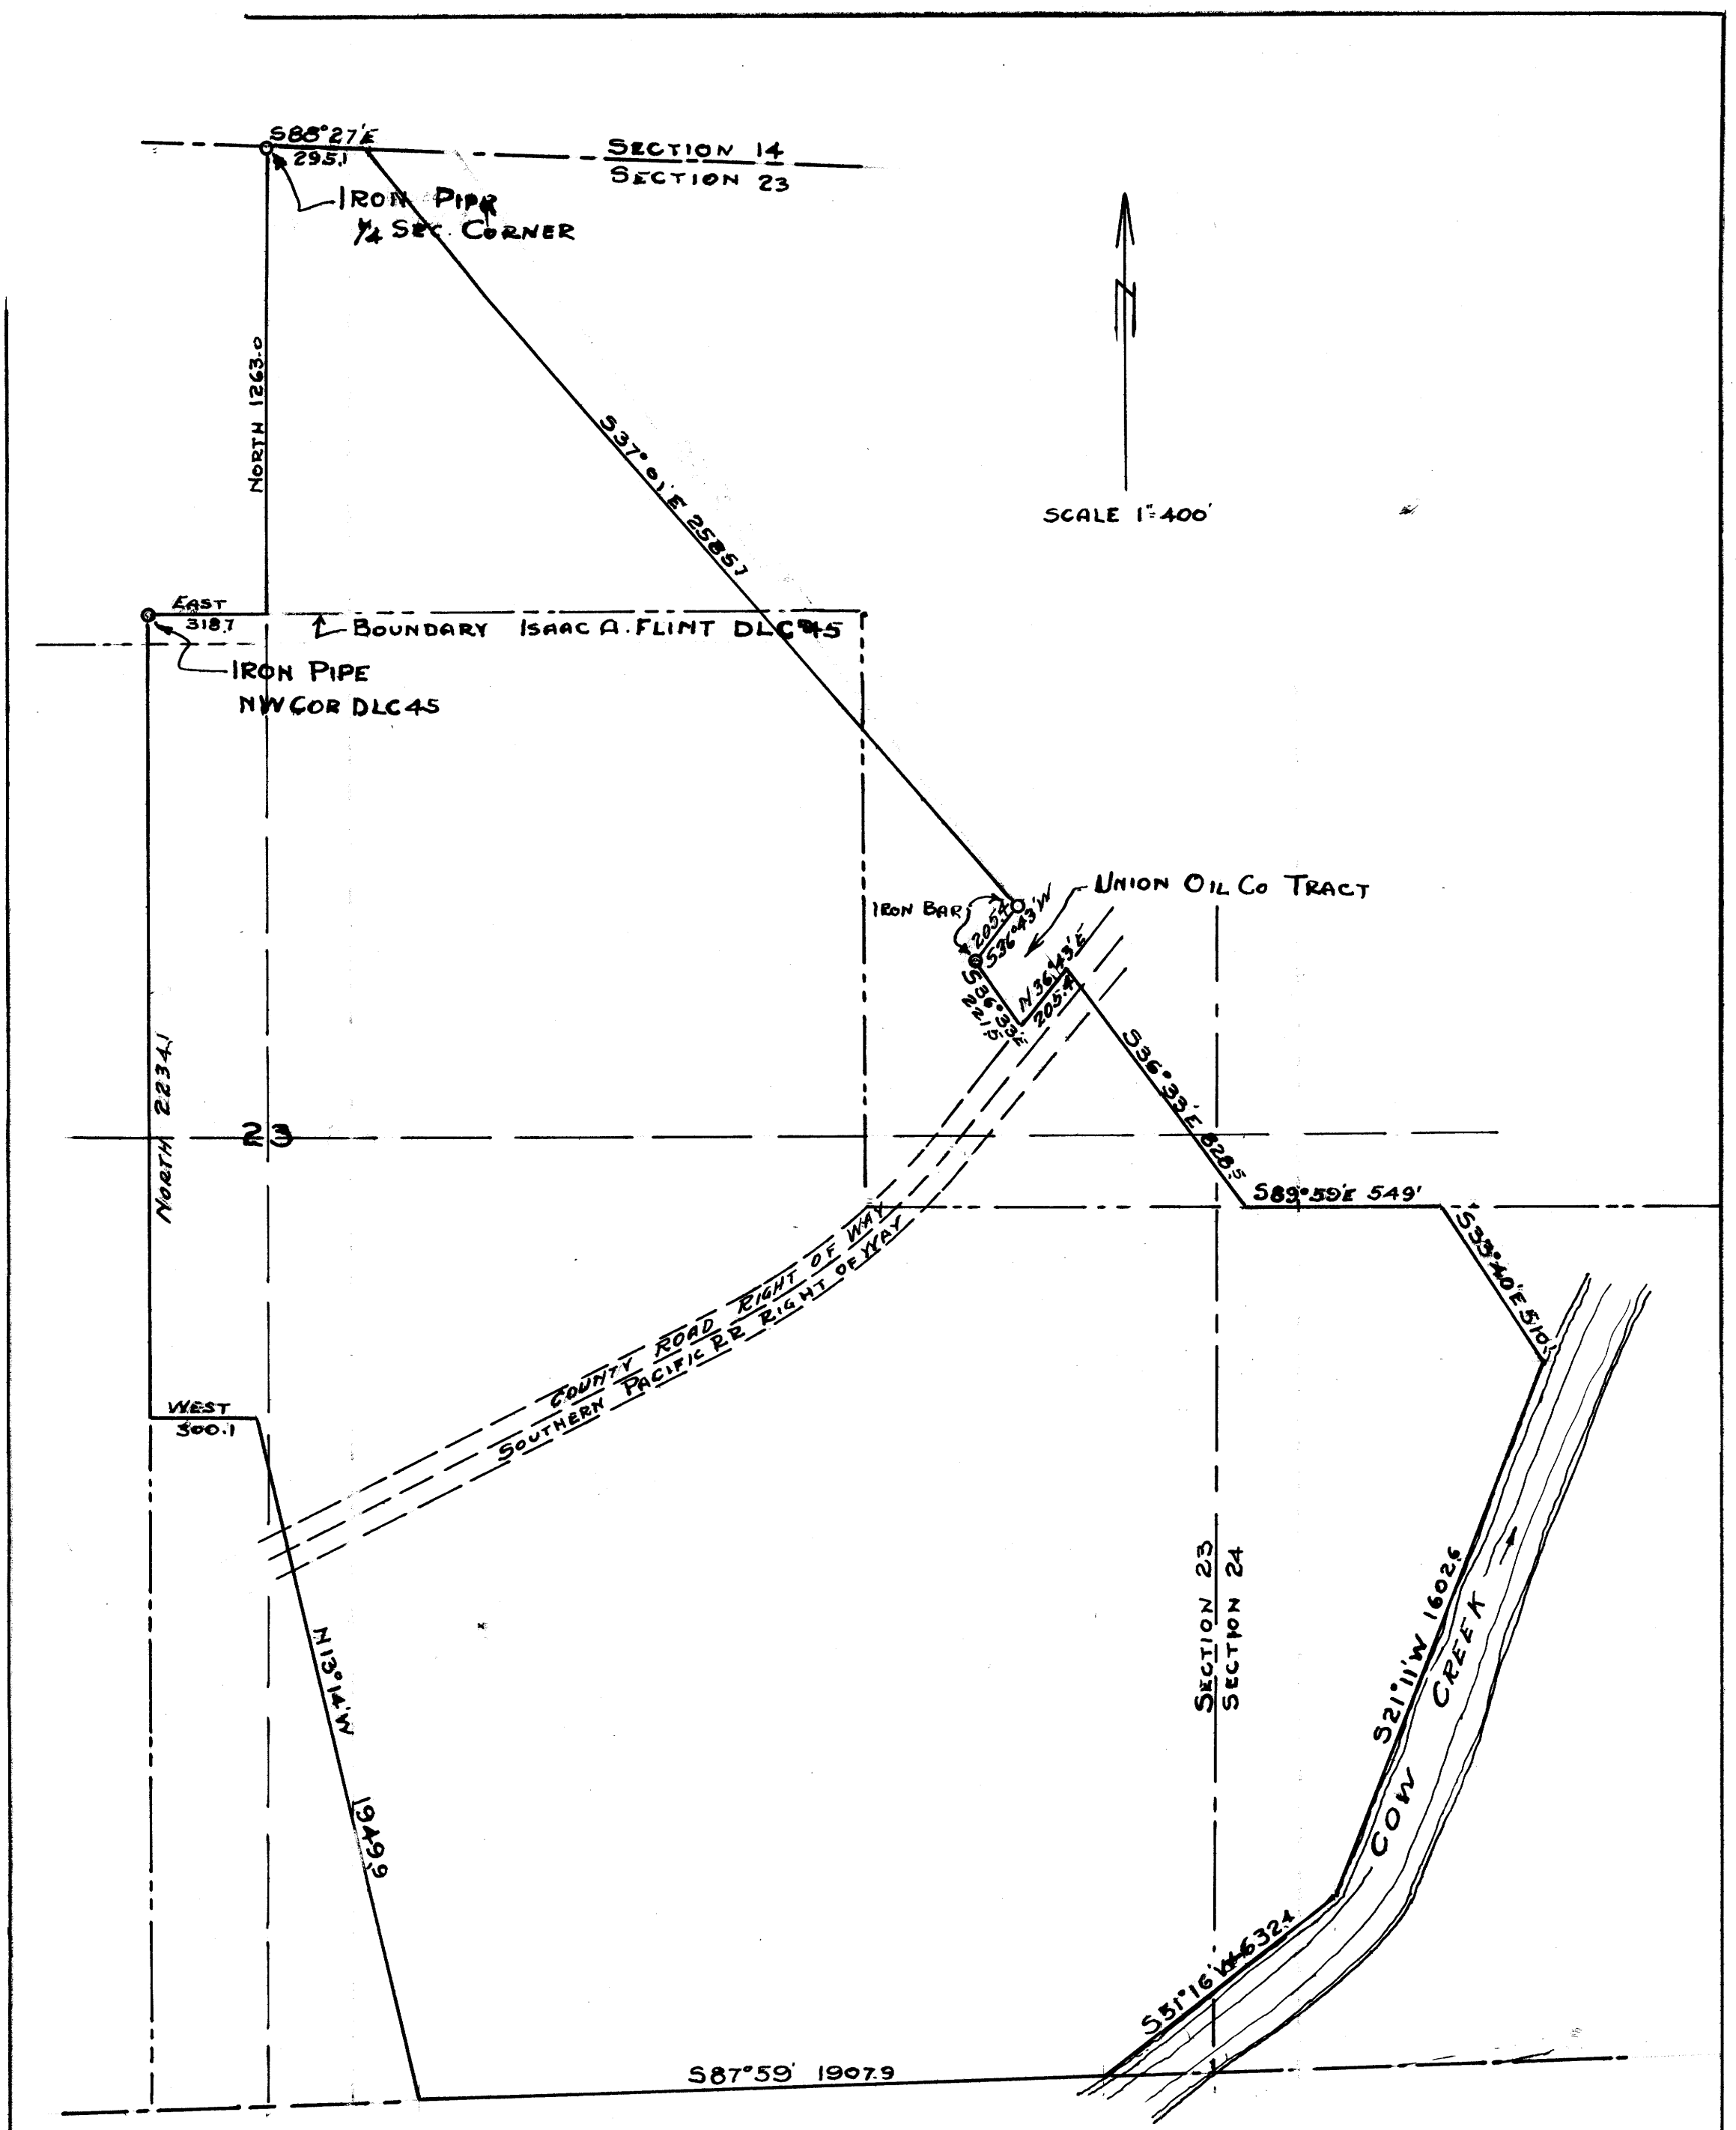


PART OF THE
FRED WALLENBERG RANCH
RIDDLE OREGON
M.&B. DESCRIPTION
SURVEYED BY
BEN. B. IRVING ROSEBURG ORE.

COUNTY SURVEYORS FILE
DO NOT REMOVE FROM OFFICE

File 53/98

MARCH 1939

M 28780