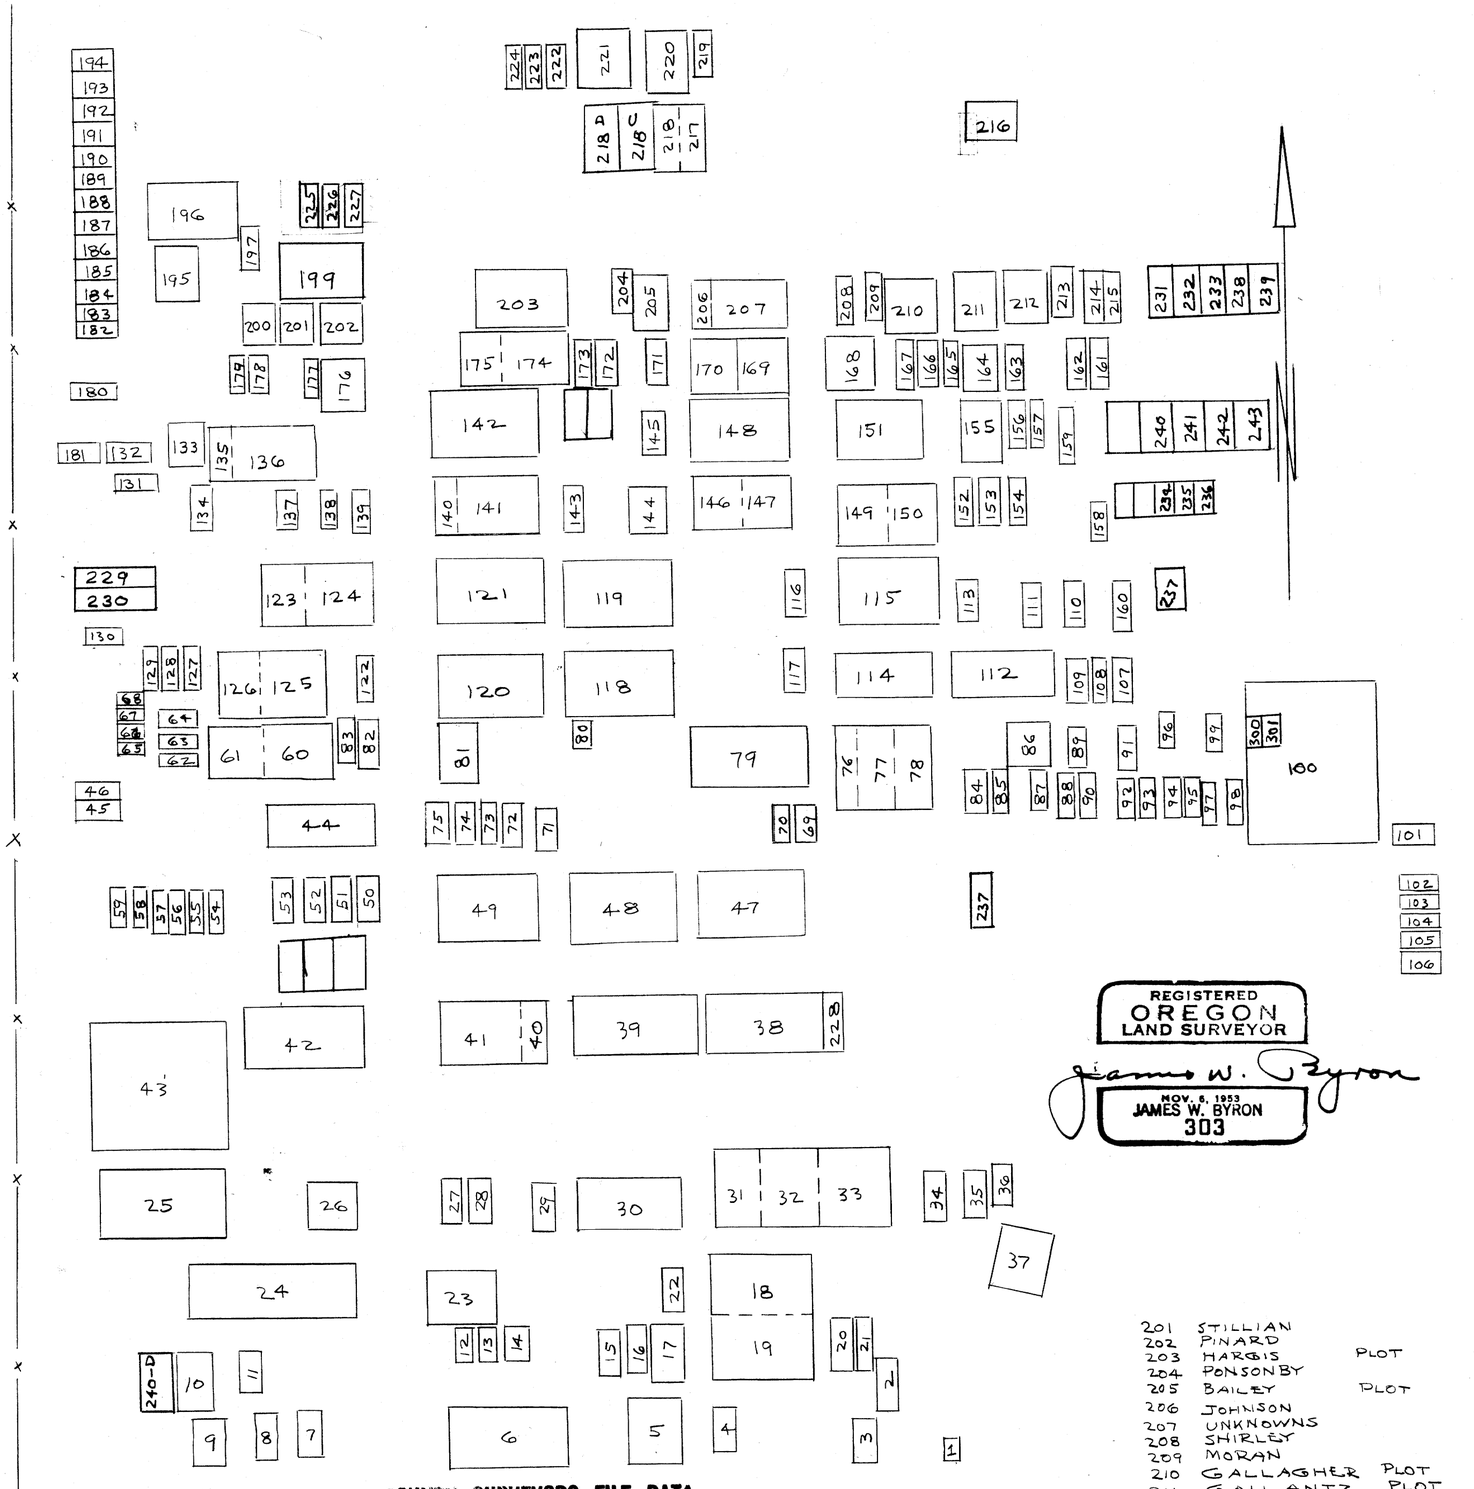

REGISTERED
OREGON
LAND SURVEYOR

James W. Byron

NOV. 6, 1953
JAMES W. BYRON
303

COUNTY SURVEYORS FILE DATA
DO NOT REMOVE FROM OFFICE

CATHOLIC CEMETERY

ROSEBURG, OREGON — MARCH 13, 1964

SCALE 1" = 20' — J.W. BYRON

NOTE — LOTS ADDED
SEPT. 5 1973
J.W.B.

FILED
RECEIVED
FEB 9 1965
COUNTY SURVEYOR
DOUGLAS COUNTY, ORE.

FILE M22-16

1	UNKNOWN	
2	— —	
3	HILD ---	
4	HUMPHREYS	
5	KRUM	PLOT
6	MC CARTHY	PLOT
7	UNKNOWN	
8	BLOBERGER	
9	O'SHEA	
10	CAHILL	
11	BUCKLEY	
12	DITTLE	
13	BOUCHARD	
14	UNKNOWN	
15	WILLETT, GEO.	
16	HAMMER, ELIZABATH	
17	WILLETT, RICHARD, LENA	
18	SCHREEMS	PLOT
19	GOSSER	PLOT
20	KERN	
21	UNKNOWN	
22	HOWARD	
23	UNKNOWN	
24	BALLF	PLOT
25	CASEY	PLOT
26	CHAMPAGNE	PLOT
27	KENNY	
28	UNKNOWN	
29	KOENIG	
30	MORIARTY	PLOT
31	KENNY	PLOT
32	BARRY	PLOT
33	SLOAN & KENNY	PLOT
34	MILLER, ELIZABATH	
35	MILLER, HENRY	
36	UNKNOWN	
37	LEMEREX	PLOT
38	DENN	PLOT
39	HENDRICKS	PLOT
40	KENNY	
41	BRYAN	PLOT
42	LANE	PLOT
43	SHERDIAN	PLOT
44	GRILLS	PLOT
45	UNKNOWN	
46	PARAZOO, JOHN	
47	DOLAN	PLOT
48	LANGENBERG	PLOT
49	— —	
50	FLOED, EMMA	VAULT
51	— — LAVINIA	—
52	JOHN	—
53	SARAH	
54	MOSHER, H.	
55	— — J.	
56	— — L.	
57	— — C.	
58	— — W.	
59	— — A.	
60	MONROE	PLOT
61	KELLEHER	
62	ASVADO, ELLEN	
63	PARAZZO, JAS.	
64	UNKNOWN	
65	PARAZZO, ARTHUR	
66	— — , DOYEL	
67	— — ANDREW	
68	— — HERMAN	
69	HOGLE	
70	DAVIS	
71	CHADWICK, AGNESS	
72	BOWEN, MARY	
73	UNKNOWN	
74	— —	
75	— —	
76	QUIGLEY	
77	LAFFERTY, SUSAN	
78	MC KINLEY	
79	PAUL	PLOT
80	SCHMIDT, MAXINE	
81	ANDRIE	PLOT
82	UNKNOWN	VAULT
83	TYNAN, ANN	
84	MUSGROVE, JULIA	
85	PAUL, RICHARD	
86	MC GOVERN	PLOT
87	UNKNOWN	
88	LIBERING, ELIZABETH	
89	— — HENRY	
90	— — MARGERT	
91	WINNIFORD, HAROLD	
92	PEDRO, AGUISO	
93	UNKNOWN	
94	— —	
95	GARCIA	
96	UNKNOWN	
97	— —	
98	WEISGERBER	
99	AMOE	
100	INFANT SECTION	
101	KELLEY, MARTIN	
102	COPPERS, JOHN	
103	UNKNOWN	
104	— —	
105	— —	
106	— —	
107	DONELAN	
108	HOFFMAN	
109	MC GOVERN	
110	DEMAIN	
111	SANBORN	
112	SNOTT	PLOT
113	HUCKINS	
114	KROGEL	PLOT
115	OSPALD	PLOT
116	BOYERS	
117	MC MANUS	
118	DAVANEY	PLOT
119	HEIDENREICH	PLOT
120	NEUNER	PLOT
121	SINNIGER	PLOT
122	UNKNOWN	
123	DUNSTHEIMER	PLOT
124	DEBERNARDI	PLOT
125	ZIMRICK	PLOT
126	NEWZELL	PLOT
127	PARAZOO	
128	— —	
129	UNKNOWN	
130	PARAZOO	
131	UNKNOWN	
132	WAKEFIELD	
133	COFFEY	
134	ROCKHILL	
135	DILLEY	
136	UTNE & FEST	PLOT
137	HALIC	
138	LEAHY	
139	COOPER	
140	POST	PLOT
141	DOYLE	PLOT
142	FRANCO	PLOT
143	HOLTER	
144	DIETSCH	
145	FURLUND	
146	RITZMAN	PLOT
147	ROACH	— —
148	HOLLAND	— —
149	BARNES	— —
150	DAVIS	— —
151	HILDEBORN	— —
152	TRIMBERGED, ELIZ.	
153	— — , ROMAN	
154	SPACKMAN	
155	SMITH	PLOT
156	EMAN	
157	BARNES	
158	PARSON, INFANT	
159	DUMONT	
160	GIBSON, GENEVIEVE	
161	PHILLIPS, FRANK	
162	BISHOP	
163	GARDNER, GEO.	
164	SONNY	
165	BENSON	
166	COMMON	
167	WANDLING	
168	DAVIS	PLOT
169	LAMMER	— —
170	LANGENBERG	— —
171	SOY	
172	CHARLEBOIS	
173	DONOGHUE	
174	ANDERSON	PLOT
175	DUCHENE	— —
176	LONGTON	— —
177	SIMSHAUSER	
178	GRAIN	
179	HELTON	
180	SHOPP	
181	KEFIELD	
182	UNKNOWN	
183	— —	
184	— —	
185	HOGAN	
186	UNKNOWN	
187	— —	
188	GRADY	
189	RICHARDS	
190	STOCKL	
191	GREENWOOD	
192	PREZYDZIAL	
193	STOCKL	
194	UNKNOWN	
195	GRENSKY	PLOT
196	RIETMANN	— —
197	SMITH	
198	LIENING	PLOT
199	HOLFORD	
200	ROBERTS	
201	STILLIAN	
202	PINARD	
203	HARGIS	PLOT
204	PONSONBY	
205	BAILEY	PLOT
206	JOHNSON	
207	UNKNOWNS	
208	SHIRLEY	
209	MORAN	
210	GALLAGHER	PLOT
211	GALLANTZ	PLOT
212	KIMBALL	
213	WELCH	
214	THEISS	
215	CORNELIUS	
216	LOONEY	
217	KILLIAN, REV.	
218	CLERY, REV.	
219	WRUCK, GENE	PLOT
220	LANSDA	
221	BRUNETT	
222	PRINCEN, E.	
223	PRINCEN, M.	
224	PRINCEN, B.	
225	HANLEY	
226	LOONEY	
227	GIBSON	
228	LENA DENN	