FILE M 29 + 18

REGISTERED
OREGON
LAND SURVEYOR
Wilford N. Haines
MAY 7, 1948
WILFORD N. HAINES
239

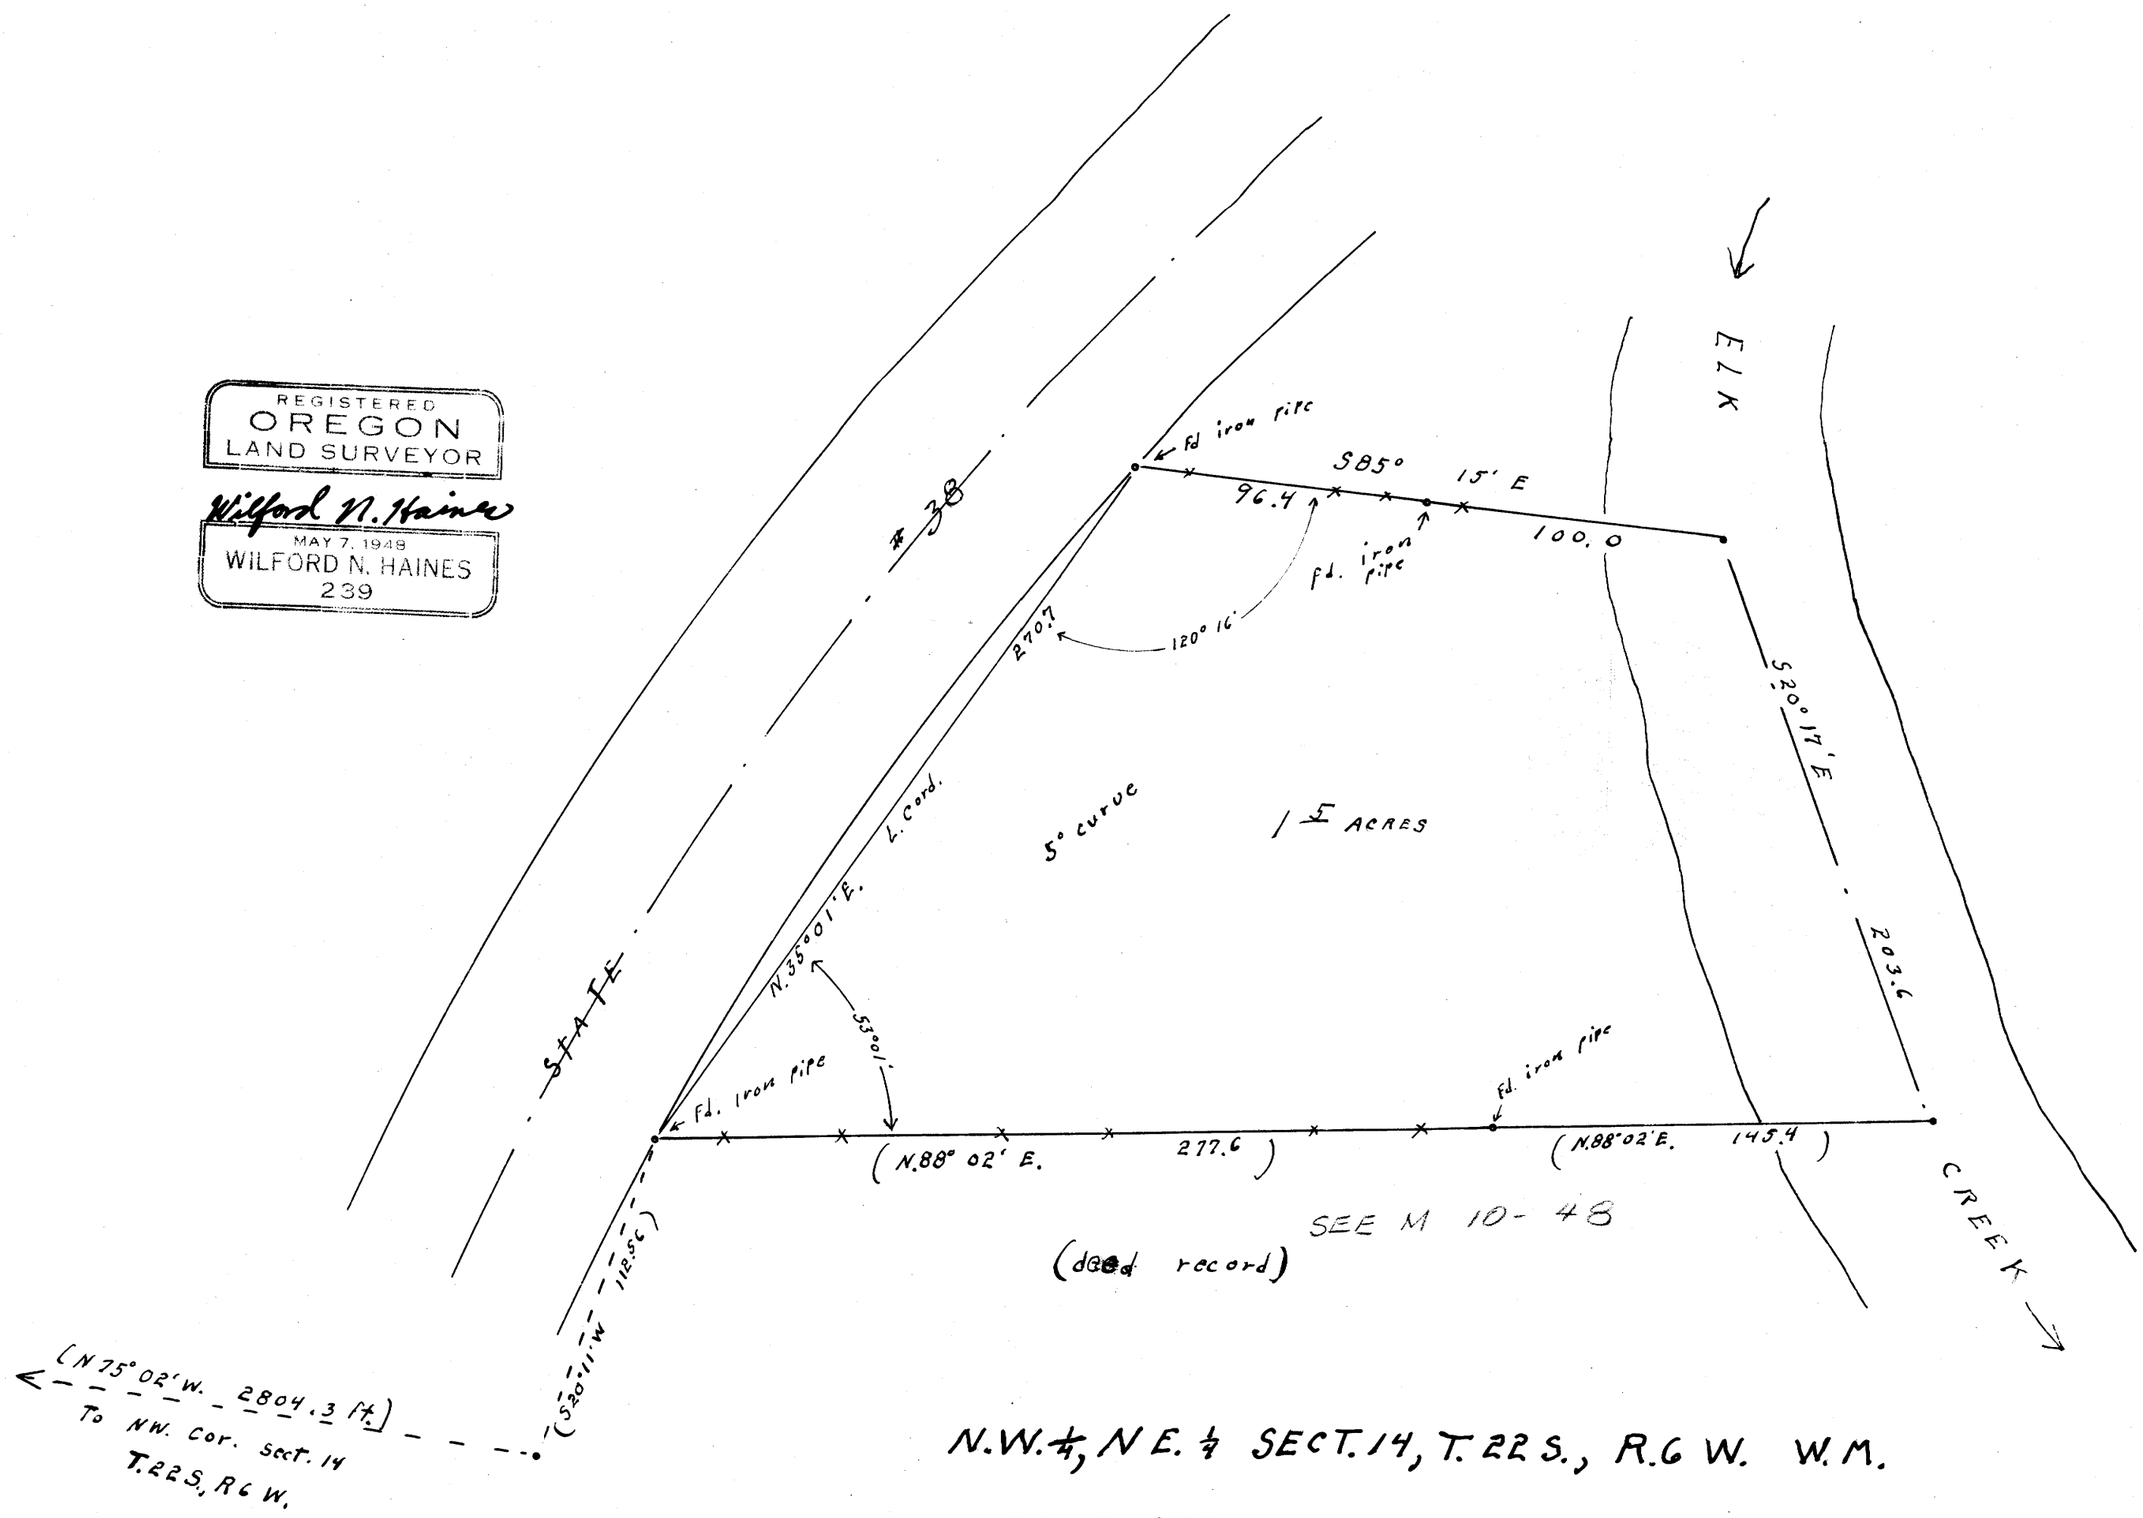

N.W.¼, N.E.¼ SECT. 14, T. 22 S., R. 6 W. W.M.

Scale: 1" = 50'

DEC. 1964

COUNTY SURVEYORS FILE DATA
DO NOT REMOVE FROM OFFICE

FILED
RECEIVED
FEB 15 1965
COUNTY SURVEYOR
DOUGLAS COUNTY, ORE.

2

M 29 + 18