COUNTY SURVEYORS FILE DATA
DO NOT REMOVE FROM OFFICE

SURVEY TO ESTABLISH PROPERTY CORNERS IN SEC. 1, T26S, R3W. W. M.

SURVEYED FOR – ED NOLTE
SURVEYED BY – W. S. BARNES

FEB. 1965
SCALE 1" = 50'

NOTE: BEARING BASE TAKEN FROM N-S CENTERLINE SEC. 1, S 0°28'W, SEE C.S. FILE 13/28.

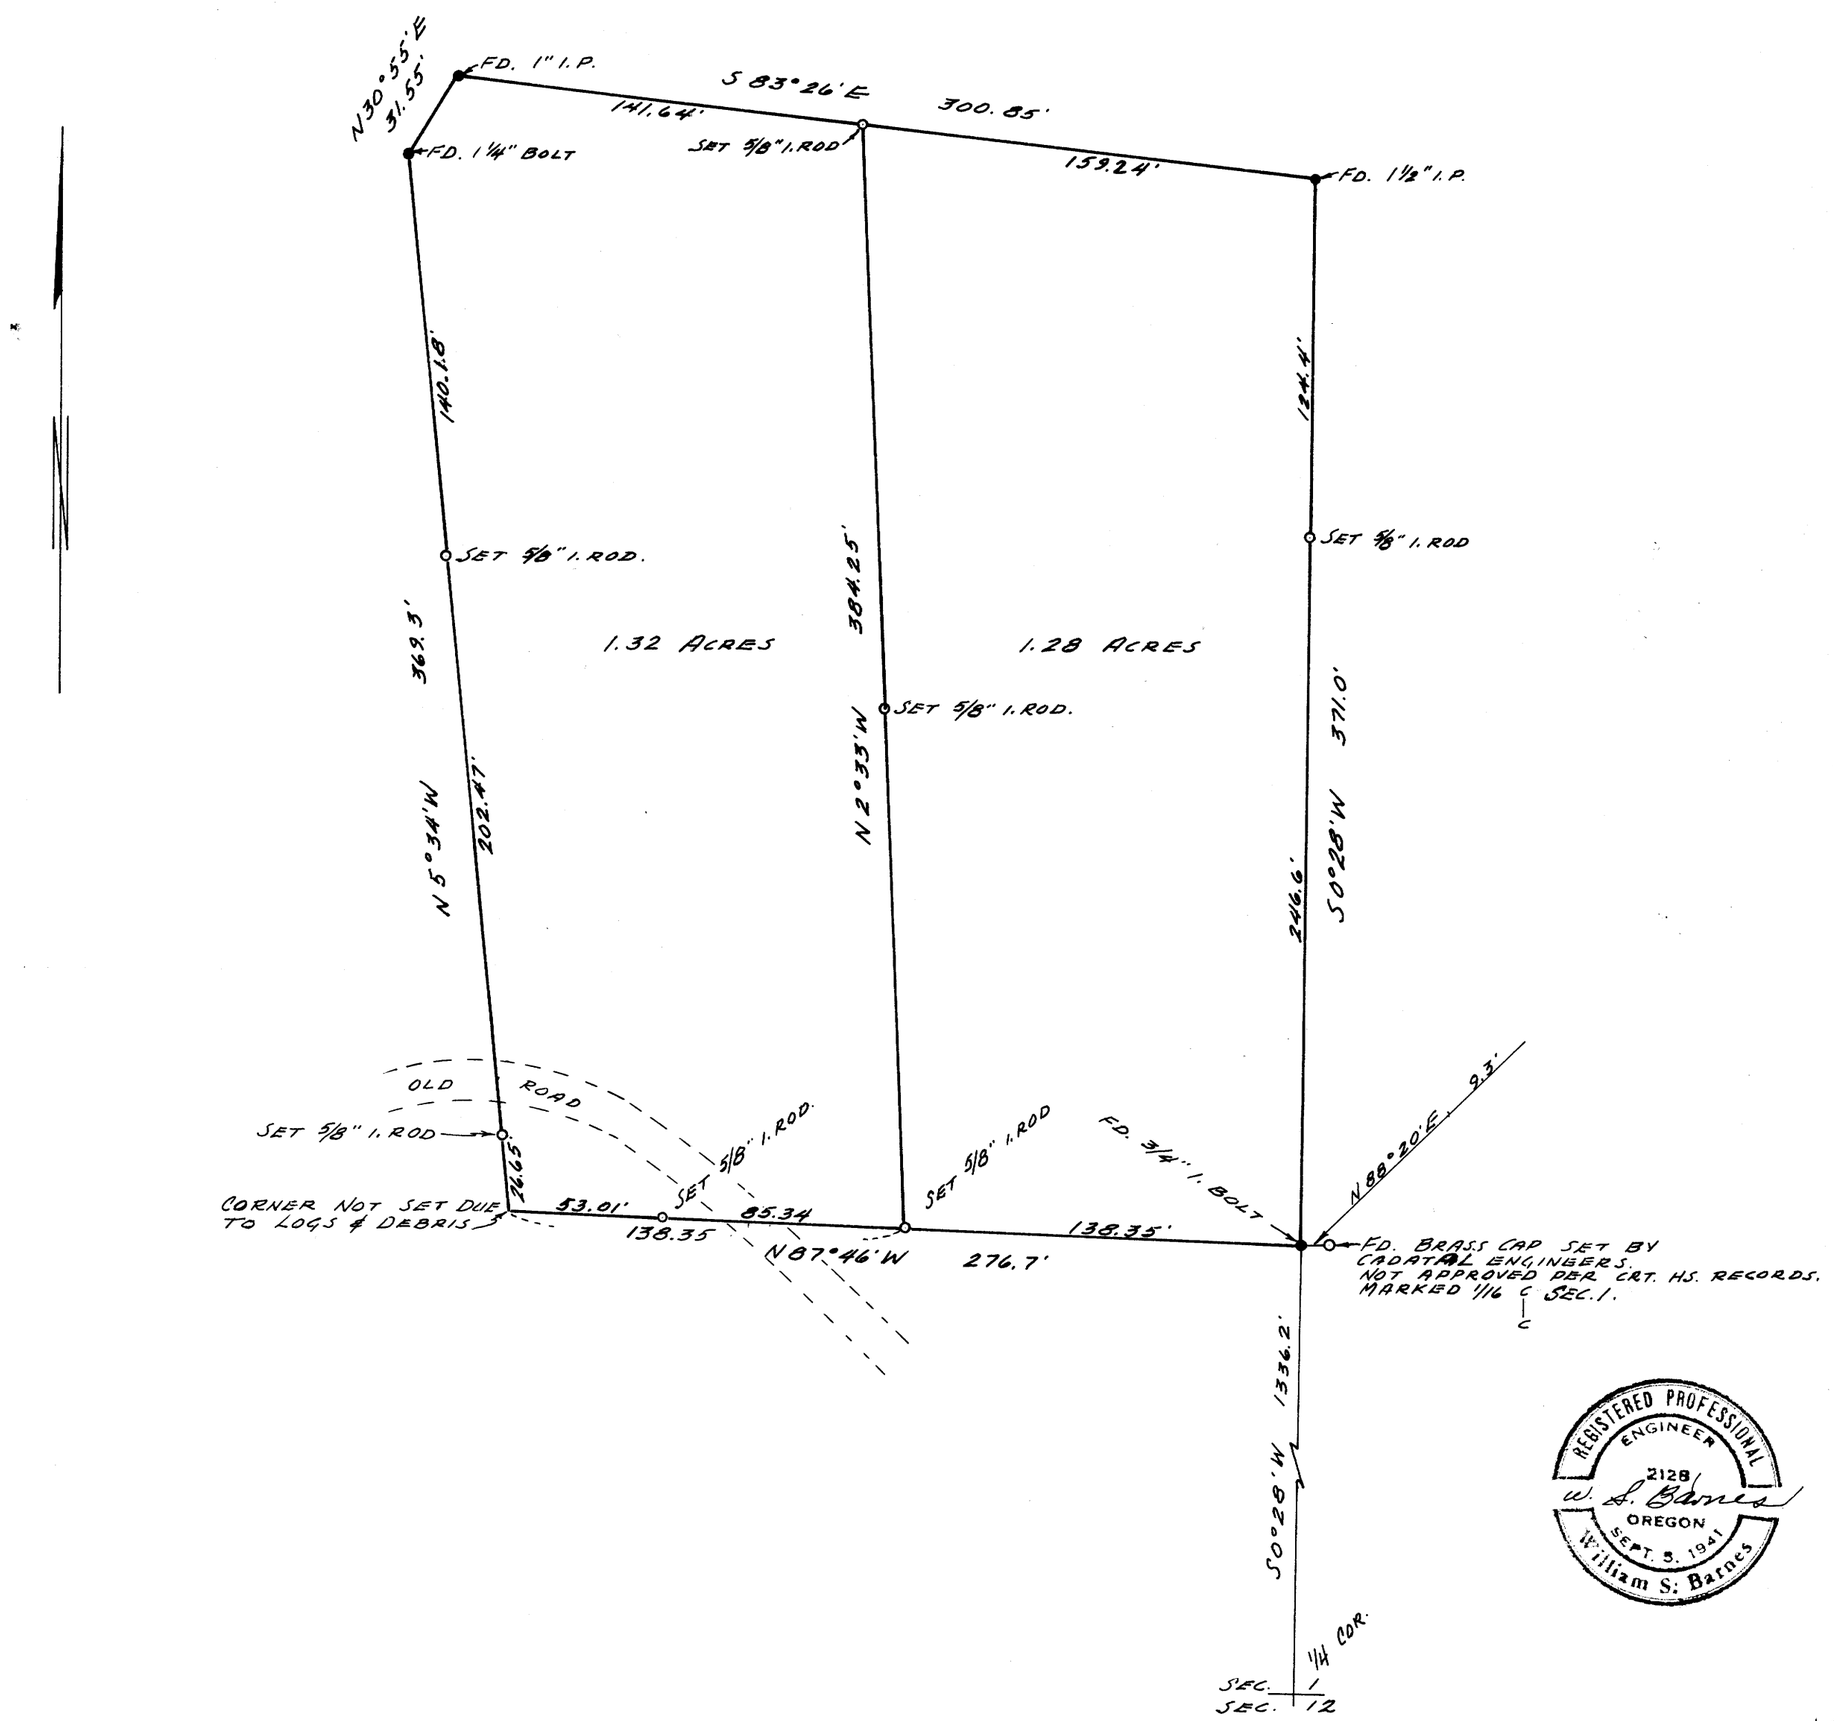

REGISTERED PROFESSIONAL ENGINEER
2128
W. S. Barnes
OREGON
SEPT. 5, 1941
William S. Barnes

FILED
RECEIVED
FEB 23 1965
COUNTY SURVEYOR
DOUGLAS COUNTY, ORE.

FILE M.22 F.22