SURVEYORS FILE DATE
DO NOT REMOVE FROM OFFICE

LOT 97 MELROSE ORCHARDS
SEC. 35 T.26S. R.7W. W.M.

SURVEYED FOR JIM EASTERLY, MARCH 12, 1965
SURVEYED BY DON E. GARRETT
BEARINGS BASED ON SOLAR OBSERVATION FEB. 27, 1965
SCALE 1"=100' •— DENOTES SET 5/8" IRON ROD

FILED
RECEIVED
APR 7 1965
COUNTY SURVEYOR
DOUGLAS COUNTY, ORE.

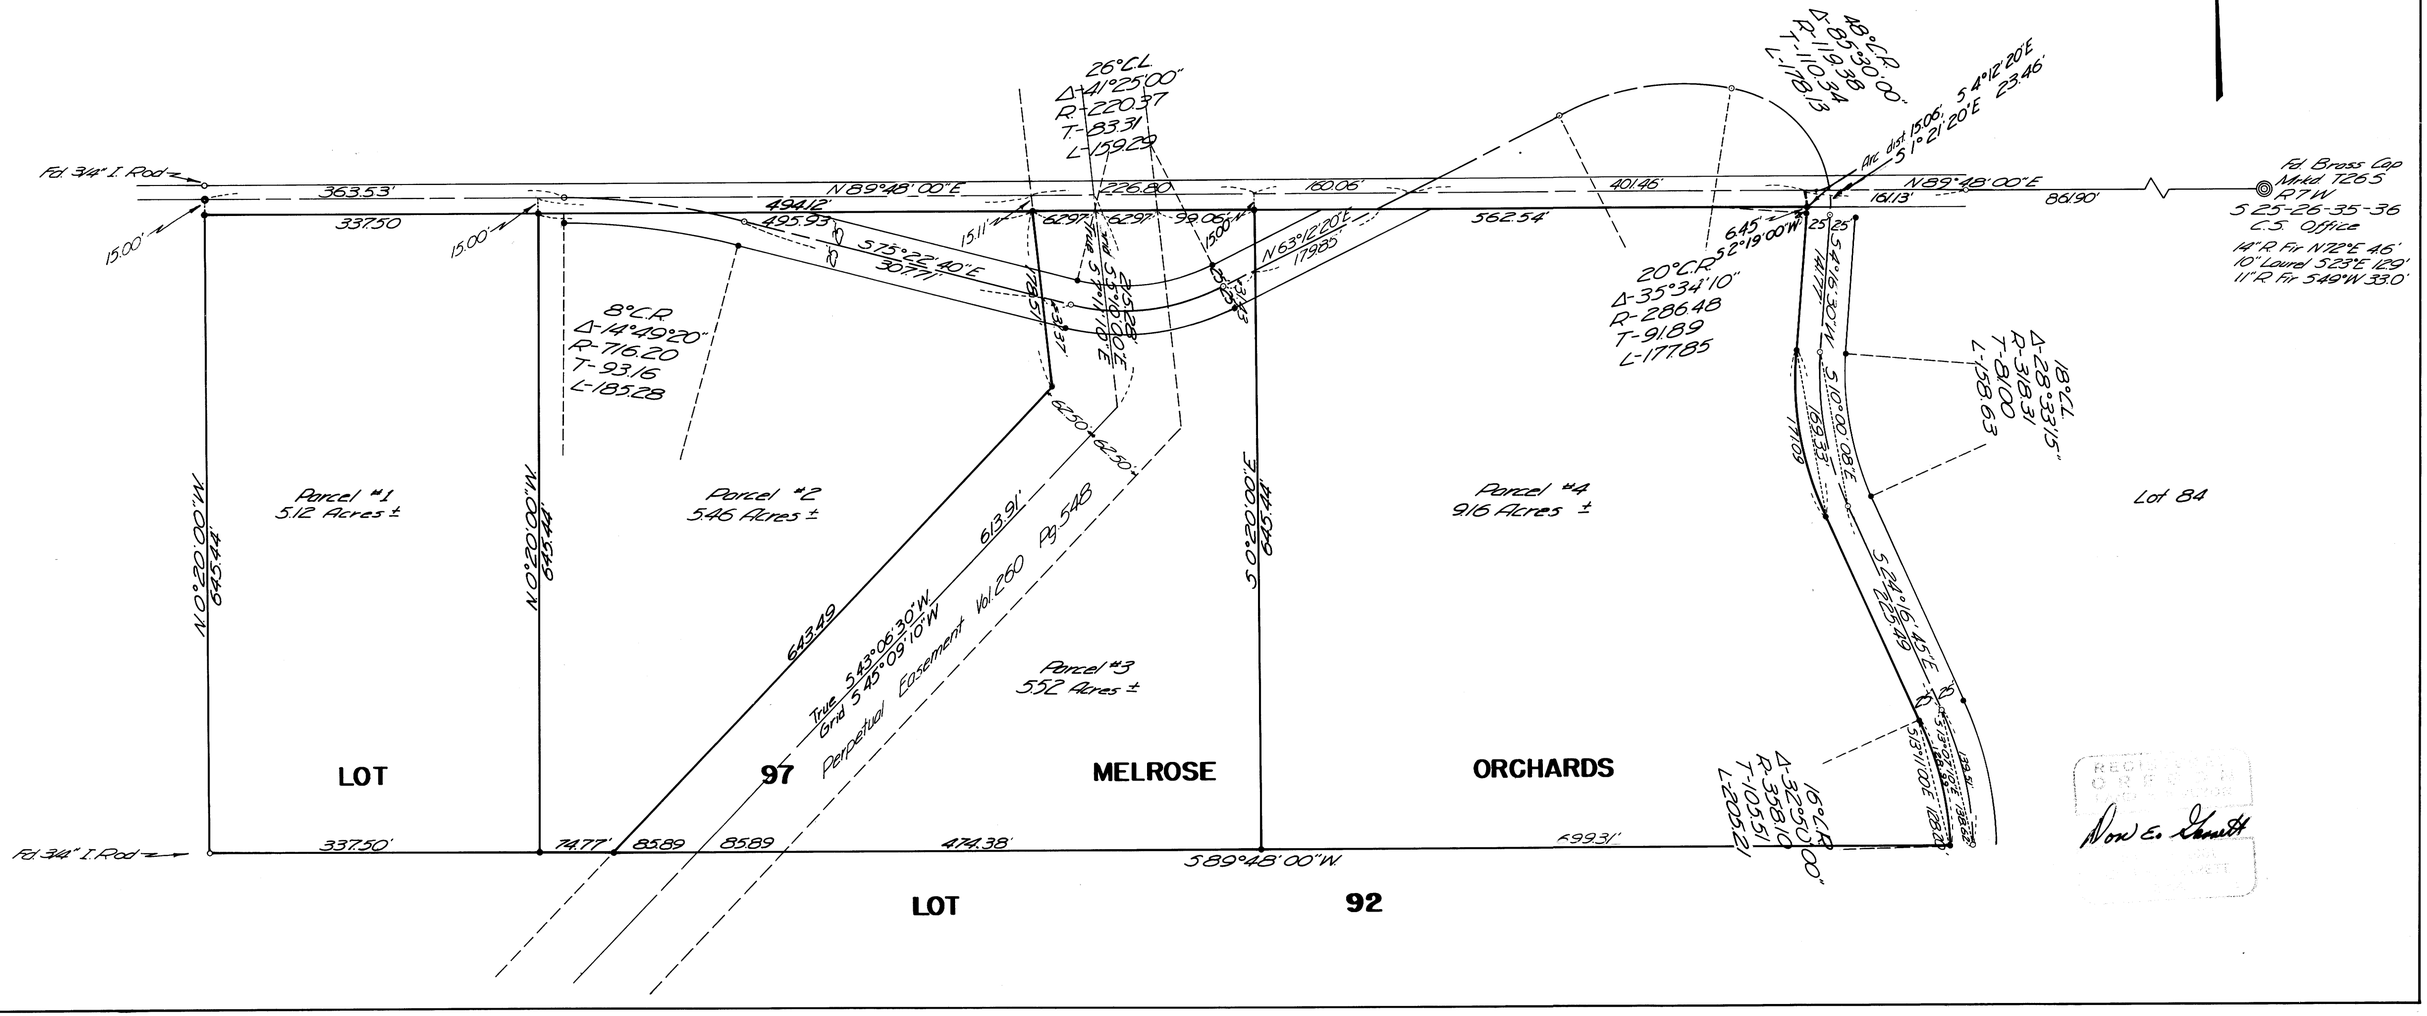

M 29-37