MAP FILE M 29 P 75

COUNTY SURVEYORS FILE DATA
DO NOT REMOVE FROM OFFICE

METES & BOUNDS SURVEY IN SECTION 24, T 27S R 6 W W.M.

SURVEYED FOR MR. JOE JAMES — MAY 8, 1965
SURVEYED BY DON E. GARRETT — SCALE 1" = 50'

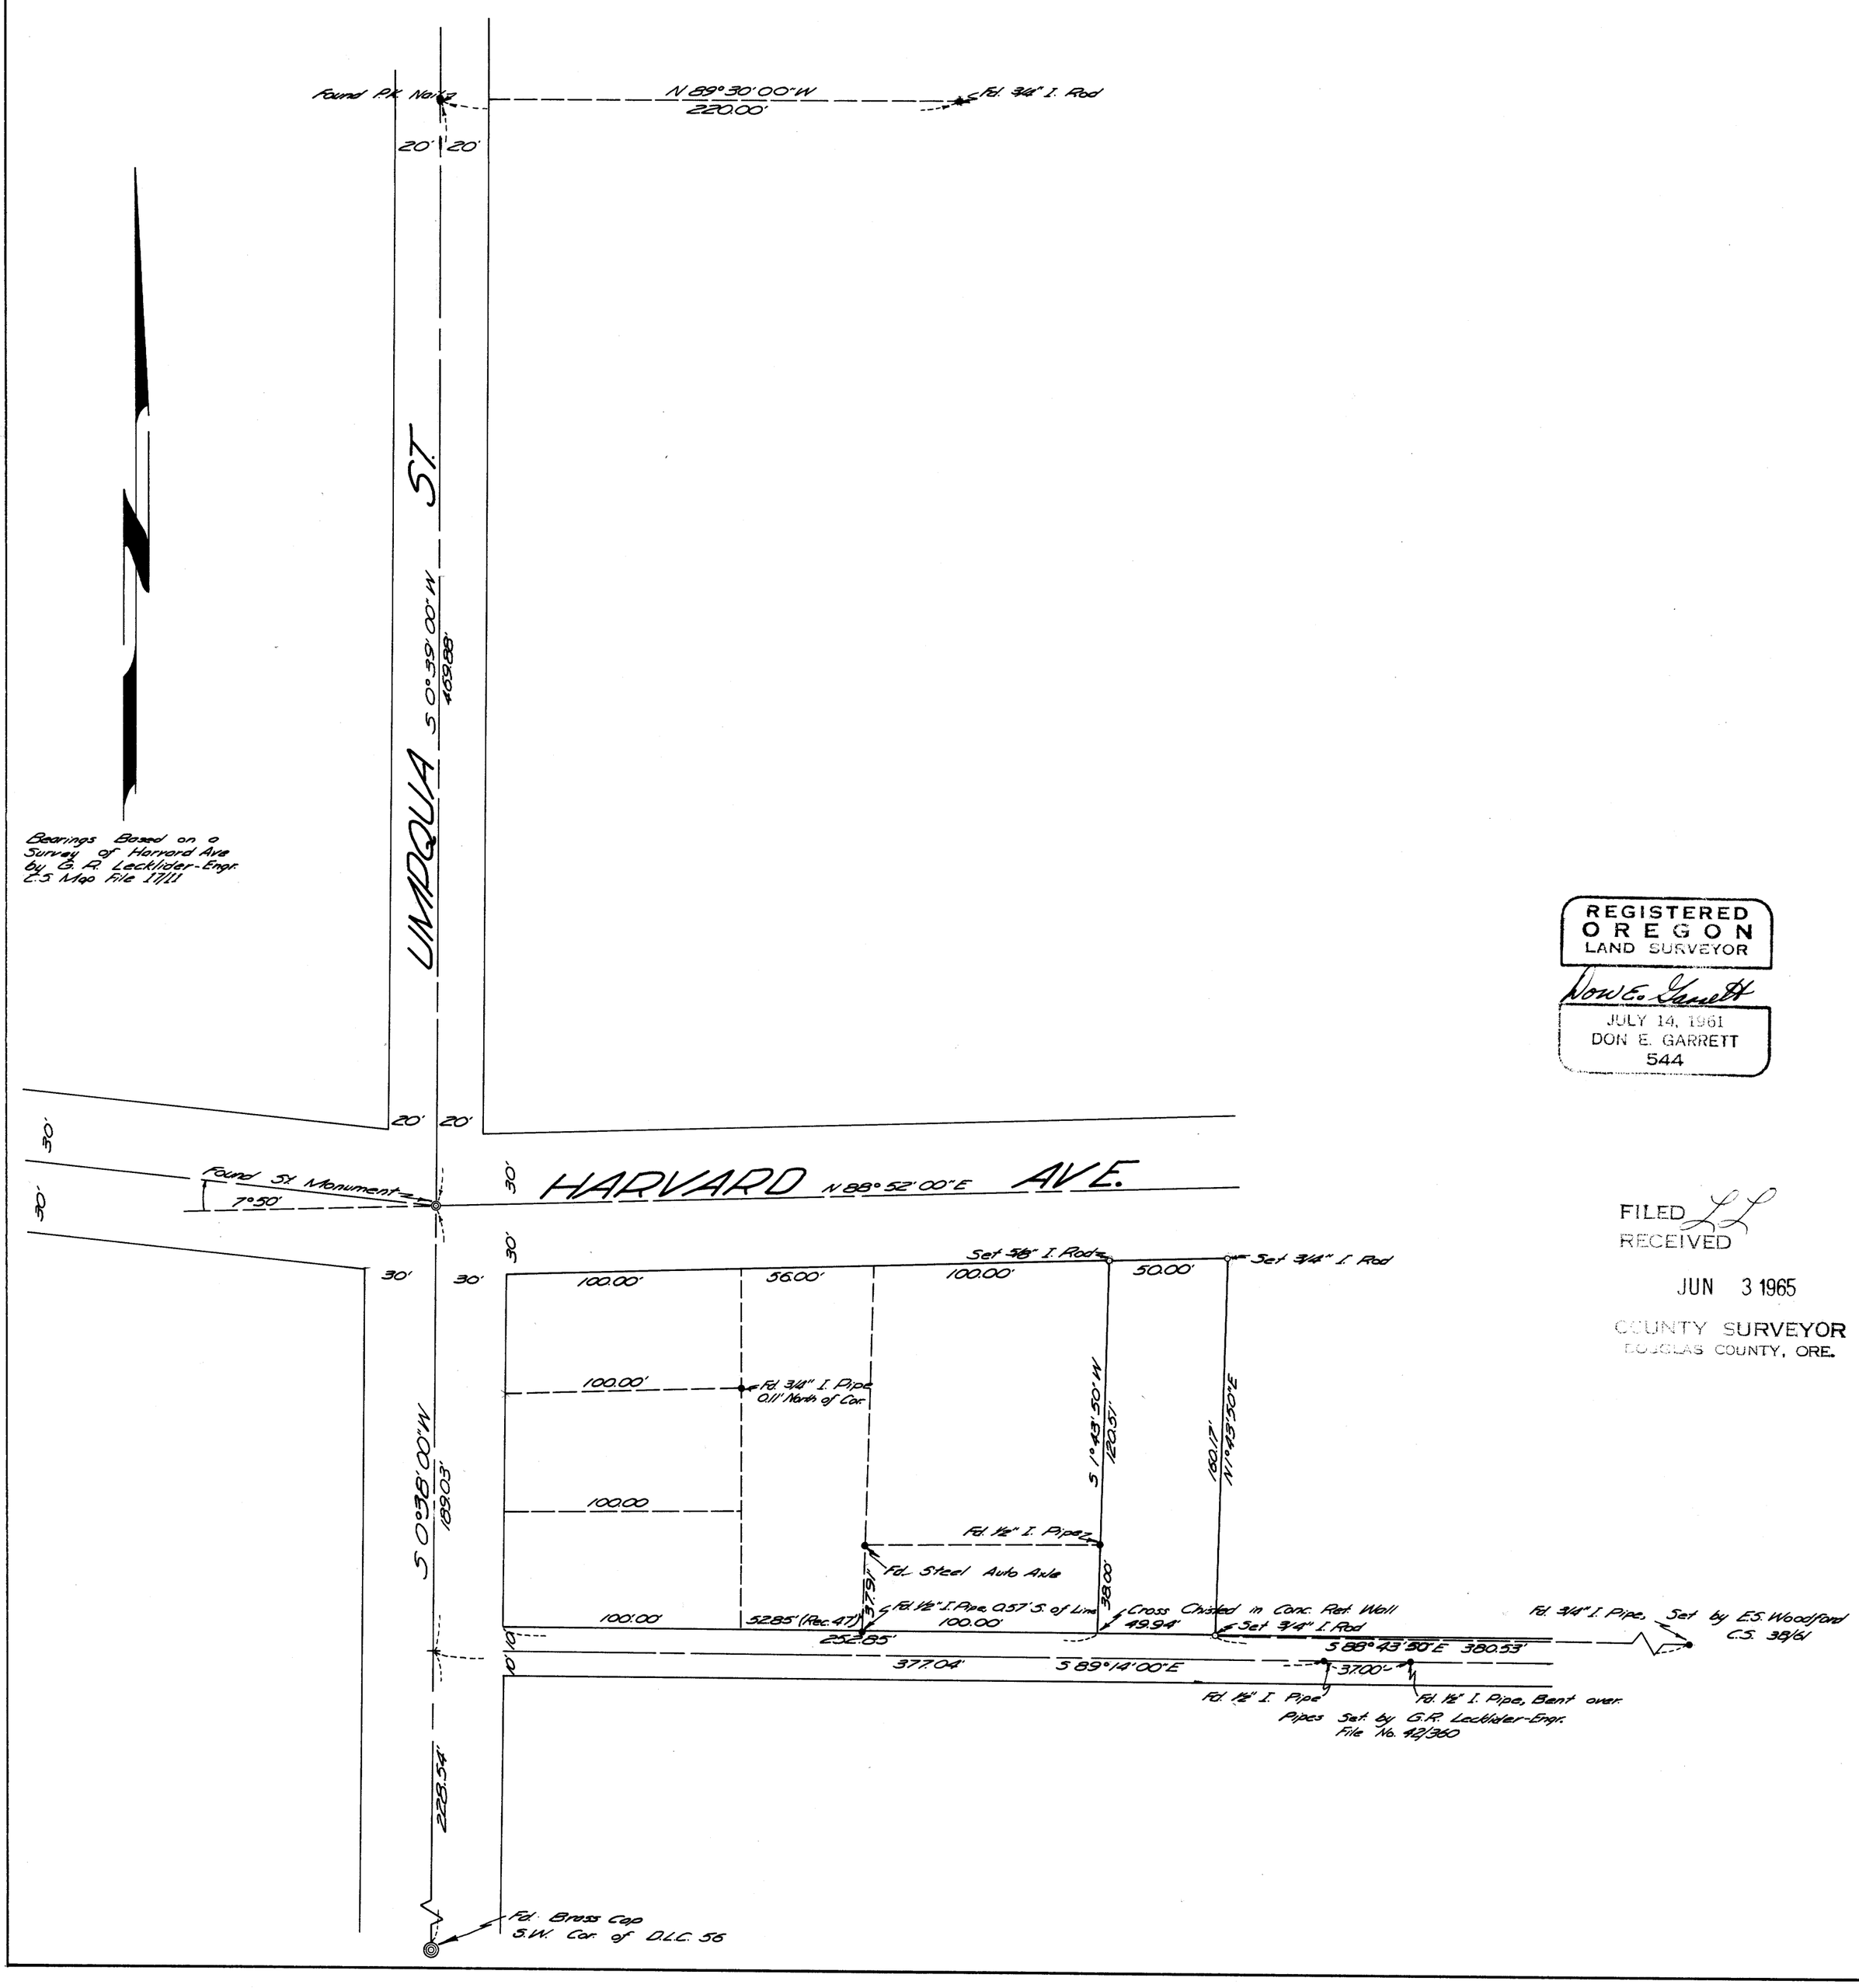

MAP FILE M 29 P 75