S.E. 1/4 S.W. 1/4 S24 T26S R7W W.M.

SURVEYED FOR ROY NELSON JUNE 5, 1965
SURVEYED BY DONALD E. GARRETT
BEARINGS BASED ON EAST LINE OF CO. RD. 59, M26-39
•-DENOTES SET 5/8" IRON ROD
∘-DENOTES FOUND 3/4" IRON ROD
SCALE 1"=100'

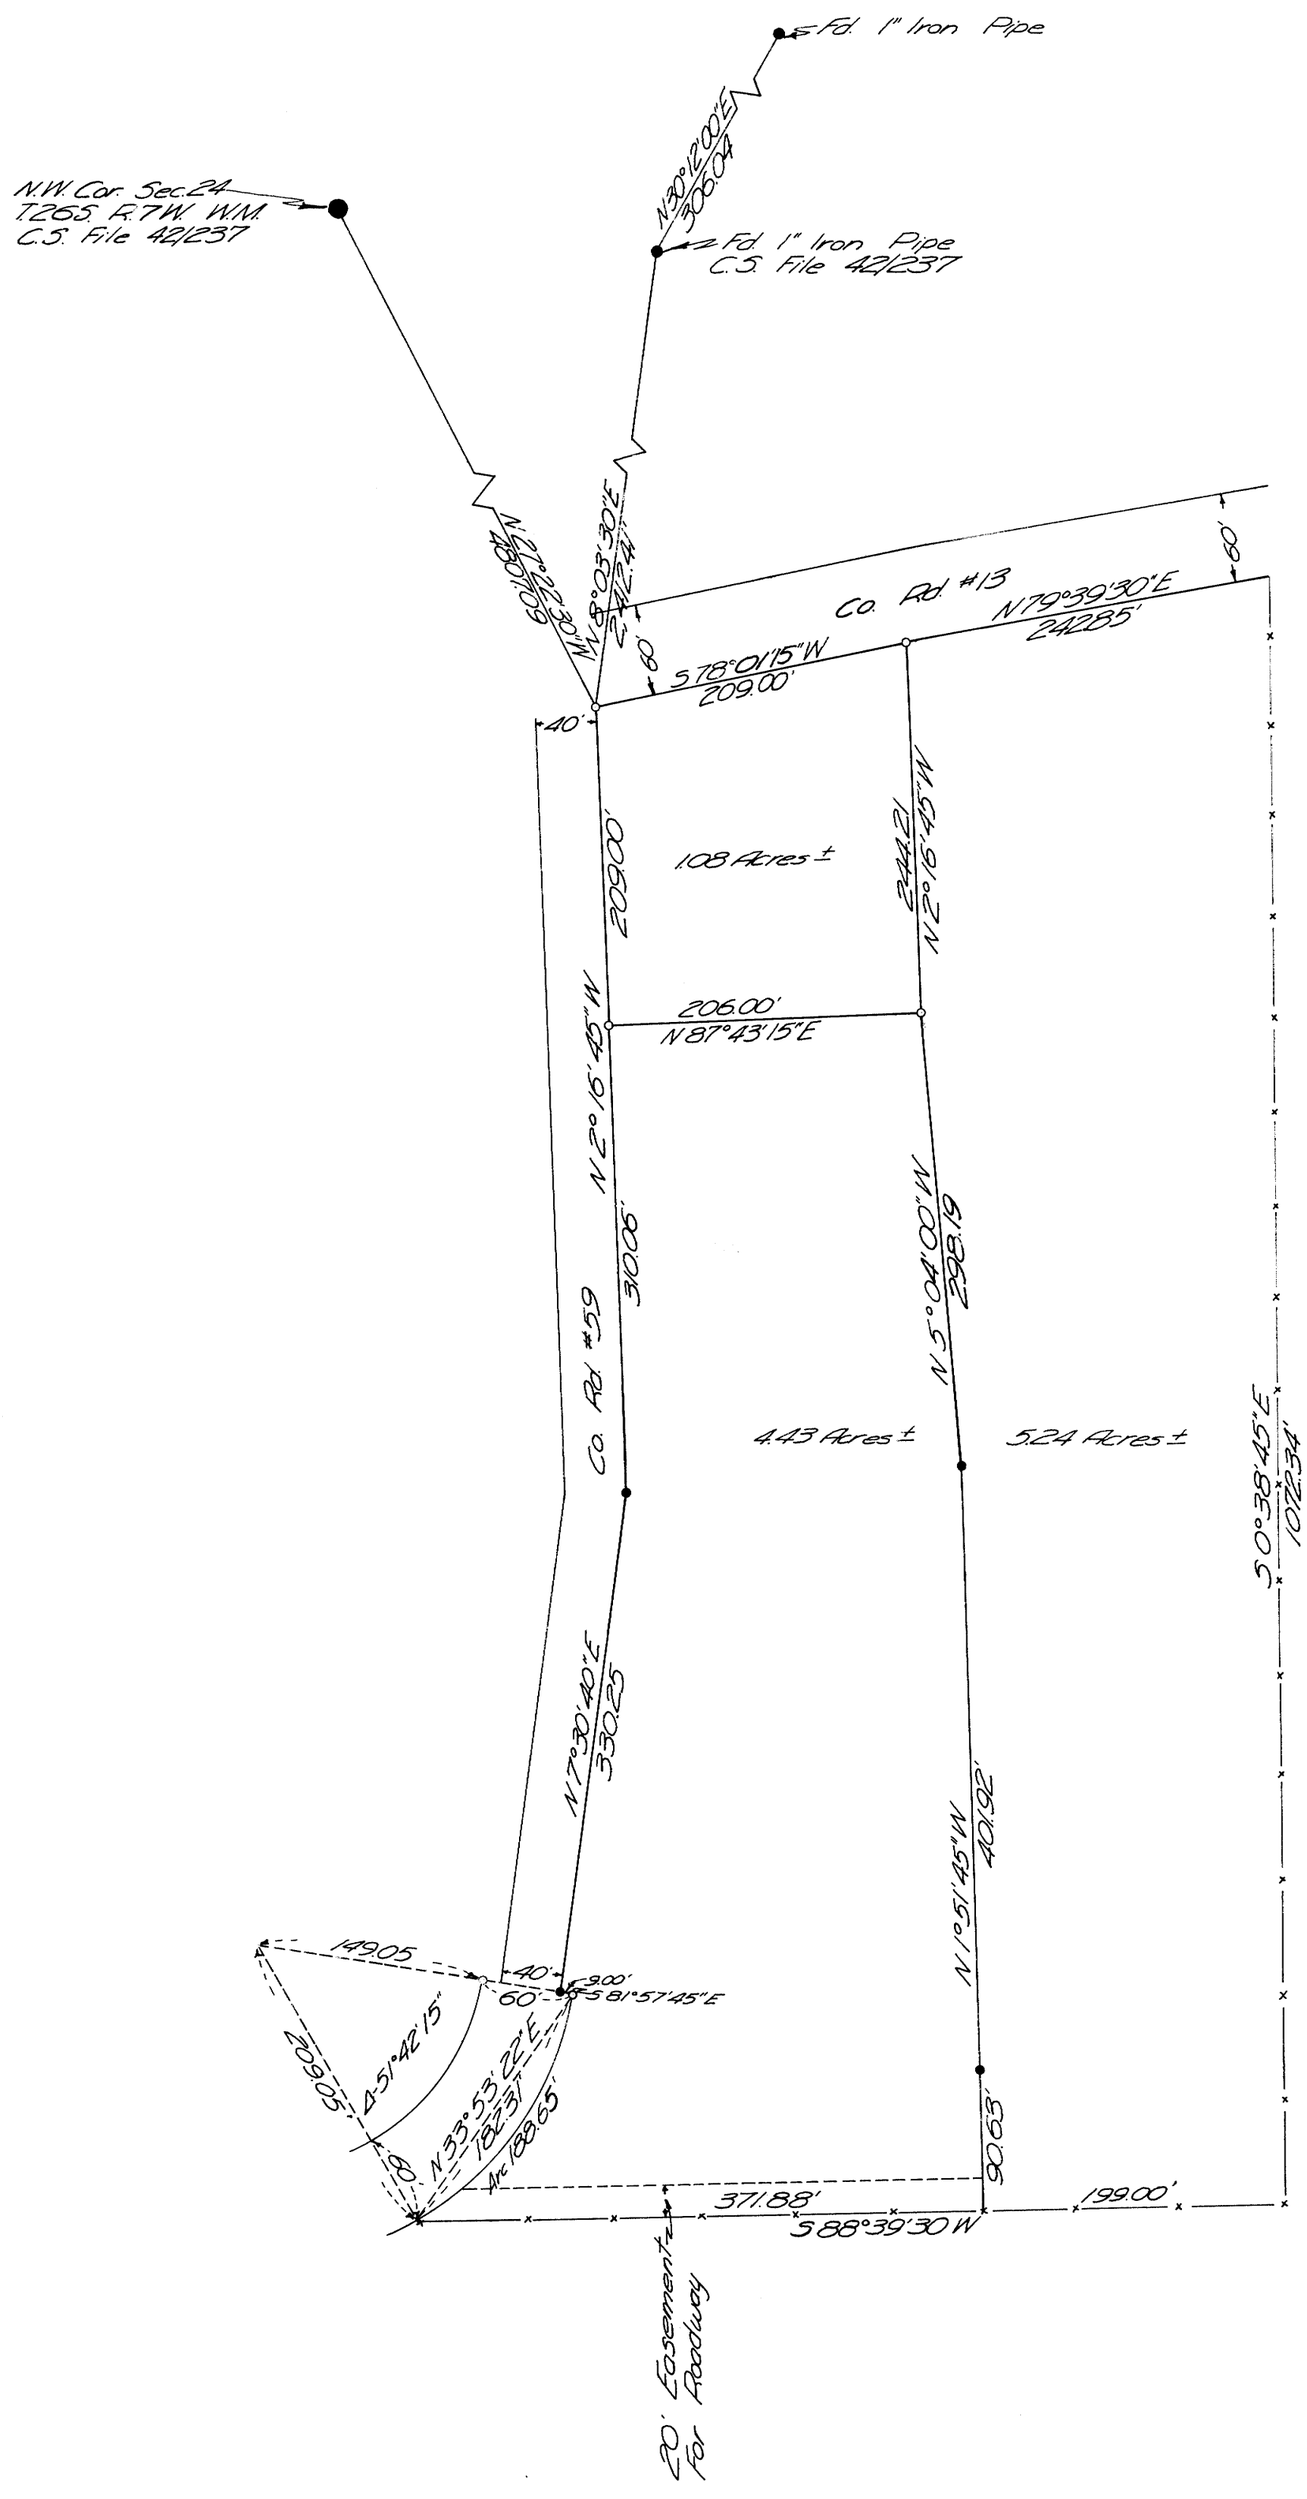

Note: Due to the prohibitive cost of renewing lost govmnt Cors. in this area, the fences of long standing on the East & South Lines of the property Surveyed were used as the property lines.

REGISTERED
OREGON
LAND SURVEYOR
Don E. Garrett
JULY 14, 1961
DON E. GARRETT
544

FILED
RECEIVED
JUN 1 1965
COUNTY SURVEYOR
DOUGLAS COUNTY, ORE.

FILE M29-77