MAP FILE M30 - 25

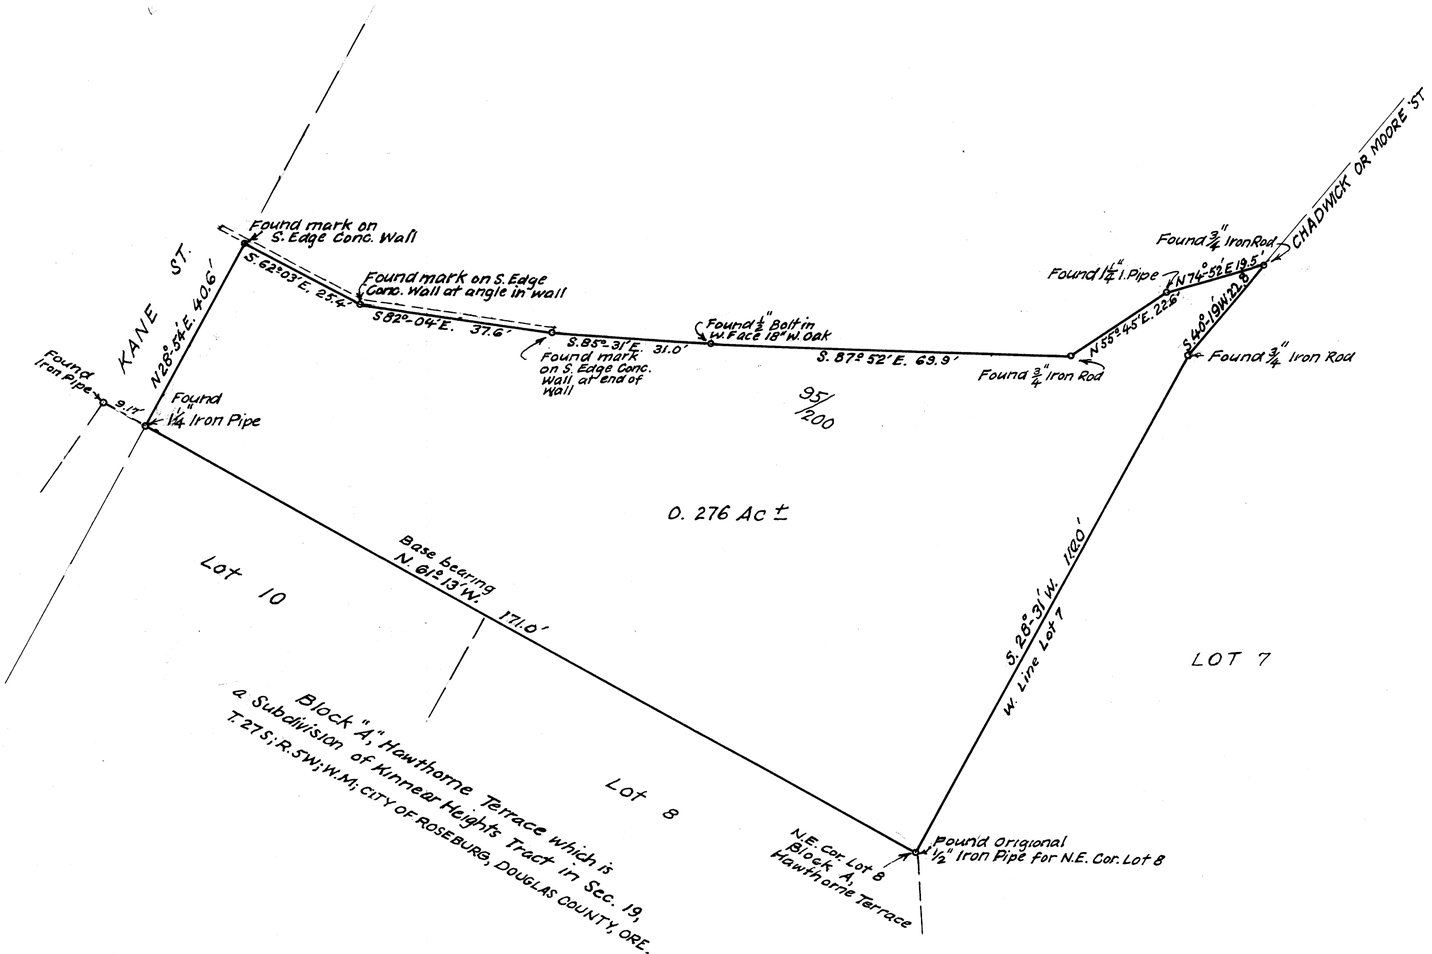

REGISTERED PROFESSIONAL ENGINEER 991 OREGON MAY 5, 1933 ARTHUR BOYER

Arthur Boyer

FILED
RECEIVED
AUG 9 1965
COUNTY SURVEYOR
DOUGLAS COUNTY, ORE.

COUNTY SURVEYORS FILE DATA
DO NOT REMOVE FROM OFFICE

MRS HILDA WADE TO
CARL R. DUNCAN & EUNICE P. DUNCAN
METES & BOUNDS DESCRIBED PROPERTY
ON E. SIDE KANE ST & ON NORTH SIDE OF
HAWTHORNE TERRACE IN
CITY OF ROSEBURG, DOUGLAS COUNTY, ORE.
PORTION OF PROPERTY DESCRIBED IN VOL. 95, PG 200 DEEDS.
DESCRIBED
DEC. 1956 Arthur Boyer 1" = 20'

MAP FILE M30 - 25