FILED
RECEIVED
AUG 16 1965
COUNTY SURVEYOR
DOUGLAS COUNTY, ORE.

COUNTY SURVEYORS FILE
DO NOT REMOVE FROM OFFICE

SURVEY FOR DEED DESCRIPTION

SECT. 24, Lot #2 T.24S., R.7W. W.M.

For

T. J. Cooney

Oakland, Oregon

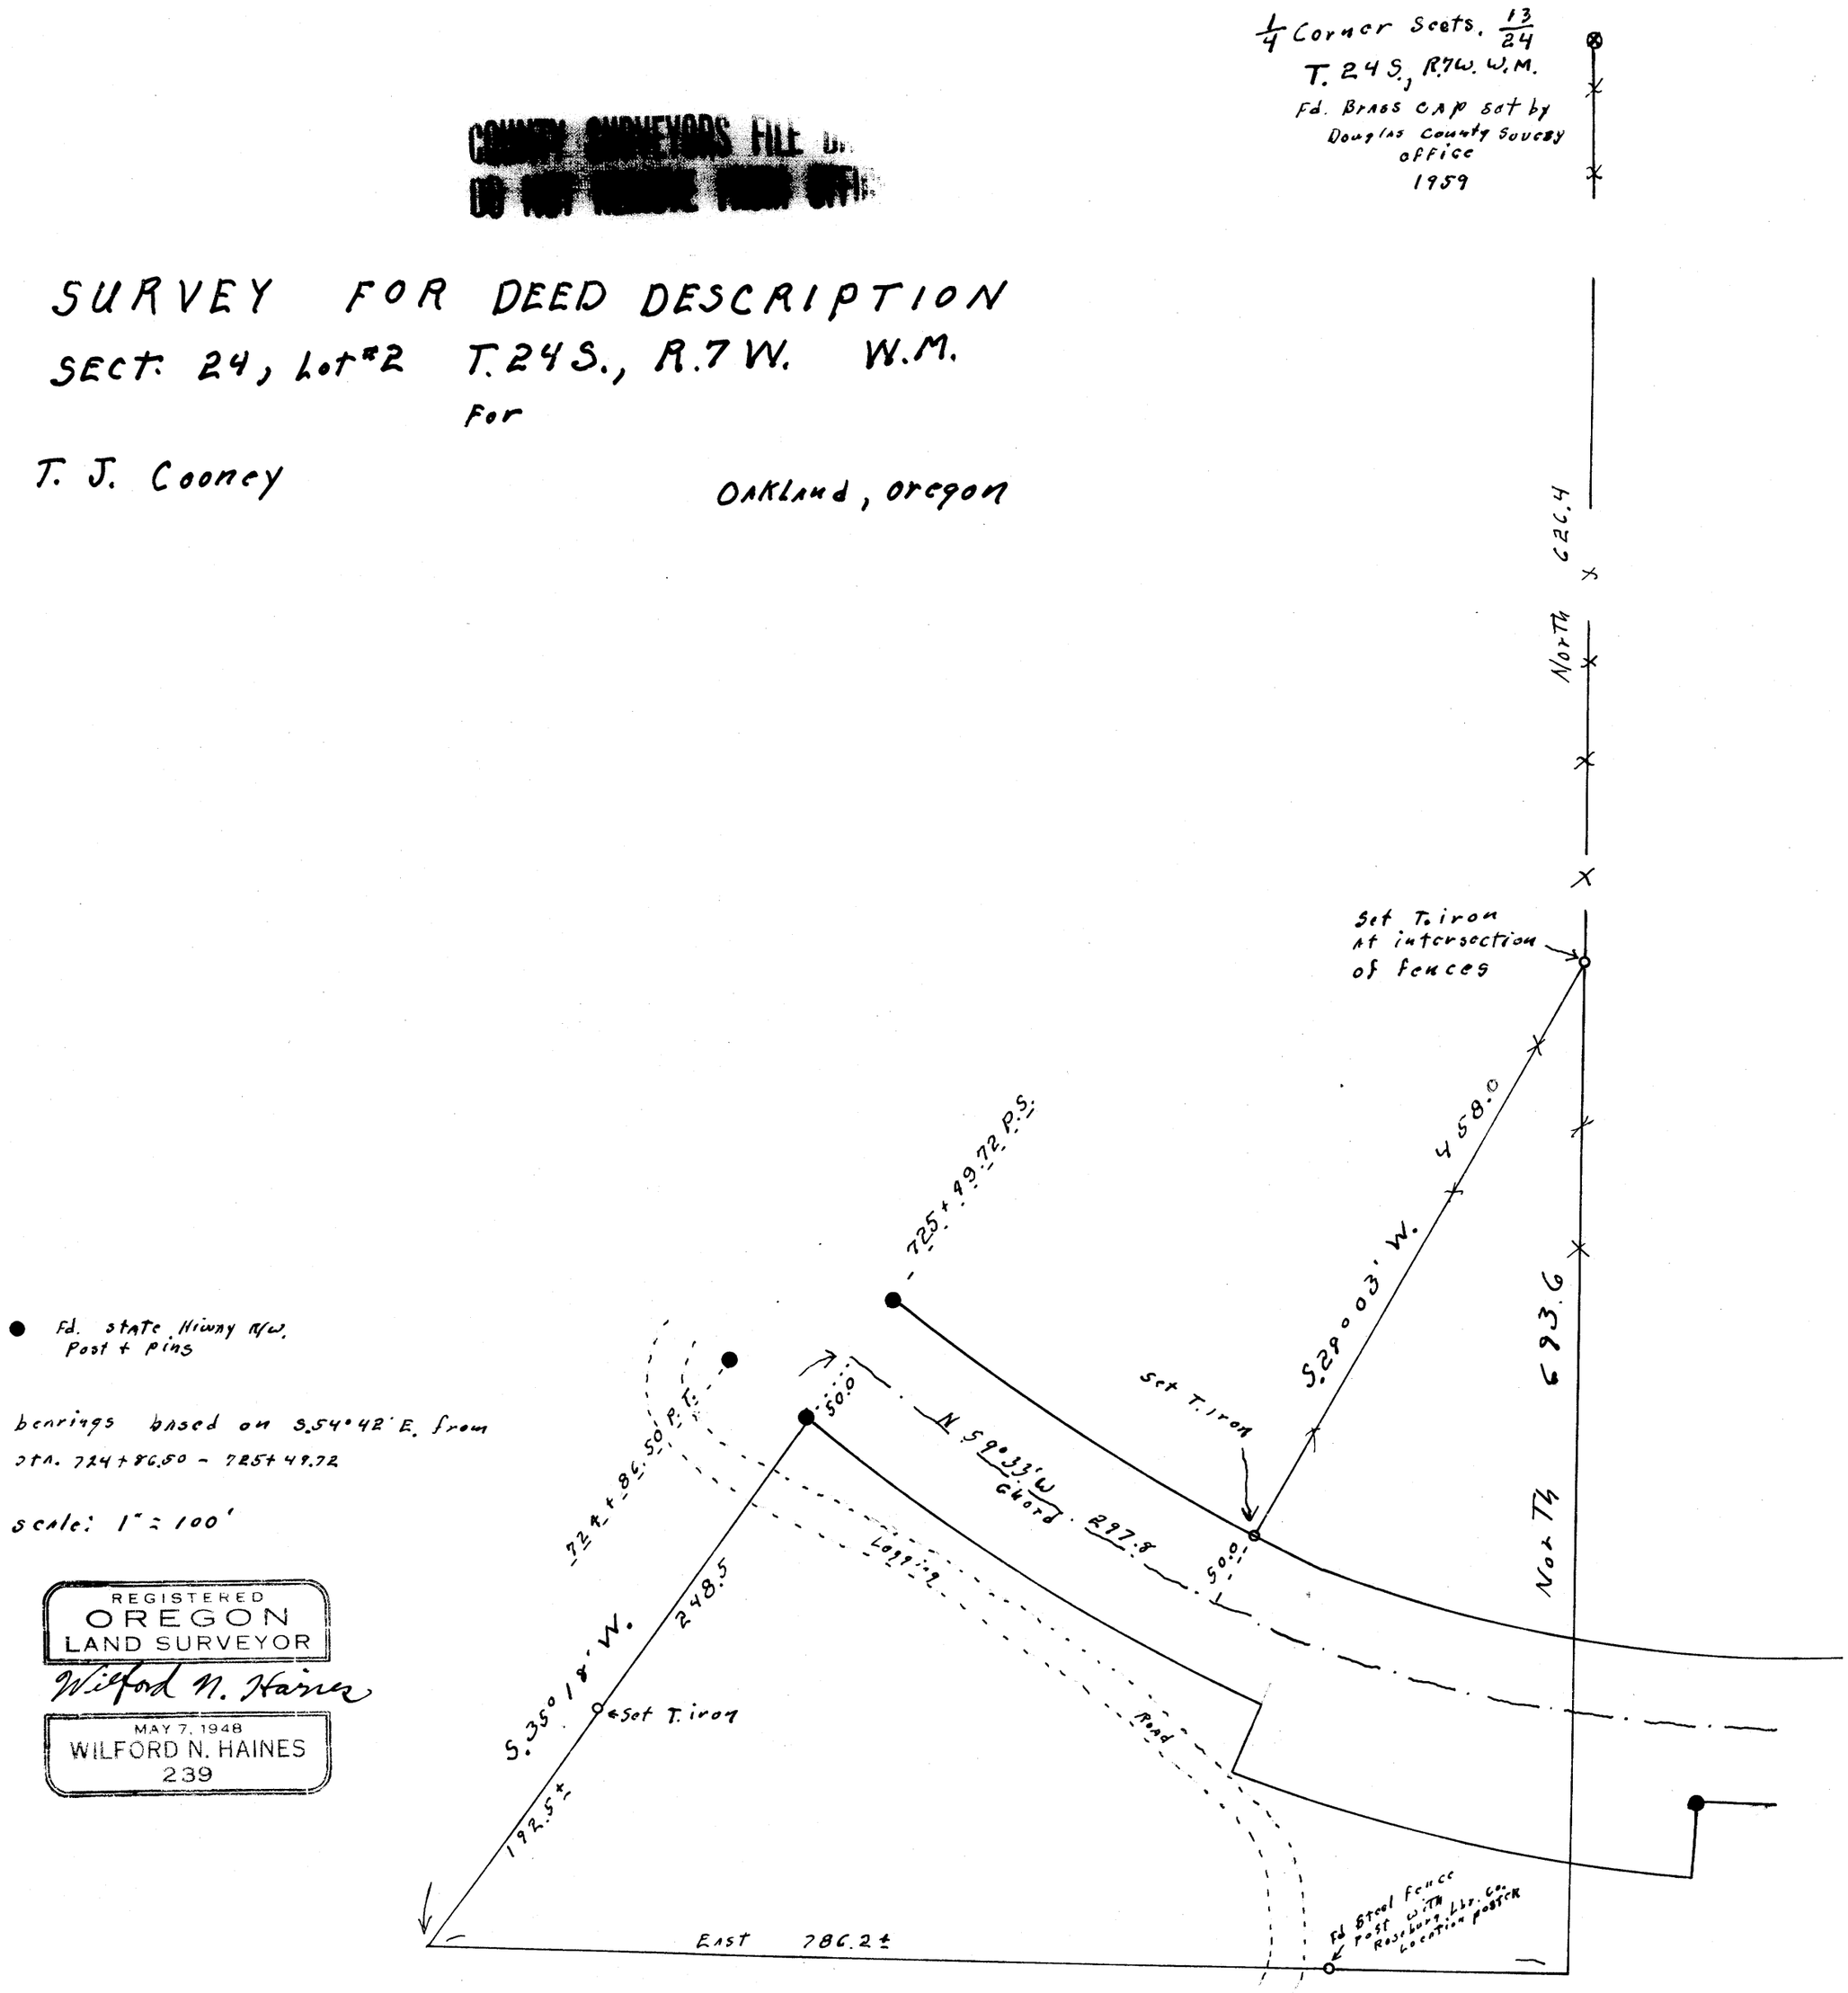

● Fd. state Hiwy R/W. Post + pins

bearings based on S.54°42' E. from sta. 724+86.50 - 725+49.72

scale: 1" = 100'

REGISTERED
OREGON
LAND SURVEYOR
Wilford N. Haines
MAY 7, 1948
WILFORD N. HAINES
239

M30 - 31